


Plat of the Proposed Location of Well No. 2 of the Browns Run Gas Company, of Hundred, West Va., on the Paul Oates Farm. Consisting of 79.17 Acres Located in Clay District, Wetzel County, West Va.

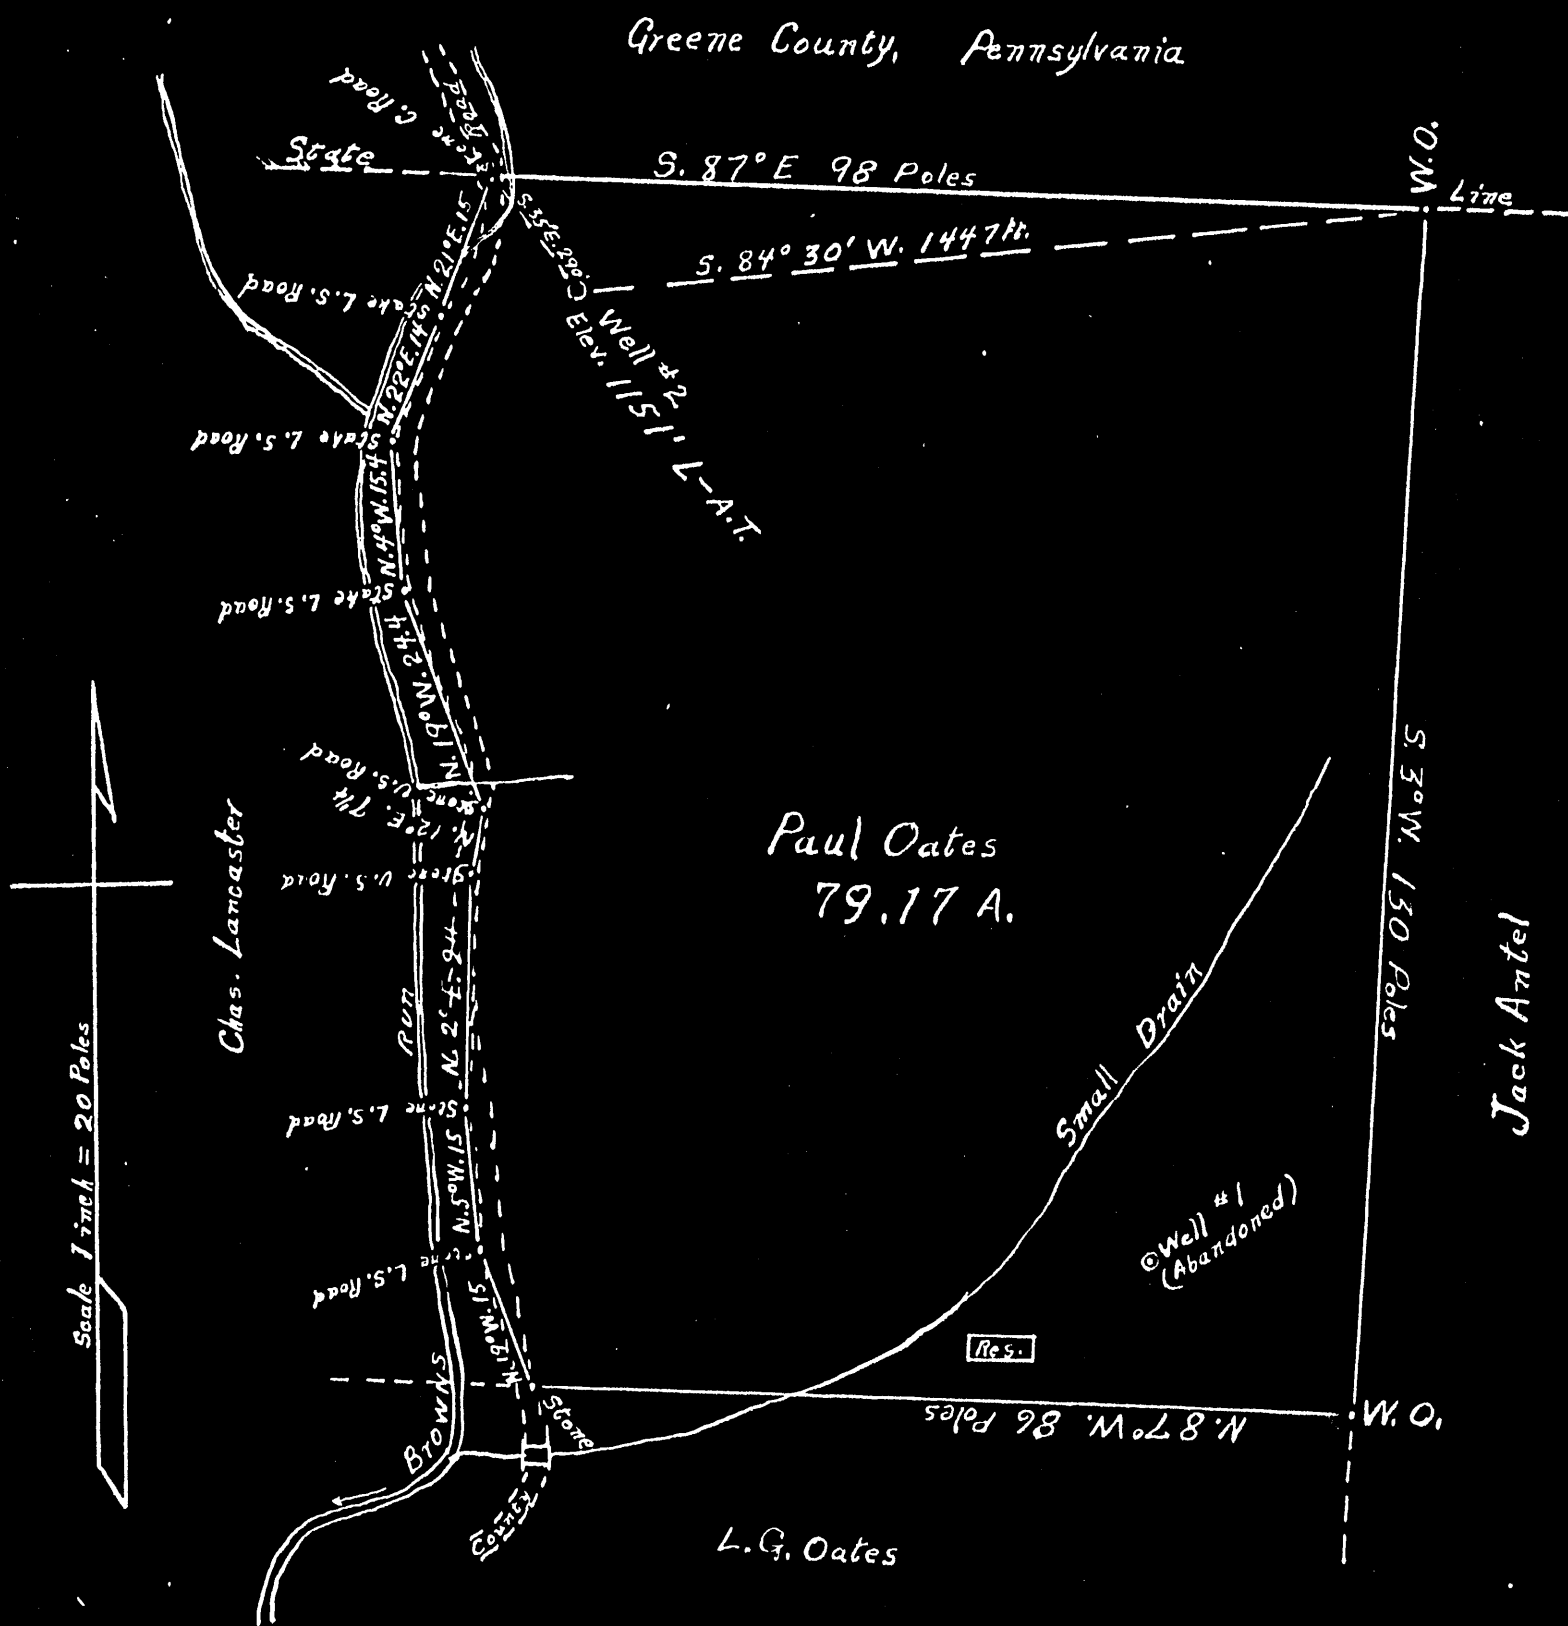

I, the under-signed, hereby certify that this map is correct and shows all the information, to the best of my knowledge and belief, required by the Oil and Gas Section of the mining Laws of West Virginia.

Carl N. Robinson, Engineer

Acknowledged before me, a Notary Public of Wetzel County, West Virginia, this the 22 day of September, 1933.

My Commission expires Jan 14, 1940.

Glenn A Hunt
Notary Public


Wet-74

LATITUDE

39° 45'

88 27 30"

LONGITUDE

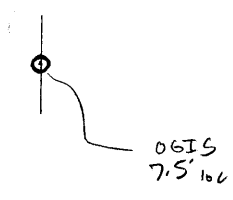

7.5 OGIS topo location

7.5' loc	<u>2.02 S</u>	15' loc	<u>2.02 S</u>
	<u>0.95 W</u>	(calc.)	<u>2.17 W</u>

Company _____

Farm _____

Quad Hundred 7.5' Monington NW

County Wetzel

District Clay

WELL LOCATION MAP

File No. 103-74

no well record

?

(049)

DRILLER'S RECORD

Previously Requested, but NOT
AVAILABLE

DATE: 3-2-92

<u>103</u> COUNTY	<u>74</u> PERMIT
----------------------	---------------------