



West Virginia Department of Environmental Protection
Office of Oil and Gas
WELL LOCATION FORM: GPS

API: 103-01606P WELL NO.: #104

FARM NAME: John Mills

RESPONSIBLE PARTY NAME: Pennzoil-Quaker State Company

COUNTY: Wetzel DISTRICT: Grant

QUADRANGLE: Pine Grove 7.5

SURFACE OWNER: ~~Lewis-Wetzel-Wildlife-Hunt-Area~~ Wheeling Jesuit

ROYALTY OWNER: _____

UTM GPS NORTHING: 4,374,513

UTM GPS EASTING: 530,099 GPS ELEVATION: 277.1

*Wheeling Jesuit
216 Union Ave
Wheeling WV 26002
at Larry Skrzynecki's*

The Responsible Party named above has chosen to submit GPS coordinates in lieu of preparing a new well location plat for a plugging permit on the above well. The Office of Oil and Gas will not accept GPS coordinates that do not meet the following requirements:

1. Datum: NAD 1983, Zone: 17 North, Coordinate Units: meters, Altitude: height above mean sea level (MSL) – meters.
2. Accuracy to Datum – 3.05 meters
3. Data Collection Method:

Survey grade GPS _____ : Post Processed Differential _____
Real-Time Differential _____


Mapping Grade GPS x : Post Processed Differential _____
Real-Time Differential x

I the undersigned, hereby certify this data is correct to the best of my knowledge and belief and shows all the information required by law and the regulations issued and prescribed by the Office of Oil and Gas.

[Signature]
Signature

Professional Surveyor
Title

2-9-05
Date

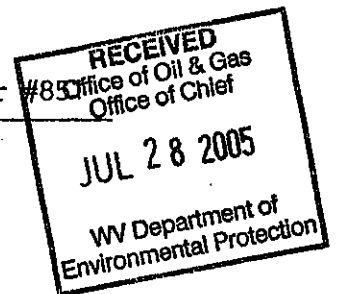

WET 1606 P