


MM

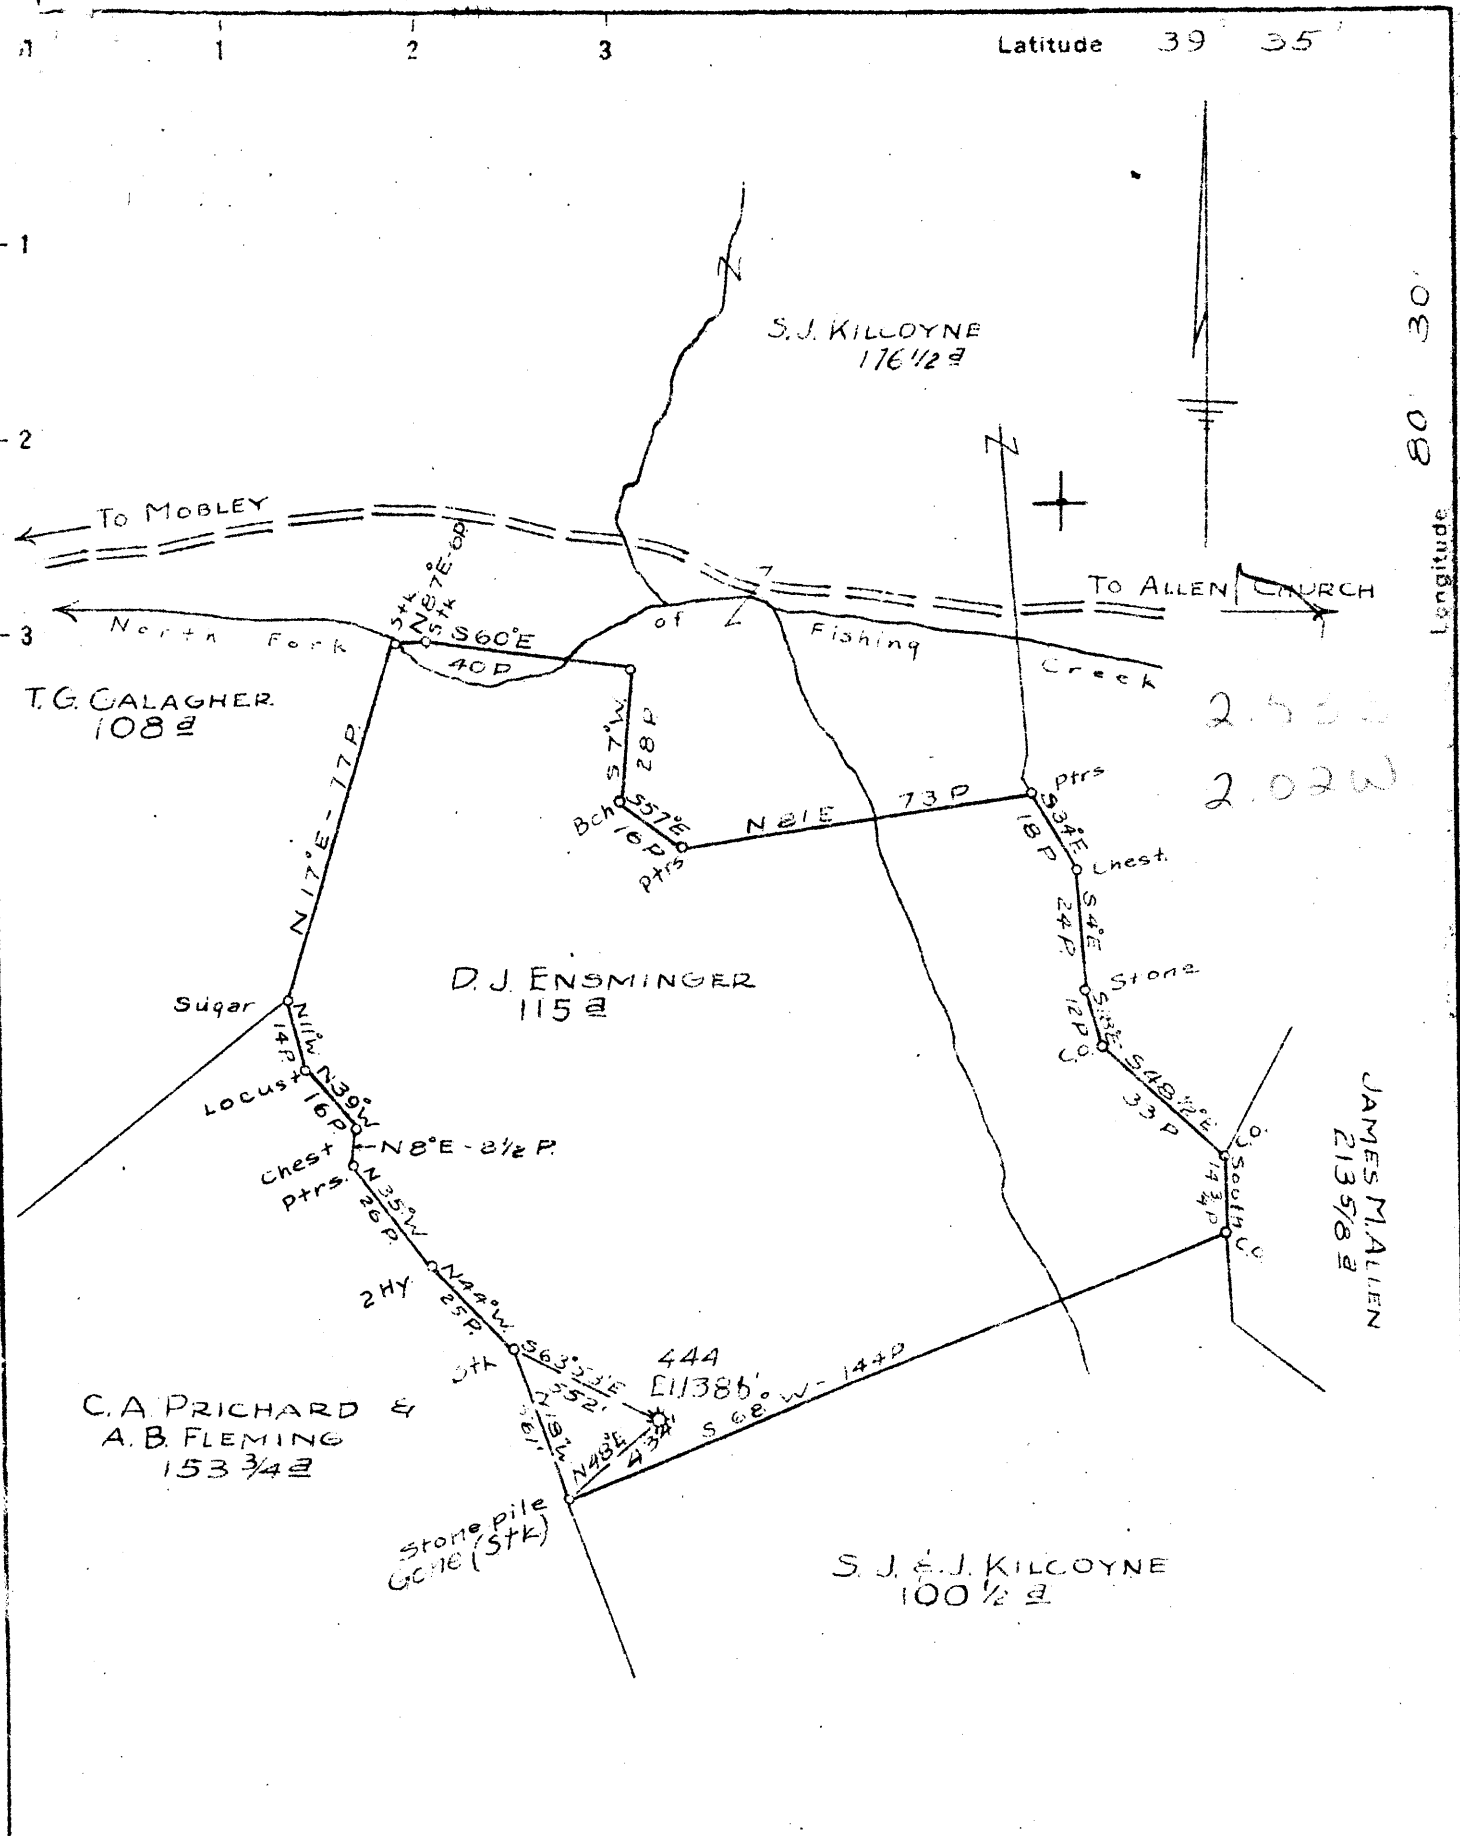

New Location
 Drill Deeper
 Abandonment

MAP SHEET 32 S₄ N 7, E 5, FB. 854 P 36

Company HOPE NATURAL GAS CO.
 Address CLARKSBURG, W. VA.
 Farm D. J. ENSMINGER
 Tract _____ Acres 115 Lease No. 4040
 Well (Farm) No. _____ Serial No. 444
 Elevation (Spirit Level) 1386'
 Quadrangle LITTLETON
 County WETZEL District GRANT
 Engineer Wm Bowers
 Engineer's Registration No. 900
 File No. _____ Drawing No. _____
 Date 4-29-47 Scale 1" = 40 POLES

STATE OF WEST VIRGINIA
 DEPARTMENT OF MINES
 OIL AND GAS DIVISION
 CHARLESTON

WELL LOCATION MAP
 FILE NO. WET-338-D.

+ Denotes location of well on United States Topographic Maps, scale 1 to 62,500, latitude and longitude lines being represented by border lines as shown.

- Denotes one inch spaces on border line of original tracing.

6-6 45

WEST VIRGINIA DEPARTMENT OF MINES
OIL & GAS DIVISION
W E L L R E C O R D

Permit No. Wet 338 R
Littleton Quad.

Gas Well
CASING & TUBING

Company	Hope Natural Gas Company			
Address	445 West Main St., Clarksburg, W.Va.			
Farm	D.J. Ensminger Acres 115			
Location			8 $\frac{1}{4}$	1580 1580
Well No.	444	Elev. 1386	6 5/8	2090 2090
District	Grant	Wetzel County	5 3/16	2555 2555
Surface			2	3381 3381
Mineral				
Commenced Deeper	Sept. 5, 1947		Casing not cemented	
Completed	Marc. 5, 1948			
Not shot			No coal	
Volume	33	MCF		
Rock Pressure				
No water recorded				

DRILLED DEEPER

Commenced drilling		2490
Big Injun		2617
Gantz	2923	2935
Lime	2954	3095
✓Thirty Foot	3146	3153
Red Rock	3153	3159
✓Gordon Stray	3159	3194
✓Gordon	3228	3242
Slate	3242	3253
✓Fourth	3253	3270
Total Depth		3381
Show gas 3234		
Gas 3254		