


Latitude 39 35' 33"

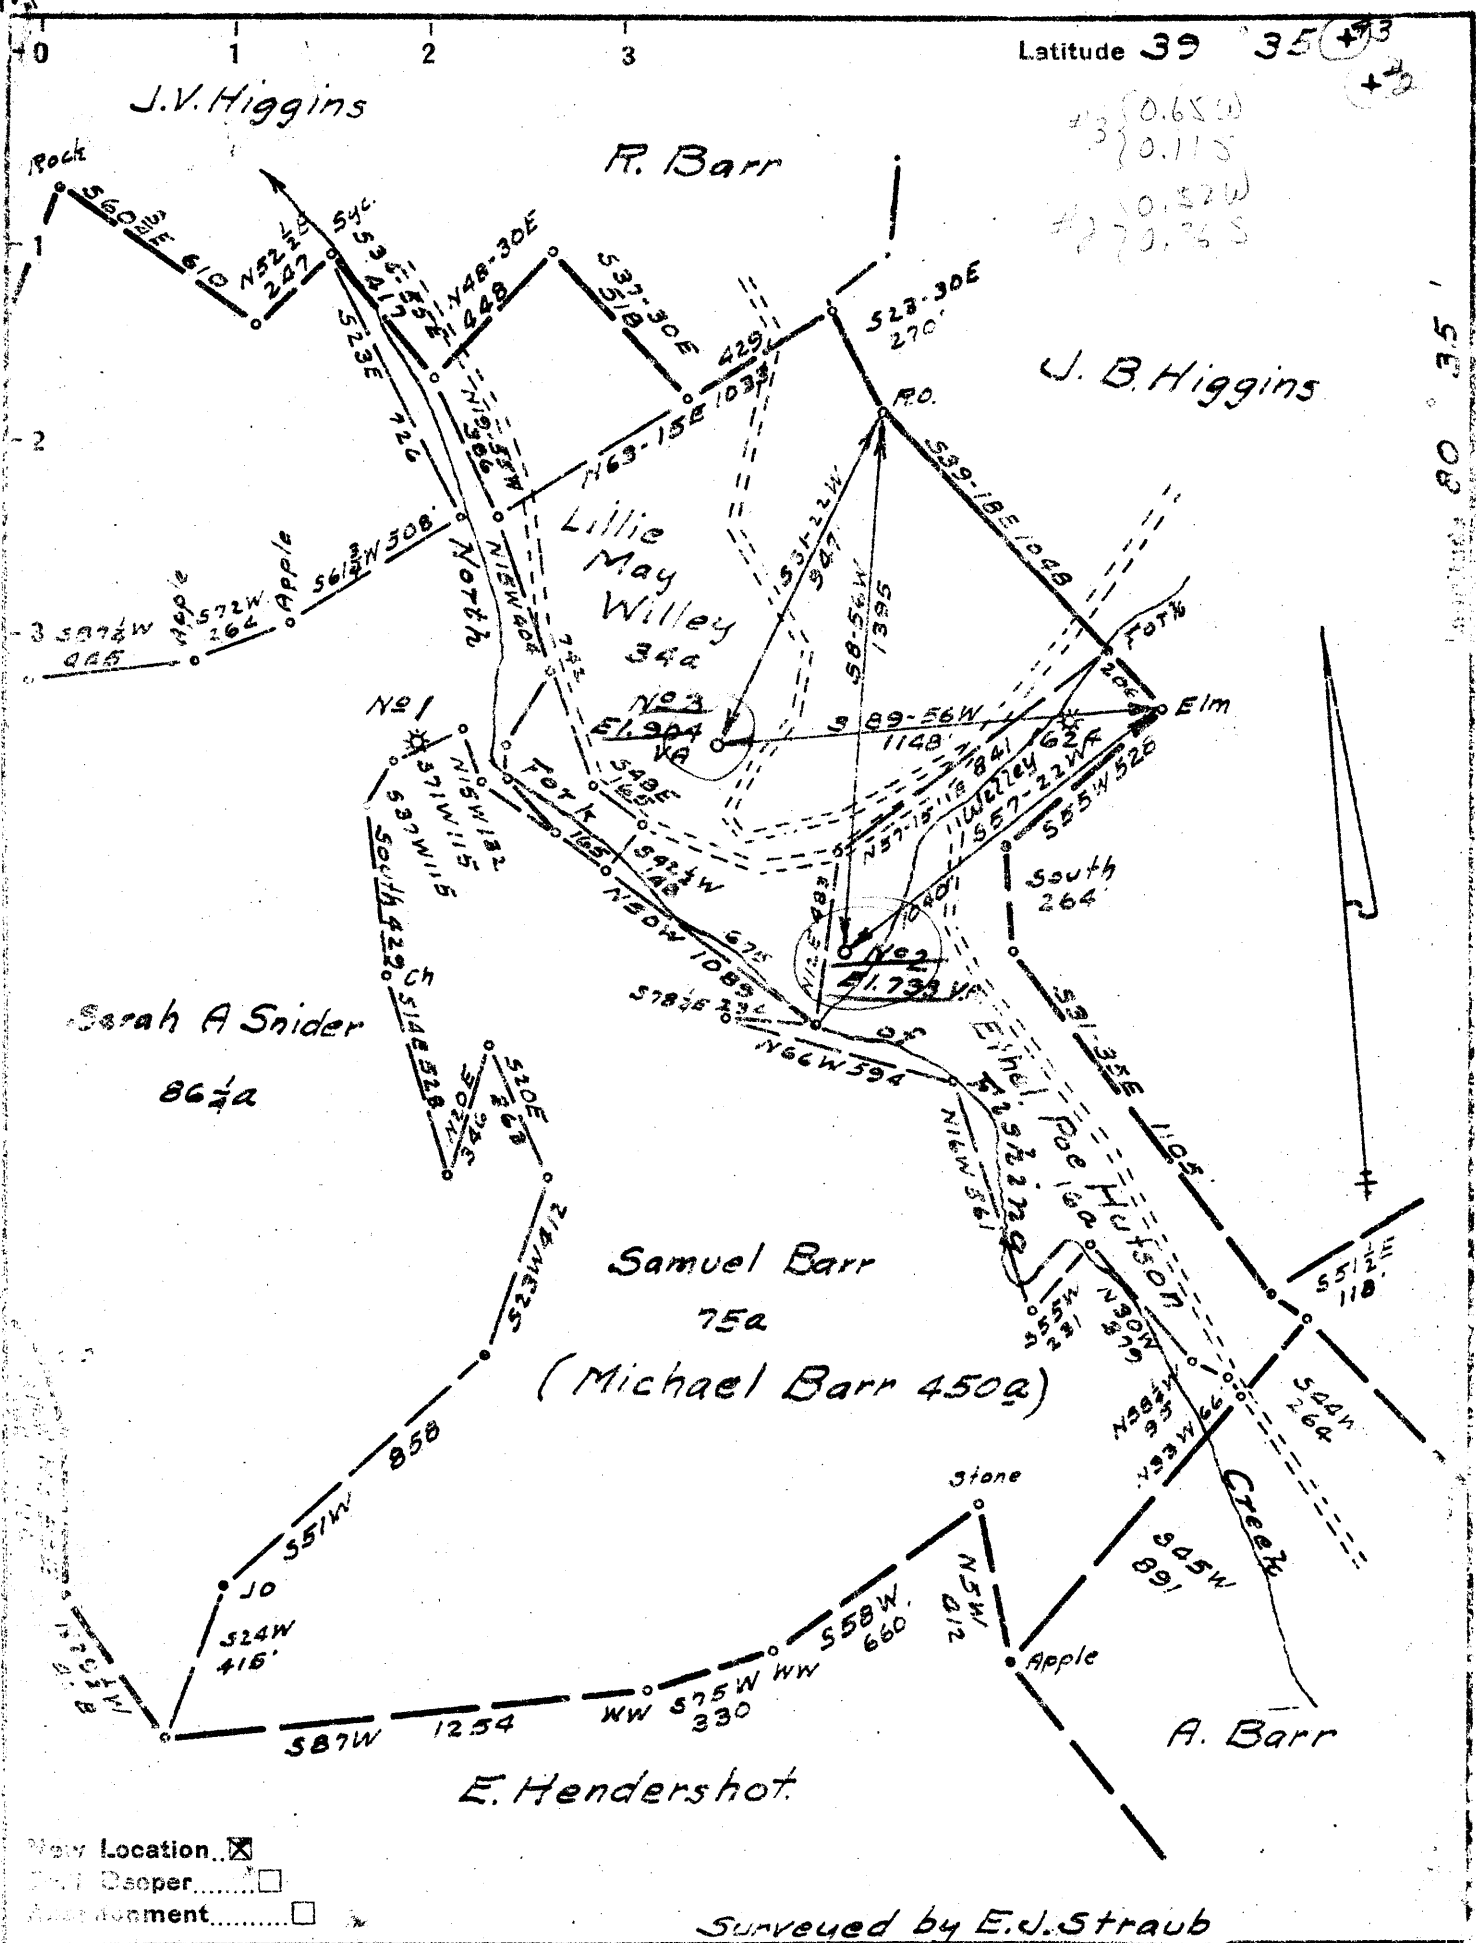

- New Location
- Old Cseper
- Abandonment

Surveyed by E.J. Straub

Company Louis F. Silhol et al  
 Address Pittsburgh Pa.  
 Farm Michael Barr et al  
 Tract \_\_\_\_\_ Acres 450 Lease No. 2876  
 Well (Farm) No. 243 Serial No. \_\_\_\_\_  
 Elevation (Spirit Level) As Shown  
 Quadrangle Littleton SE 13-4  
 County Wetzel District Grant  
 Engineer James D. Jeffries  
 Engineer's Registration No. 1084  
 File No. \_\_\_\_\_ Drawing No. \_\_\_\_\_  
 Date 6-27-49 Scale 1"=500'

STATE OF WEST VIRGINIA  
 DEPARTMENT OF MINES  
 OIL AND GAS DIVISION  
 CHARLESTON

WELL LOCATION MAP  
 FILE NO. Wet-356-#2  
Wet-357-#3

- + Denotes location of well on United States Topographic Maps, scale 1 to 62,500, latitude and longitude lines being represented by border lines as shown.
- Denotes one inch spaces on border line of original tracing.



WEST VIRGINIA DEPARTMENT OF MINES  
OIL & GAS DIVISION  
W E L L R E C O R D

Permit No. Wet <sup>357</sup> 356		Gas Well
Littleton Quad.		CASING & TUBING
Company	Louis F. Silhol et al	
Address	316 Akron Ave., Pittsburgh, 16, Pa.	8 1/2    173    173
Farm	Virgil & Lillian Willey    A	6 5/8    407    407
Location	Fishing Creek	2 tbg.    636    636
Well No.	3 <del>2</del> Elev. 904	
District	Grant    Wetzel County	
Surface	Virgil and Lillian Willey, Pine Grove, W.Va.	
Mineral	Imperial Oil & Gas Products Co. Pittsburgh, Pa.	Anchor Packer Size 2 x 6 5/8
Commenced	Aug. 29, 1949	
Completed	Sept. 3, 1949	
Open flow	7/10ths W (Mapletown Coal) 3/8" 23/10ths W (Pgh. Coal) 1" <sup>50 mcf</sup>	Perf. top Pgh. Coal Coal at 492' to 494'
Water	120'; 300 gal. per hr. at 240'	605' to 615'

Clay	0	20
Rock	20	25
Slate	25	45
Red Rock	45	60
Lime & Slate	60	100
Lime	100	118
Sand	118	125
Slate	125	142
Lime & Slate	142	175
Gritty Lime	175	182
Lime & Slate	182	230
Sand	230	245
Lime & Slate	245	268
Lime H	268	296
Red Rock	296	303
Slate	303	314
Red Rock	314	321
Slate & Lime	321	380
Lime	380	484
Slate	484	492
✓ Coal (Mapletown)	492	494
Slate & Lime	494	567
Sand	567	597
Slate	597	605
✓ Coal Pittsburgh	605	615
Lime	615	628
Slate	628	636
Total depth		636
Show gas 213'		
Show gas 492'		

762  
441  
301  
  
755  
303  
177

762  
441  
301