

New Location   
 Drill Deeper   
 Abandonment

Company MINK OIL COMPANY  
 Address 361 CLARK ST. NEW MARTINSVILLE W.V.  
 Farm WARD & VIRGINIA JENNINGS  
 Tract Acres 157.6 Lease No. \_\_\_\_\_  
 Well (Farm) No. ONE Serial No. \_\_\_\_\_  
 Elevation (Spirit Level) 920'  
 Quadrangle NEW MARTINSVILLE *EE*  
 County WETZEL District GREEN  
 Engineer GL MCINTIRE  
 Engineer's Registration No. 1187  
 File No. \_\_\_\_\_ Drawing No. \_\_\_\_\_  
 Date 9/5/51 Scale 1" = 600'

STATE OF WEST VIRGINIA  
 DEPARTMENT OF MINES  
 OIL AND GAS DIVISION  
 CHARLESTON

WELL LOCATION MAP  
 FILE NO. Wet-375

+ Denotes location of well on United States  
 Topographic Maps, scale 1 to 62,500, lat-  
 itude and longitude lines being represented  
 by border lines as shown.

- Denotes one inch spaces on border line  
 of original tracing.



STATE OF WEST VIRGINIA  
DEPARTMENT OF MINES  
OIL AND GAS DIVISION / 2

New Martinsville

WELL RECORD

Permit No. Wet 375


Oil or Gas Well Dry

Company Mink Oil Co  
Address 20 F. C. Wells New Martinsville  
Farm WARD JENNINGS Acres 167+  
Location (waters) \_\_\_\_\_  
Well No. \_\_\_\_\_ Elev. 920'  
District GREEN County Wetzel  
The surface of tract is owned in fee by WARD JENNINGS  
RFD Address NEW MARTINSVILLE  
Mineral rights are owned by SAME  
Address \_\_\_\_\_  
Drilling commenced Sept 15, 1951  
Drilling completed Oct 16, 1951  
Date Shot \_\_\_\_\_ From \_\_\_\_\_ To \_\_\_\_\_  
With \_\_\_\_\_  
Open Flow \_\_\_\_\_ /10ths Water in \_\_\_\_\_ Inch  
\_\_\_\_\_ /10ths Merc. in \_\_\_\_\_ Inch  
Volume \_\_\_\_\_ Cu. Ft.  
Rock Pressure \_\_\_\_\_ lbs. \_\_\_\_\_ hrs.  
Oil \_\_\_\_\_ bbls., 1st 24 hrs.  
Fresh water \_\_\_\_\_ feet \_\_\_\_\_ feet  
Salt water \_\_\_\_\_ feet \_\_\_\_\_ feet

Casing and Tubing	Used in Drilling	Left in Well	Packers
Size			Kind of Packer
16			
13			
10	<u>192</u>		Size of
8 1/4	<u>1215</u>		
6 1/2	<u>1855</u>		Depth set
5 3/16			
3			Perf. top
2			Perf. bottom
Liners Used			Perf. top
			Perf. bottom

CASING CEMENTED \_\_\_\_\_ SIZE \_\_\_\_\_ No. Ft. \_\_\_\_\_ Date \_\_\_\_\_  
COAL WAS ENCOUNTERED AT 535 FEET \_\_\_\_\_ INCHES  
\_\_\_\_\_ FEET 12 INCHES \_\_\_\_\_ FEET \_\_\_\_\_ INCHES  
\_\_\_\_\_ FEET \_\_\_\_\_ INCHES \_\_\_\_\_ FEET \_\_\_\_\_ INCHES

Formation	Color	Hard or Soft	Top	Bottom	Oil, Gas or Water	Depth Found	Remarks
Top Soil & Clay							
Sandstone			0	100	<u>192'</u>	<u>10" casing</u>	<u>0</u>
Lime & Shale			100	555			
Mapletown Coal		soft	555	556			
Lime & shale			556	685			
Red Rock	Red	soft	685	695			
Sand		hard	695	710			
Shale	Blue		710	745		<u>1925</u>	
Lime			745	810		<u>920</u>	
Shale			810	855		<u>1005</u>	
Sand	dark		855	905			
"	light	hard	905	925			
Red Rock		soft	925	935			
Shale		soft	935	950			
Red Rock			950	1000			
Shale & Red Rock		soft	1000	1130			
Sand			1130	1155			
Shale			1155	1208			

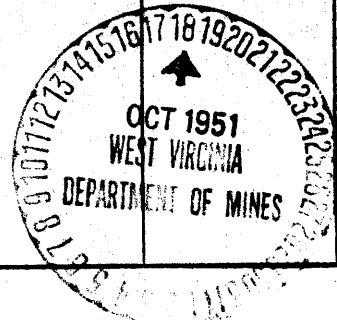

Formation	Color	Hard or Soft	12. Top	Bottom	Oil, Gas or Water	Depth Found	Remarks
LIME			1208	1220		1215'	84 casing
shale	Blue		1220	1260			6
SANDY shale			1260	1358			
LIME			1358	1375			
shale		soft	1375	1500			
SAND			1500	1647			
shale			1647	1650			
SAND			1650	1755			
shale			1755	1825			
SAND			1825	1834		1925	
SLATE (Pencil (AVE))			1834	1840		92.0	
LIME	DARK		1840	1850		1000	
SANDY shale			1850	1925			
LIME	white	hard	1925	1990			
Keener		"	1990	2040			
Big Lujun		"	2040	2684			total depth water

CAMEL OIL CO.

Date Oct 16, 1916  
 APPROVED Carmel Oil Co Owner  
 By H. L. Clinch - contractor (Title)