

COAL OWNED BY  
 STORAGE  X

NEW LOCATION.....

DRILL DEEPER.....

ABANDONMENT.....

COMPANY The Manufacturers Light & Heat Co.

ADDRESS 800 Union Trust Bldg. Pgh. Pa.

FARM Clarence Blatt

TRACT \_\_\_\_\_ ACRES 180 LEASE NO. 26469

WELL (FARM) NO. 1 SERIAL NO. F-3816

ELEVATION (SPRINT LEVEL) 986'

QUADRANGLE Littleton

COUNTY Wetzel DISTRICT Practor

ENGINEER Thomas E. Virgin J.M.

ENGINEER'S REGISTRATION NO. \_\_\_\_\_

FILE NO. \_\_\_\_\_ DRAWING NO. Y-13-974

DATE Apr. 24, 1954 SCALE 1" = 800'

STATE OF WEST VIRGINIA  
 DEPARTMENT OF MINES  
 OIL AND GAS DIVISION  
 CHARLESTON

**WELL LOCATION MAP**

FILE NO. Wet-397

+ DENOTES LOCATION OF WELL ON UNITED STATES/TOPOGRAPHIC MAPS. SCALE 1 TO 62,500. LATITUDE AND LONGITUDE LINES BEING REPRESENTED BY BORDER LINES AS SHOWN.

- DENOTES ONE INCH SPACES ON BORDER LINE OF ORIGINAL TRACING.

Latitude

39°45'00"

80°40'00"

Longitude

2.53s  
1.11w

**Topo Location**

7.5' Loc. \_\_\_\_\_ 15' Loc. \_\_\_\_\_  
(calc.) \_\_\_\_\_

Company Manufac Lt & HT

Farm Clarence Blatt 1

15' Quad \_\_\_\_\_  
(sec.)

7.5' Quad Wileyville

District Proctor

**WELL LOCATION PLAT**

County 103 Permit 397



STATE OF WEST VIRGINIA  
DEPARTMENT OF MINES  
OIL AND GAS DIVISION

1430

WELL RECORD

Permit No. 199

Oil or Gas Well \_\_\_\_\_ (KIND)



Company ~~THE MANUFACTURERS LIGHT AND HEAT COMPANY~~  
Address 800 Union Trust Building, Pgh., Penna.  
Farm Clarence Blatt Acres 180  
Location (waters) \_\_\_\_\_  
Well No. F-3816 Elev. 776  
District Proctor County Wetzel  
The surface of tract is owned in fee by \_\_\_\_\_  
Address \_\_\_\_\_  
Mineral rights are owned by \_\_\_\_\_  
Address \_\_\_\_\_

Casing and Tubing	Used in Drilling	Left in Well	Packers
Size			Kind of Packer
16			
13			
10			Size of
8 1/4			
6 5/8			Depth set
5 3/16			
3			Perf. top
2			Perf. bottom
Liners Used			Perf. top
			Perf. bottom

Drilling commenced \_\_\_\_\_  
Drilling completed \_\_\_\_\_  
Date Shot \_\_\_\_\_ From \_\_\_\_\_ To \_\_\_\_\_  
With \_\_\_\_\_  
Open Flow \_\_\_\_\_ /10ths Water in \_\_\_\_\_ Inch  
\_\_\_\_\_ /10ths Merc. in \_\_\_\_\_ Inch  
Volume \_\_\_\_\_ Cu. Ft.  
Rock Pressure \_\_\_\_\_ lbs. \_\_\_\_\_ hrs.  
Oil \_\_\_\_\_ bbls., 1st 24 hrs.  
Fresh water \_\_\_\_\_ feet \_\_\_\_\_ feet  
Salt water \_\_\_\_\_ feet \_\_\_\_\_ feet

CASING CEMENTED \_\_\_\_\_ SIZE \_\_\_\_\_ No. Ft. \_\_\_\_\_ Date \_\_\_\_\_  
COAL WAS ENCOUNTERED AT \_\_\_\_\_ FEET \_\_\_\_\_ INCHES  
\_\_\_\_\_ FEET \_\_\_\_\_ INCHES FEET \_\_\_\_\_ INCHES  
\_\_\_\_\_ FEET \_\_\_\_\_ INCHES FEET \_\_\_\_\_ INCHES

Formation	Color	Hard or Soft	Top	Bottom	Oil, Gas or Water	Depth Found	Remarks
Clay			0	6			
Lime			6	15			
Red Rock			15	24			
Slate			24	37			
Lime			37	50			
Slate			50	60			
Red Rock			60	72			
Lime			72	120			
Red Rock			120	130			
Slate			130	155			
Lime			155	160			
Slate			160	168			
Red Rock			168	175			
Slate			175	204			
Lime			204	220			
Slate			220	250			
Red Rock			250	260			
Lime			260	275			
Slate			275	285			
Lime			285	290			
Sand			290	307			
Red Rock			307	315			
Lime			315	335			
Red Rock			335	345			
Slate			345	372			
Lime			372	400			
Slate			400	437			
Lime			437	455			
Sand			455	475			
Slate			475	500			
Lime			500	523			
Sand			523	555			
Slate			555	568			
Lime			568	692			
Mapletown Coal			692	697			
Lime			697	798			
Pittsburgh Coal			798	805			
Lime			805	820			
Slate			820	860			

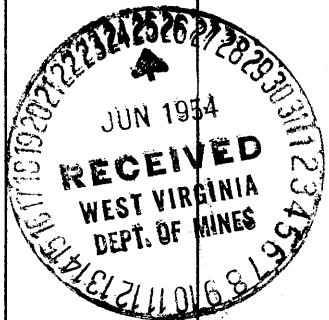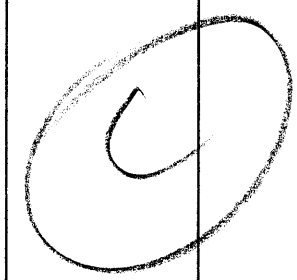

Pgh. Coal on F-3816 is 771' to 781'

(Over)

NOV 12 1954

Formation	Color	Hard or Soft	Top	Bottom	Oil, Gas or Water	Depth Found	Remarks
Murphy Sand			860	904			
<p>NOTE: This record is actually of a nearby well to F-3816. The only record we have of F-3816 starts at the Pitts. Coal which shows the coal to be 771' to 781'. Well F-3816 was originally drilled to a total depth of 898' on account of two strings of tools being lost in the hole it was abandoned and plugged. We have fished out the tools and drilled two feet making the hole now a depth of 900', from which depth we expect to plug back to surface.</p>							

Date JUNE 24, 1954

APPROVED THE MANUFACTURERS LIGHT AND HEAT COMPANY, Owner

By *Paul Cooper*  
(Title) LAND AGENT