


1.08 S
3.69 W

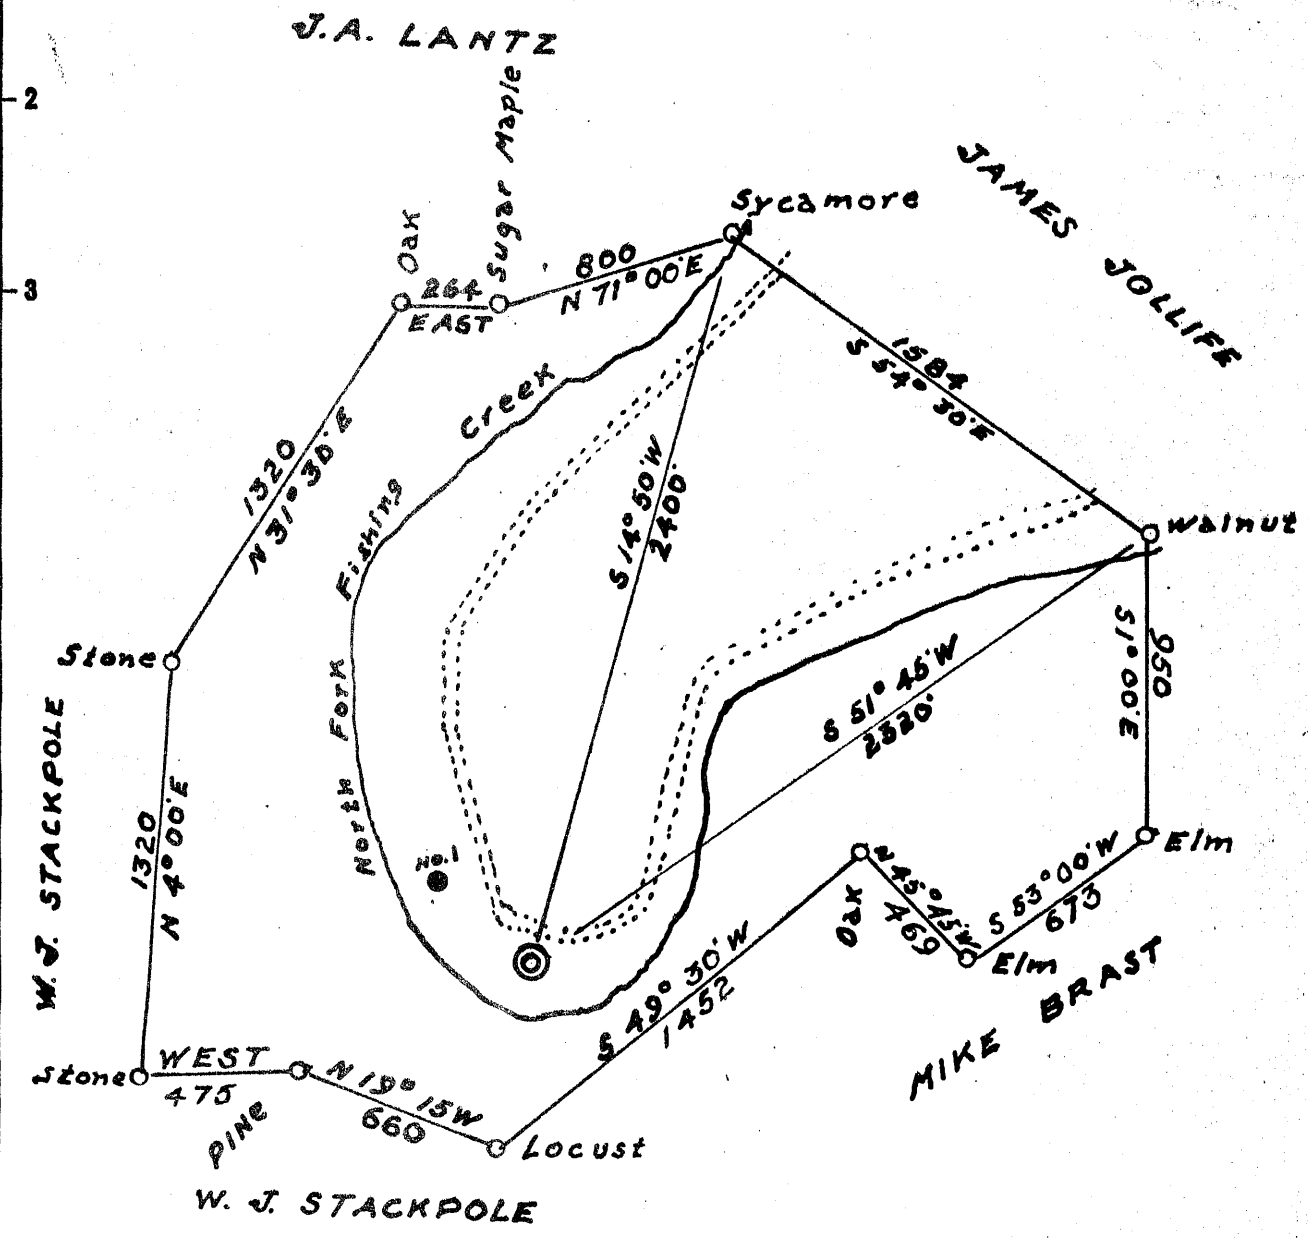

- New Location...
- Drill Deeper.....
- Abandonment.....

Company	LOWTHER & BAKER
Address	MIDDLEBOURN, W.Va.
Farm	WORTH JACOBS
Tract	Acres 106 Lease No. _____
Well (Farm) No.	TWO Serial No. _____
Elevation (Spirit Level)	734
Quadrangle	LITTLETON
County	WETZEL District GRANT
Engineer	<i>J.L.M. Justice</i>
Engineer's Registration No.	1187
File No.	Drawing No. _____
Date	Aug. 1, 1955 Scale 1" = 600'


STATE OF WEST VIRGINIA
DEPARTMENT OF MINES
OIL AND GAS DIVISION
CHARLESTON

WELL LOCATION MAP
FILE NO. Wet-417

+ Denotes location of well on United States Topographic Maps, scale 1 to 62,500, latitude and longitude lines being represented by border lines as shown.

- Denotes one inch spaces on border line of original tracing.

Latitude

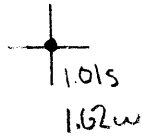

Longitude

Topo Location

7.5' Loc. _____ 15' Loc. _____
 _____ (calc.) _____

Company Lawther & Baker

Farm Worth Jacobs # 2

15' Quad _____
(sec.)

7.5' Quad Pine Grove

District Grant

WELL LOCATION PLAT

County 103 **Permit** 417



STATE OF WEST VIRGINIA
DEPARTMENT OF MINES
OIL AND GAS DIVISION

WELL RECORD

Permit No. Wet - 417

Oil or Gas Well Gas
(KIND)

Company Lowther & Baker Drilling Co.
Address Middlebourne, W. Va.
Farm Worth Jacobs Acres 140
Location (waters) North Fork of Fishing Creek
Well No. #2 Elev. 734'
District Grant County Wetzel
The surface of tract is owned in fee by Worth Jacobs
Address Fairmont, W. Va.
Mineral rights are owned by Same person
Address _____
Drilling commenced Nov. 15, 1955
Drilling completed Nov. 23, 1955
Date Shot Not From _____ To _____
With _____
Open Flow 30000 /10ths Water in _____ Inch
30000 /10ths Merc. in _____ Inch
Volume _____ Cu. Ft.
Rock Pressure 105 lbs. _____ hrs.
Oil None bbls., 1st 24 hrs.
Fresh water 40 feet _____ feet
Salt water None feet _____ feet

Casing and Tubing	Used in Drilling	Left in Well	Packers
Size			Kind of Packer
16			
13			
10			Size of
8 1/4			
6 5/8	70	70	Depth set
5 3/16	390	390	
3			Perf. top
2			Perf. bottom
Liners Used			Perf. top
			Perf. bottom

CASING CEMENTED _____ SIZE _____ No. Ft. _____ Date _____

COAL WAS ENCOUNTERED AT 440 FEET 24 INCHES
473 FEET 7 ft. INCHES FEET INCHES
FEET INCHES FEET INCHES

Formation	Color	Hard or Soft	Top	Bottom	Oil, Gas or Water	Depth Found	Remarks
Soil & gravel			0	12			
gravel			12	20			
Slate			20	36			
Slate			36	47			
Sand			47	54	Little water		
Slate			54	90			
Red Rock			90	95			
Sand			95	117			
Slate			117	122			
Coal <u>WPS</u>			122	123	Little gas, some water		
Slate & Lime			123	183			
Sand			183	190			
Slate & shell			190	255			
Lime			255	275			
Red Rock			275	290			
Lime			290	350			
Slate			350	385	Little gas	355	
Lime			385	395			
Slate			395	400			
Lime			400	440			
Coal <u>WPS</u>			440	442			
Lime			442	469			
Slate			469	473			
Fitts. Coal			473	480	Gas		
TOTAL DEPTH			484				

734
473
241

