


P

Latitude 39° 35'

0.05 S
3.39 W

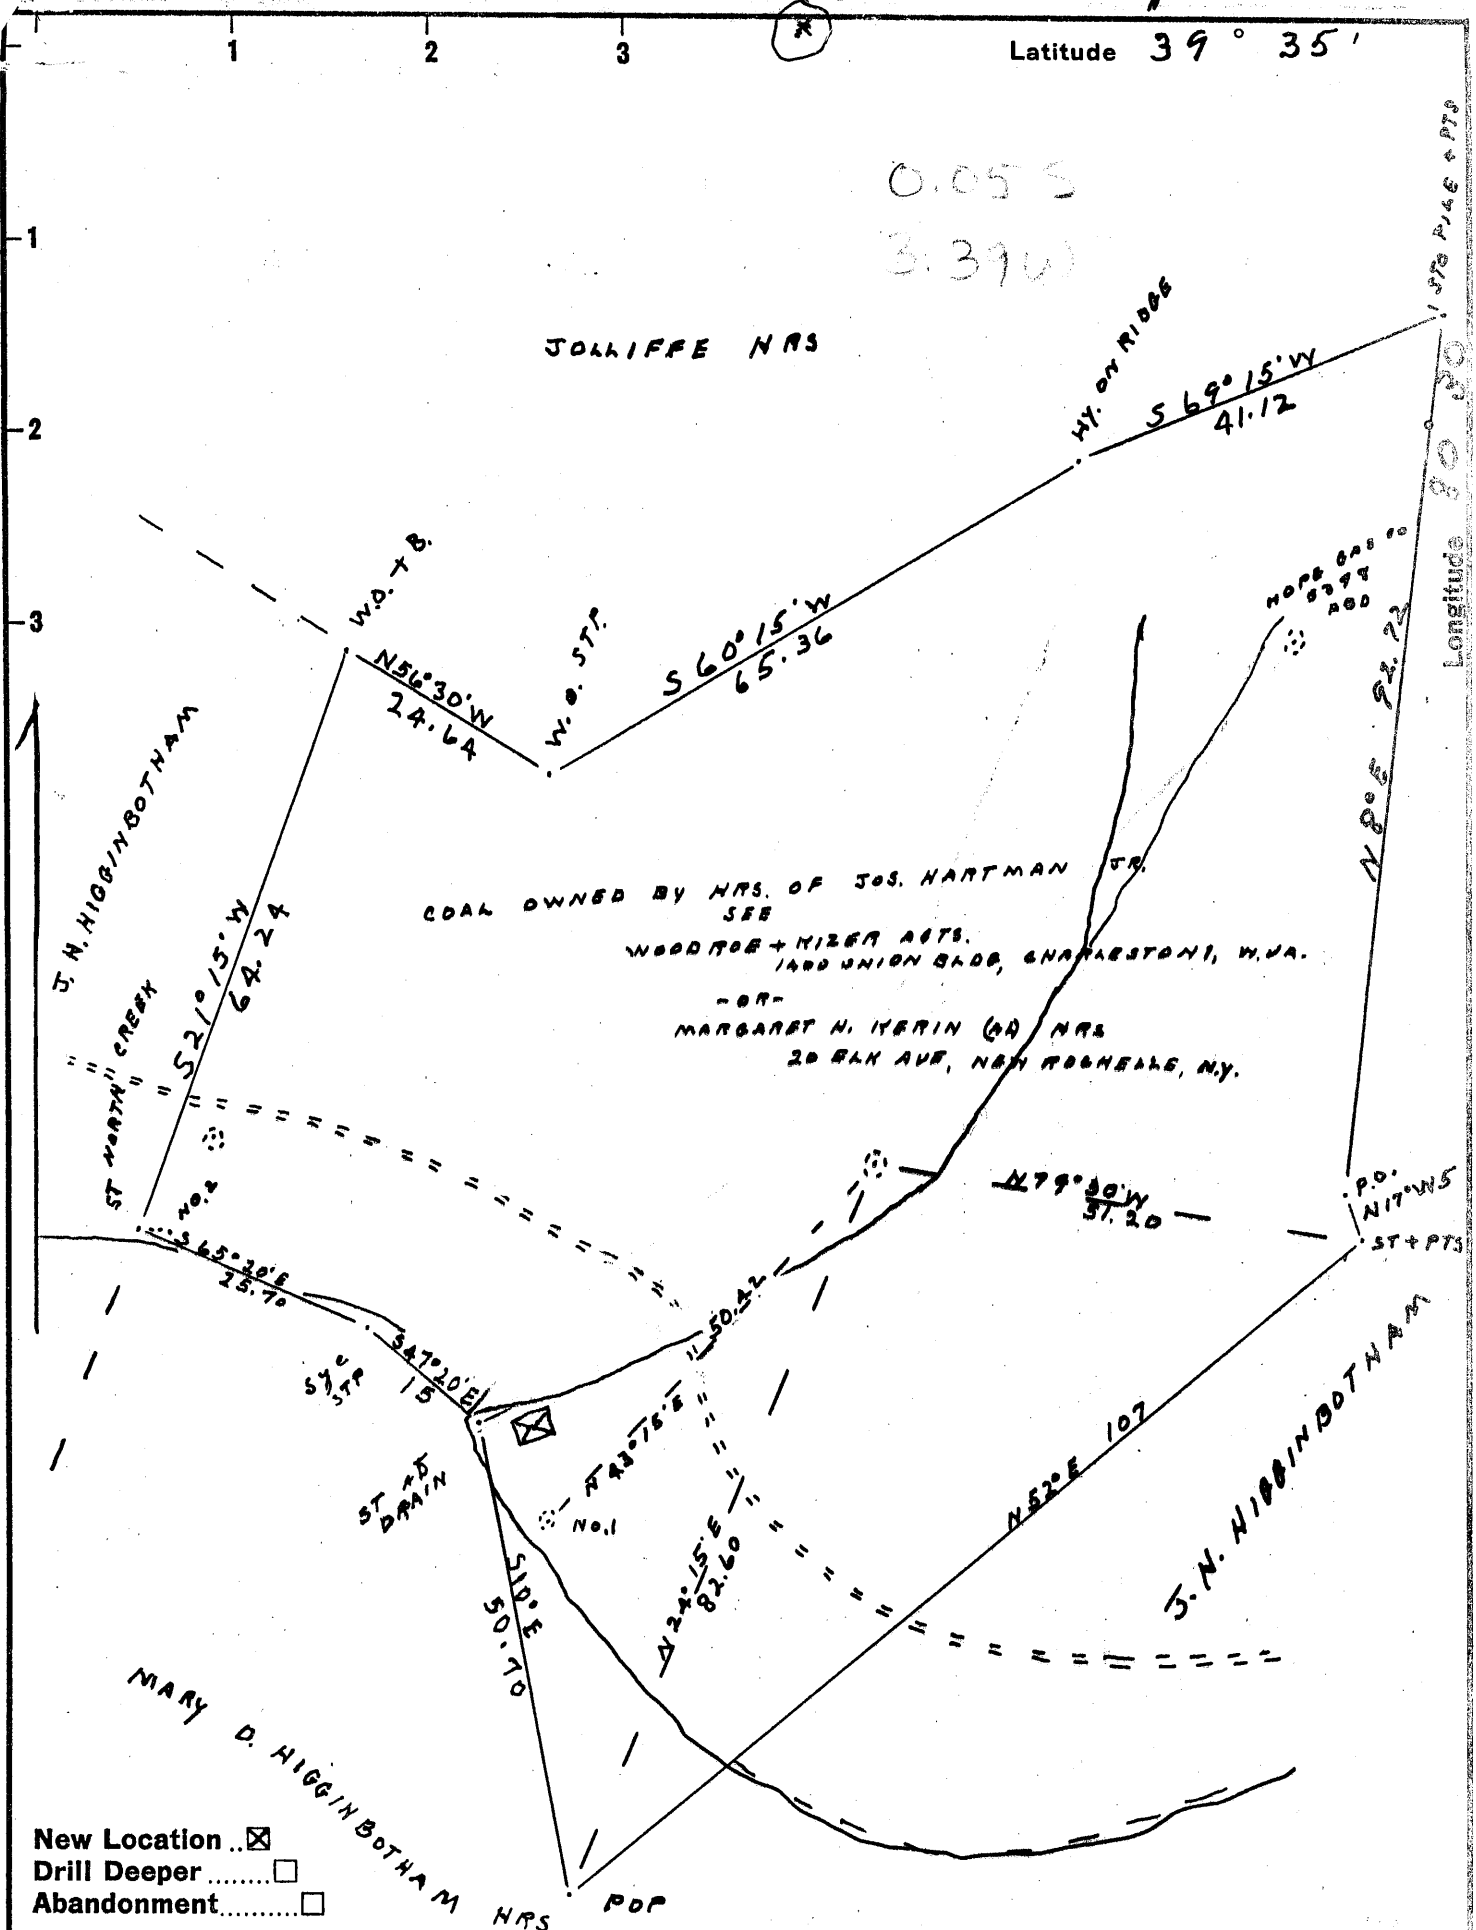

- New Location ..
- Drill Deeper ..
- Abandonment ..

AB. LOWTHER AGT

Company NORTH FORK DEVELOPMENT CO

Address MIDDLEBURY, W.VA.

Farm J. HERBERT HIGGINBOTHAM

Tract 1 Acres 23 3/4 Lease No. _____

Well (Farm) No. 3 Serial No. _____

Elevation (Spirit Level) 885.5

Quadrangle LITTLETON - S.E.

County WETZEL District GRANT

Engineer G.L. McIntire

Engineer's Registration No. 1187

File No. _____ Drawing No. _____

Date JUNE 17-1952 Scale 1" = 20 RODS

STATE OF WEST VIRGINIA
DEPARTMENT OF MINES
OIL AND GAS DIVISION
CHARLESTON

WELL LOCATION MAP
FILE NO. Wet-452

+ Denotes location of well on United States Topographic Maps, scale 1 to 62,500, altitude and longitude lines being represented by border lines as shown.

- Denotes one inch spaces on border line of original tracing.

6-6 45



STATE OF WEST VIRGINIA
DEPARTMENT OF MINES
OIL AND GAS DIVISION

Sutton

WELL RECORD

Permit No. WET-452

Oil or Gas Well Gas
(KIND)

Company North Fork Development Company
Address c/o A. B. Lowther, Agt.
Middlebourne, W. Va.
Farm J. Herbert Higginbotham Acres 140
Location (waters) North Fork of Fishing Creek
Well No. 3 Elev. 885.5
District Grant County Wetzel
The surface of tract is owned in fee by J. Herbert
Higginbotham Address Big Run, W. Va.
Mineral rights are owned by J. Herbert Higginbotham
and others Address Big Run, W. Va.
Drilling commenced 7-26-57
Drilling completed 8-9-57
Date Shot xx From _____ To _____
With _____
Open Flow /10ths Water in _____ Inch
/10ths Merc. in _____ Inch
Volume 70,000 Cu. Ft.
Rock Pressure 105 lbs. _____ hrs.
Oil _____ bbls., 1st 24 hrs.
Fresh water 60 feet
Salt water -- feet

Casing and Tubing	Used in Drilling	Left in Well	Packers
Size			
16			Kind of Packer
13			
10			Size of
8 1/4			
6 5/8			Depth set
5 3/16	<u>571 ft.</u>	<u>571 ft.</u>	
3			Perf. top
2			Perf. bottom
Liners Used			Perf. top
			Perf. bottom

CASING CEMENTED _____ SIZE _____ No. Ft. _____ Date _____

COAL WAS ENCOUNTERED AT 110 FEET 12 INCHES
245 FEET 36 INCHES 355 FEET 12 INCHES
500 FEET 24 INCHES 608 FEET 48 INCHES
613 12

Formation	Color	Hard or Soft	Top	Bottom	Oil, Gas or Water	Depth Found	Remarks
Soil			0	10			
Stone			10	30			
Slate			30	60			Water - 60
Red Rock			60	80			
Lime			80	90			
Slate			90	110			
Coal			110	111			
Slate			111	121			
Slate and Lime Shells			121	245			
Coal			245	248			
Slate			248	260			
Sand			260	270			
Slate and Lime Shells			270	305			
Slate			305	355			
Coal			355	356			
Lime			356	360			
Slate			360	375			
Coal			375	376			
Slate			376	390			
Lime			390	400			
Slate			400	425			
Slate and Lime Shells			425	440			
Lime			440	495			
Slate			495	500			
Coal			500	502			
Slate			502	535			
Lime			535	565			
Slate			565	575			
Lime			575	590			
Slate			590	600			
Lime			600	602			
Slate			602	604			
Lime			604	606			
Slate			606	608			
Coal			608	612			
Slate			612	613			Gas at 613
Coal			613	614			

(Over)