

LOCATION FOR WELL No. 55

Littleton DISTRICT


On Jane Blake Farm, on waters of Camp Run

Center District, Netzel County, West Virginia.

Lease No. 272 Acres 40 N. 14 S. 6 E. 4 W.

Scale, one inch equals Sent to 1.

Location to be

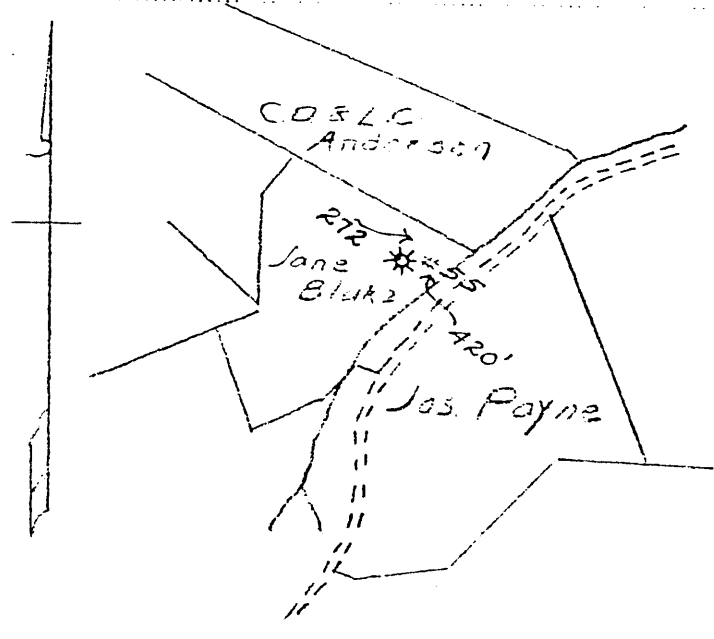

103-656

RESERVE

SPECIAL INSTRUCTIONS

Location Mes 4-27-11 by F.A. Guy As per plat, except as noted. On field map

Returned to Pittsburgh

Location changed on account of

Approved by



55

# WELL RECORD.

*26*  
*May*

Jane Blake Farm \_\_\_\_\_ Acres \_\_\_\_\_  
 District Wetzel County W. Va. State \_\_\_\_\_

Well No. 1

Rig Commenced \_\_\_\_\_ 190 \_\_\_\_\_ }  
 Rig Completed \_\_\_\_\_ 190 \_\_\_\_\_ } Contractor.  
 Drilling Commenced Apr. 15 190 2 }  
 Drilling Completed June 2 190 2 } Chas. Barron Contractor.

ROCK FORMATION.	TOP.	BOTTOM.	REMARKS.
<i>Cond.</i>	<i>16</i>		
<i>Pittsburgh Coal</i>	<i>990</i>	<i>998</i>	
<i>Dunkard Sand</i>	<i>1400</i>	<i>1440</i>	
<i>Salt</i>	<i>1728</i>	<i>1898</i>	
<i>Major Salt "</i>	<i>2090</i>	<i>2144</i>	
<i>Water</i>	<i>1728</i>	<i>1890</i>	
<i>Gas</i>	<i>2095</i>		
<i>Cencil Cave</i>	<i>2145</i>	<i>2150</i>	
<i>Big Lime</i>	<i>2150</i>	<i>2243</i>	
<i>Big Inf.</i>	<i>2243</i>		
<i>Gas</i>	<i>2258</i>		
<i>"</i>	<i>2293</i>		
<i>Gas Strong</i>	<i>2328</i>		
<i>Total</i>	<i>2340</i>		

## CASING RECORD.

Size.	Charged to Well.		Put in Well.		Pulled Out.		Left in Well.		Transferred Before Completion.		Left at Well, Not in Use.	
	Feet	In	Feet	In	Feet	In	Feet	In	Feet	In	Feet	In
<i>10"</i>			<i>1162'</i>	<i>10"</i>								
<i>8 1/2"</i>			<i>1491</i>									
<i>6 3/8"</i>			<i>1981"</i>	<i>3"</i>								

Production }  
 First 24 hours } ..... Bbls.

Approved by \_\_\_\_\_

..... Supt.

Proof.—Sum of Three right hand columns equals First or "Charged to Well."  
 Use as many sheets as necessary to make a complete record.

103-656