

Hope Natural Gas Co,

LOCATION FOR WELL No. 380


Wetzel DISTRICT.

On Isaac Richardson Farm, on waters of Buck Run

Grant District, Wetzel County, West Virginia.

Lease No. Acres Range: N. 6 S. E. 6 W.

Scale 1" = 80 Poles Made Sept 9 1908

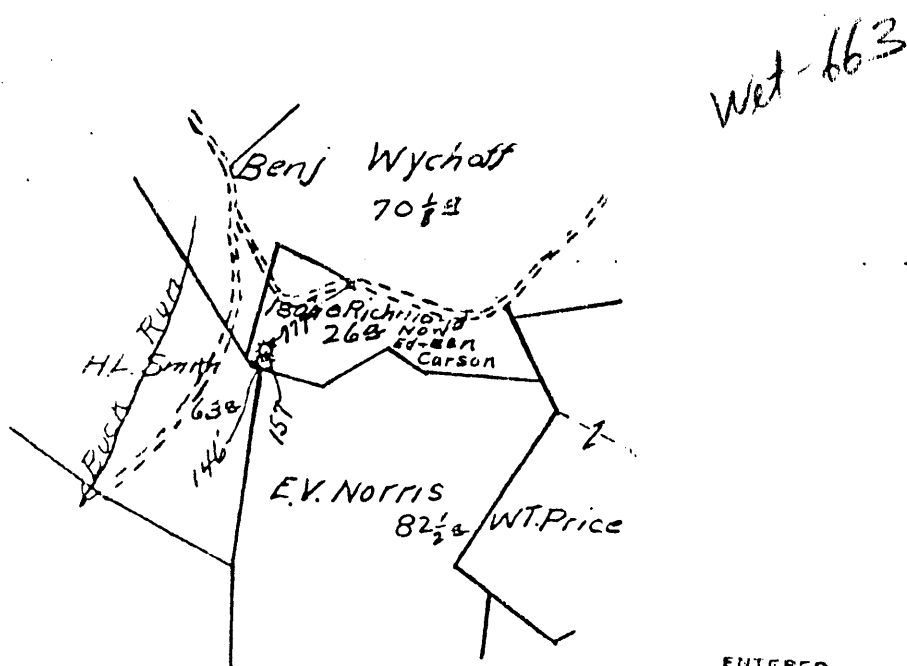

ENTERED  
LINE MAP  
3-3-1908  
BY G.B.

103-0663

ENTERED
WELL BOOK
LEASE RECORD
LEASE DOCKET
WALL MAP 12-31-08
WORKING MAP
LOCATION BOOK

LOCATION <u>Wetzel</u> 9-9-1908
BY <u>P. Senter</u>
As per plat. Except as noted
On 12-10-08 19
Approved to Pittsburg 19

RESERVE: .....

SPECIAL INSTRUCTIONS: .....



220

(OK-4-28-08-E.C.R.)

WELL No. 380.

Wetzel District. DISTRICT.

*J. Richmond* Farm. Well No. *380* (2) Lease No. \_\_\_\_\_ Acres. \_\_\_\_\_  
*Grant* Dist. *Wetzel* County, State *W. Va.* Date of Location, \_\_\_\_\_ 190 \_\_\_\_\_  
 Rig Commenced, \_\_\_\_\_ 190 Rig Completed, \_\_\_\_\_ 190 Contractor. \_\_\_\_\_  
 Drilling Commenced, \_\_\_\_\_ 190 Drilling Completed, *May 2<sup>nd</sup> 1896* *Morris Bros. Co* Contractor.

103-663

CASING RECORD.

Abandoned, \_\_\_\_\_ 190 \_\_\_\_\_

CHARGED TO WELL.			PUT IN WELL.		PULLED OUT OF WELL.		LEFT IN WELL.		TRANSFERRED BEFORE COMPLETION.		LEFT AT WELL NOT IN USE.		CASING PULLED.			CASING LEFT IN.		REMARKS.
Size.	Feet.	In.	Feet.	In.	Feet.	In.	Feet.	In.	Feet.	In.	Feet.	In.	Size.	Feet.	In.	Feet.	In.	
<i>10</i>			<i>940</i>		<i>940</i>													
<i>8 1/4</i>								<i>1785</i>										
<i>5 3/16</i>								<i>2260</i>										
<i>4"</i>								<i>290</i>										

FORMATION.

TOP.

BOTTOM

REMARKS.

SHOT RECORD.

FORMATION.	TOP.	BOTTOM	REMARKS.	DATE.	SIZE OF SHOT.	LENGTH OF SHELL.	TOP OF 1st SHELL	TOP OF 2nd SHELL	REMARKS.
<i>Pgh Coal</i>	<i>1276</i>			<i>July 3-05</i>	<i>20</i>	<i>3 1/2 x 10"</i>	<i>2645</i>	<i>2665</i>	<i>2-10ft shots</i>
<i>Expum Sand</i>	<i>2570</i>	<i>2720</i>							
<i>Gas</i>	<i>from 2556</i>	<i>2659</i>							
<i>Oil</i>	<i>2665</i>								
<i>Total Depth</i>		<i>2747</i>							

PRESSURE TESTS.

DATE TAKEN	LIQUID USED.	READING.	SIZE OF OPENING.	1 MIN.	5 MIN.	10 MIN.	30 MIN.	60 MIN.	ROCK.
<i>July 23-04</i>	<i>Mercury</i>	<i>6/10</i>	<i>2</i>						<i>130</i>
<i>Oct 5-05</i>	<i>mercury</i>	<i>4/10</i>	<i>2</i>						

July 15 - 05 Mercury 2/10 2 100 150 180 200 215 215

**ROCK PRESSURE.**

YEAR.	JAN.	FEB.	MAR.	APRIL	MAY.	JUNE.	JULY.	AUG.	SEPT.	OCT.	NOV.	DEC.
1905	350	360	360	360	360	335	330	450	350	320	325	305
1906	300	285	280	270	285	270	260	410	410	280	270	180
1907	180	180	200	180	185	185	155	160	370	155	140	180
	245	245	255	245	240	245	240	235	300	300	225	220
1908	140	130	155	140	350	390	370	380	365	375	390	380
	225	225	235	210	390	390	390	250	370			
1909	380	290	385	390	390	390	390	250	370			
19												
19												
113-605

**REMARKS:** Tubed with 2" - 3040 ft put in well.  
 56 ft on 4x7 (pocket 1406 ft - 1/8" Well pocket (?))  
 (4-28-08 G.C.R. = Time record shows 1785 ft 8 1/2" - 2260 ft - 5 1/2" - 290 ft 4" liner but no 6 5/8" while 6 5/8" is only casing to be seen in well. - No rig - derrick floor old lumber laying around - gate valves leaking.)