

STATE OF WEST VIRGINIA
DEPARTMENT OF ENVIRONMENTAL PROTECTION
OFFICE OF OIL AND GAS

AFFIDAVIT OF PLUGGING AND FILLING WELL

AFFIDAVIT SHOULD BE IN TRIPLICATE, one copy mailed to the Department, one copy to be retained by the Well Operator and the third copy (and extra copies if required) should be mailed to each coal operator at their respective addresses.

Farm name: James B Higgins ETAL Operator Well No.: 601625

LOCATION: Elevation: 809' Quadrangle: Littleton SE, 1 3-4
District: Grant County: Wetzel
Latitude: 39.582021 Feet South of _____ Deg. _____ Min. NAD 83 Sec.
Longitude: -80.586381 Feet West of _____ Deg. _____ Min. NAD 83 Sec.

Well Type: OIL _____ GAS X

Company Equitrans, LP Coal Operator See Attached
625 Liberty Ave or Owner _____
Pittsburgh, PA 15222 _____
Agent Justin Macken Coal Operator _____
Permit Issued Date 12/4/2017 or Owner _____

AFFIDAVIT

STATE OF WEST VIRGINIA,
County of Wetzel ss:

John Shaffer and Homer Zirkle being first duly sworn according to law depose and say that they are experienced in the work of plugging and filling oil and gas wells and were employed by the above named well operator, and participated in the work of plugging and filling the above well say that said work was commenced on the 4th day of December, 2017, and the well was plugged and filled in the following manner:

TYPE	FROM	TO	PIPE REMOVED	LEFT
Class A cement	2681'	1450'	2144' of 2 3/8"	342' of 3 3/8", 210' of 3 1/2", and 255' of 5 1/2"
Class A cement	1450'	447'	1280' of 5 1/2", 954' of 7"	425' of 5 1/2", 338' of 7"
Class A cement	447'	surface	201' of 8 5/8", and 99' of 10 3/4"	777' of 8 5/8", 167' of 10 3/4", and 89' of 13 3/8"

RECEIVED
Office of Oil and Gas
MAY 10 2018

WV Department of
Environmental Protection


Description of monument: 18' of 7" with API # & date plugged and that the work of plugging and filling said well was completed on the 5th day of January, 2018.

And further deponents saith not. [Signature]
Homer S. Zirkle

Sworn and subscribe before me this 13th day of February, 2018

My commission expires: April 9 2022

[Signature]
Notary Public

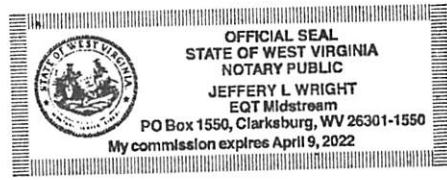

Affidavit reviewed by the Office of Oil and Gas: _____ Title: Oil + Gas Inspector

4710300830P

ATTACHMENT WW-4A-5)(a) Coal Operator, (b) Coal Owner(s) with Declaration, (c) Coal Lessee with Declaration

Coal Owners (less Pittsburgh Coal)

Coastal Forest Resources Co
Fka Coastal Lumber Company
ATTN: Edward G. Kraynok
P.O. Box 709
Buckhannon, WV 26201

Irrevocable Intervivos Trust of Billy Higgins
Frances J & William P. Higgins, Co-Trustees
531 Franklin Terrace
Washington, PA 15301

Deanna Merle Weber
633 Carothers Road
Weirton, WV 26062

Melinda Jo Carpenter
319 Franklin St.
Barnesville, OH 43713

Coal Owners (Pittsburgh Coal):

CNX Land LLC
Attn: Analyst
Engineering & Ops Support Dept. Coal
CNX Center, 1000 Consol Energy Drive
Canonsburg, PA 15317

WPP, LLC
ATTN: George Angus, VP and Regional Manager
5260 Irwin Road
Huntington, WV 25705-3247

Coal Lessee with Declaration:


Consol Mining Company LLC
Fka, Consolidation Coal Company
ATTN: Casey V. Saunders, P.E., Senior Project Engineer
1000 Consol Energy Drive
Cannonsburg, PA 15317

RECEIVED
Office of Oil and Gas

MAY 10 2018

WV Department of
Environmental Protection

Mobley Field Well # 1625 OBSERVATION WELL

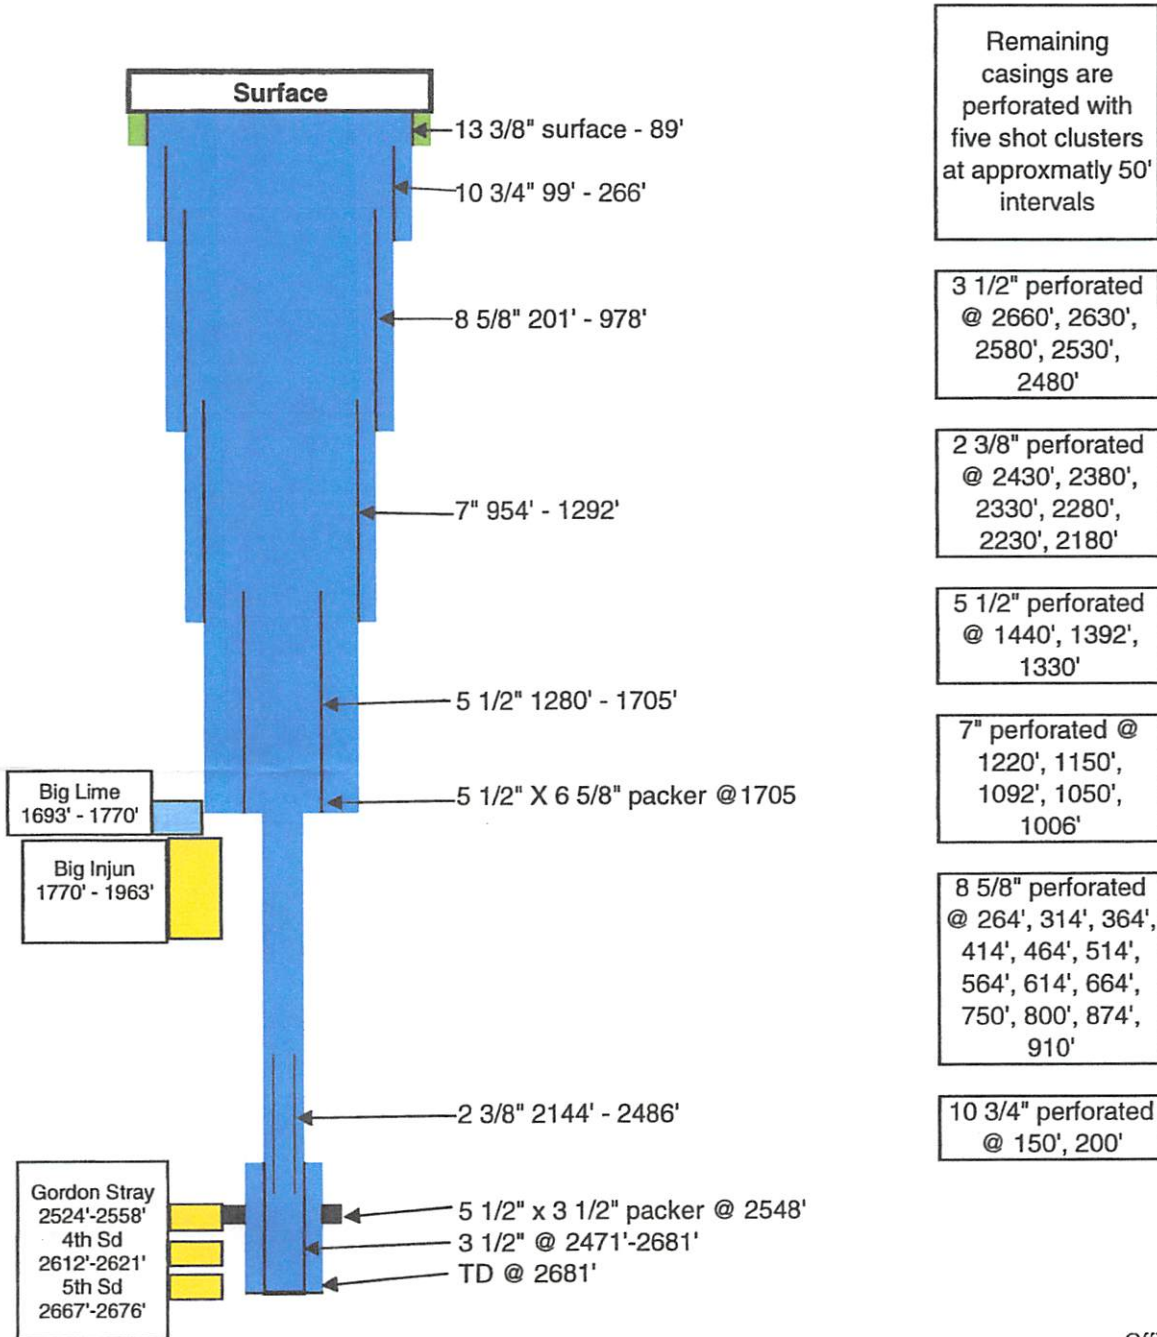

RECEIVED
Office of Oil and Gas

MAY 10 2018

WV Department of
Environmental Protection