

STATE OF WEST VIRGINIA
DEPARTMENT OF ENVIRONMENTAL PROTECTION
OFFICE OF OIL AND GAS

AFFIDAVIT OF PLUGGING AND FILLING WELL

AFFIDAVIT SHOULD BE IN TRIPLICATE, one copy mailed to the Department, one copy to be retained by the Well Operator and the third copy (and extra copies if required) should be mailed to each coal operator at their respective addresses.

Farm name: Hubbard Operator Well No.: WV 601769

LOCATION: Elevation: 980' Quadrangle: Big Run

District: Grant County: Wetzel

Latitude: 0 Feet South of 39 Deg. 35 Min. 48.879 Sec.

Longitude: 0 Feet West of -80 Deg. 33 Min. 39.0018 Sec.

Well Type: OIL _____ GAS X

Company Equitrans, LP
625 Liberty Ave
Pittsburgh, PA 15222

Coal Operator Liberty Holding Company
or Owner 18 Hollen Circle
Fairmont, WV 26554

Agent Justin Macken

Coal Operator _____
or Owner _____

Permit Issued Date 8/22/2014

AFFIDAVIT

STATE OF WEST VIRGINIA,
County of Wetzel ss:

Brian A. Hall and Jack Shaffer being first duly sworn according to law depose and say that they are experienced in the work of plugging and filling oil and gas wells and were employed by the above named well operator, and participated in the work of plugging and filling the above well say that said work was commenced on the 22th day of August, 2014, and the well was plugged and filled in the following manner:

TYPE	FROM	TO	PIPE REMOVED	LEFT
Class A cement	2016'	1918'	1906' of 3.5"	156'
6% gel	1918'	1906'		
Class A cement	1906'	surface		1872' of 7", 1175' of 8-5/8" & 314' of 10-3/4"


Description of monument: 20' of 3.5" with API # & date plugged and that the work of plugging and filling said well was completed on the 1st day of September, 2014.

And further deponents saith not. Brian A. Hall
Jack Shaffer

Sworn and subscribe before me this 8 day of February, 2018

My commission expires: April 9 2022

Jeffery L Wright
Notary Public

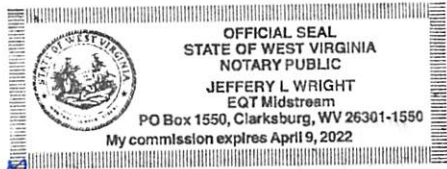

Affidavit reviewed by the Office of Oil and Gas: _____ Title: Oil & Gas Inspector

Well 1769



ASSOCIATED POOL
Mobley

STORAGE ZONE
Big Injun

PRODUCTION FORMATIONS
Big Injun

THICKNESS **FORMATIONS**

GAS @ **OPEN / CASED HOLE** **COMPLETION DESIGN** **PERF OPER (year)**

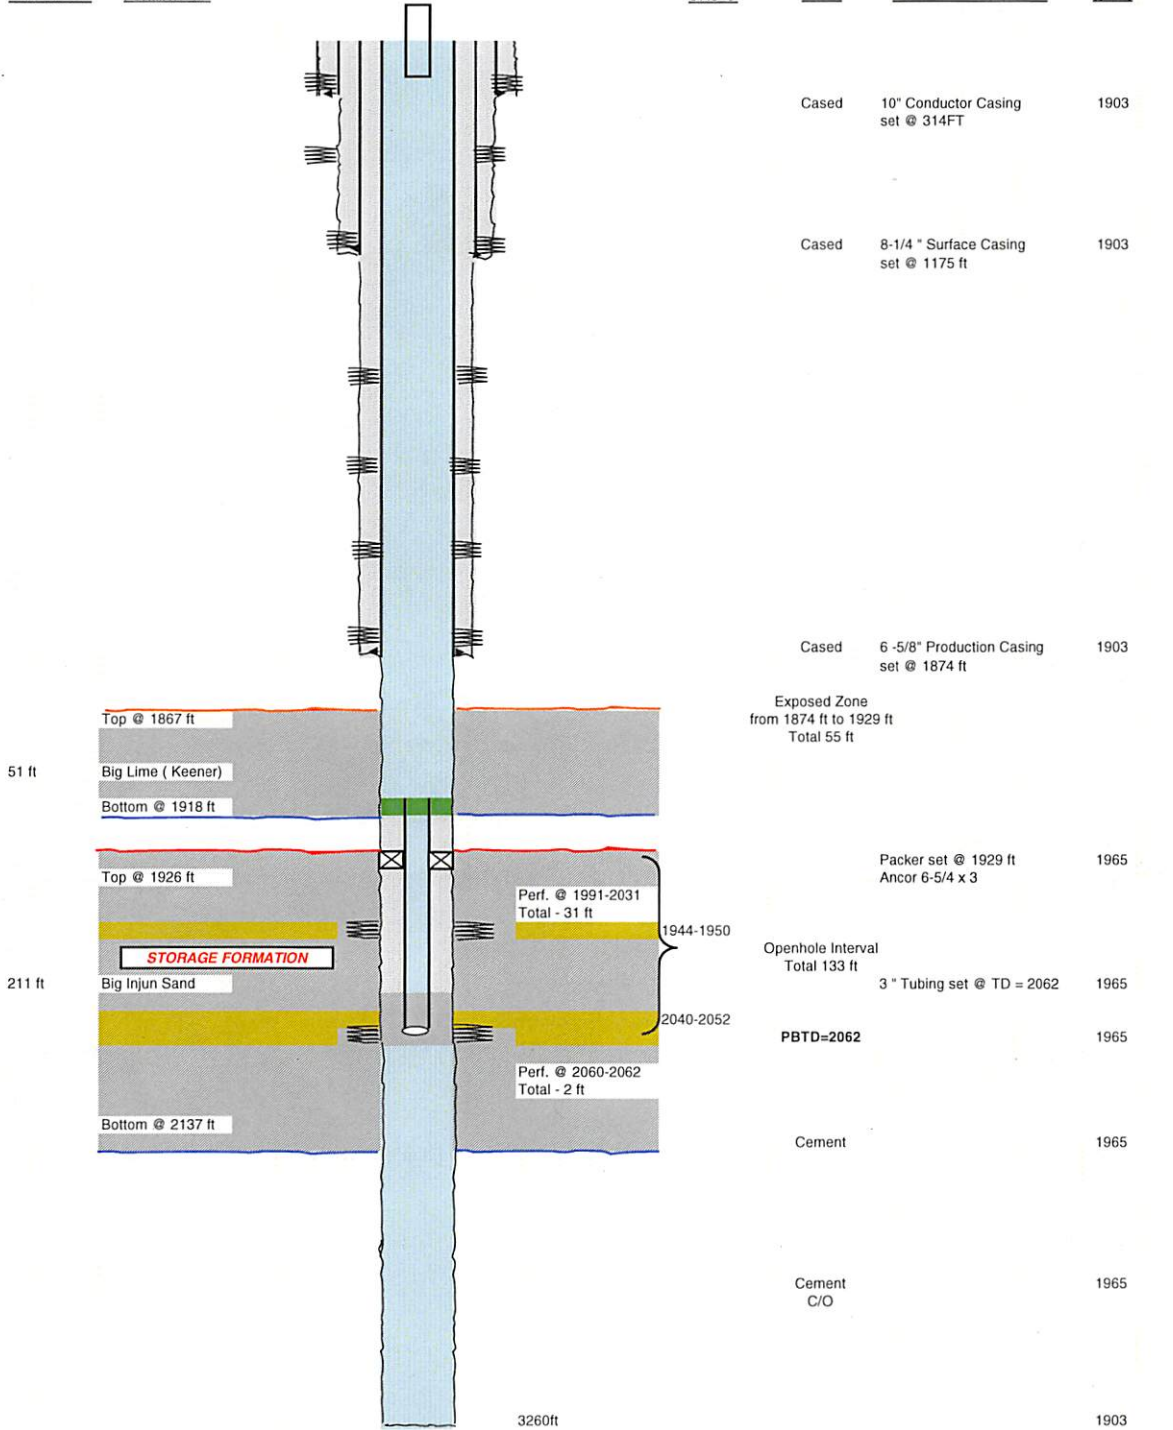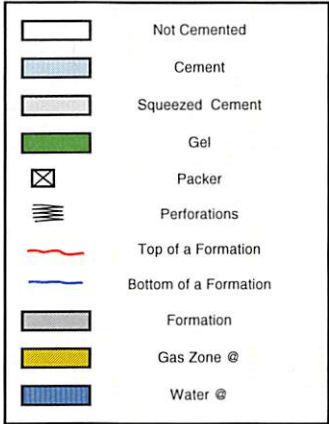

RECEIVED
Office of Oil and Gas
MAY 10 2018
WV Department of
Environmental Protection