


LATITUDE 39° 40' 00"

80° 40' 00"

LONGITUDE

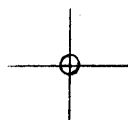

7.5 OGIS topo location

7.5' loc 1.785
1.31W

15' loc 1.785
(calc.) 1.31W

Company _____

Farm _____

Littleton WC


Quad WILEYVILLE 7 1/2'

County WETZEL

District PROCTOR

WELL LOCATION MAP

File No. 103 - 904

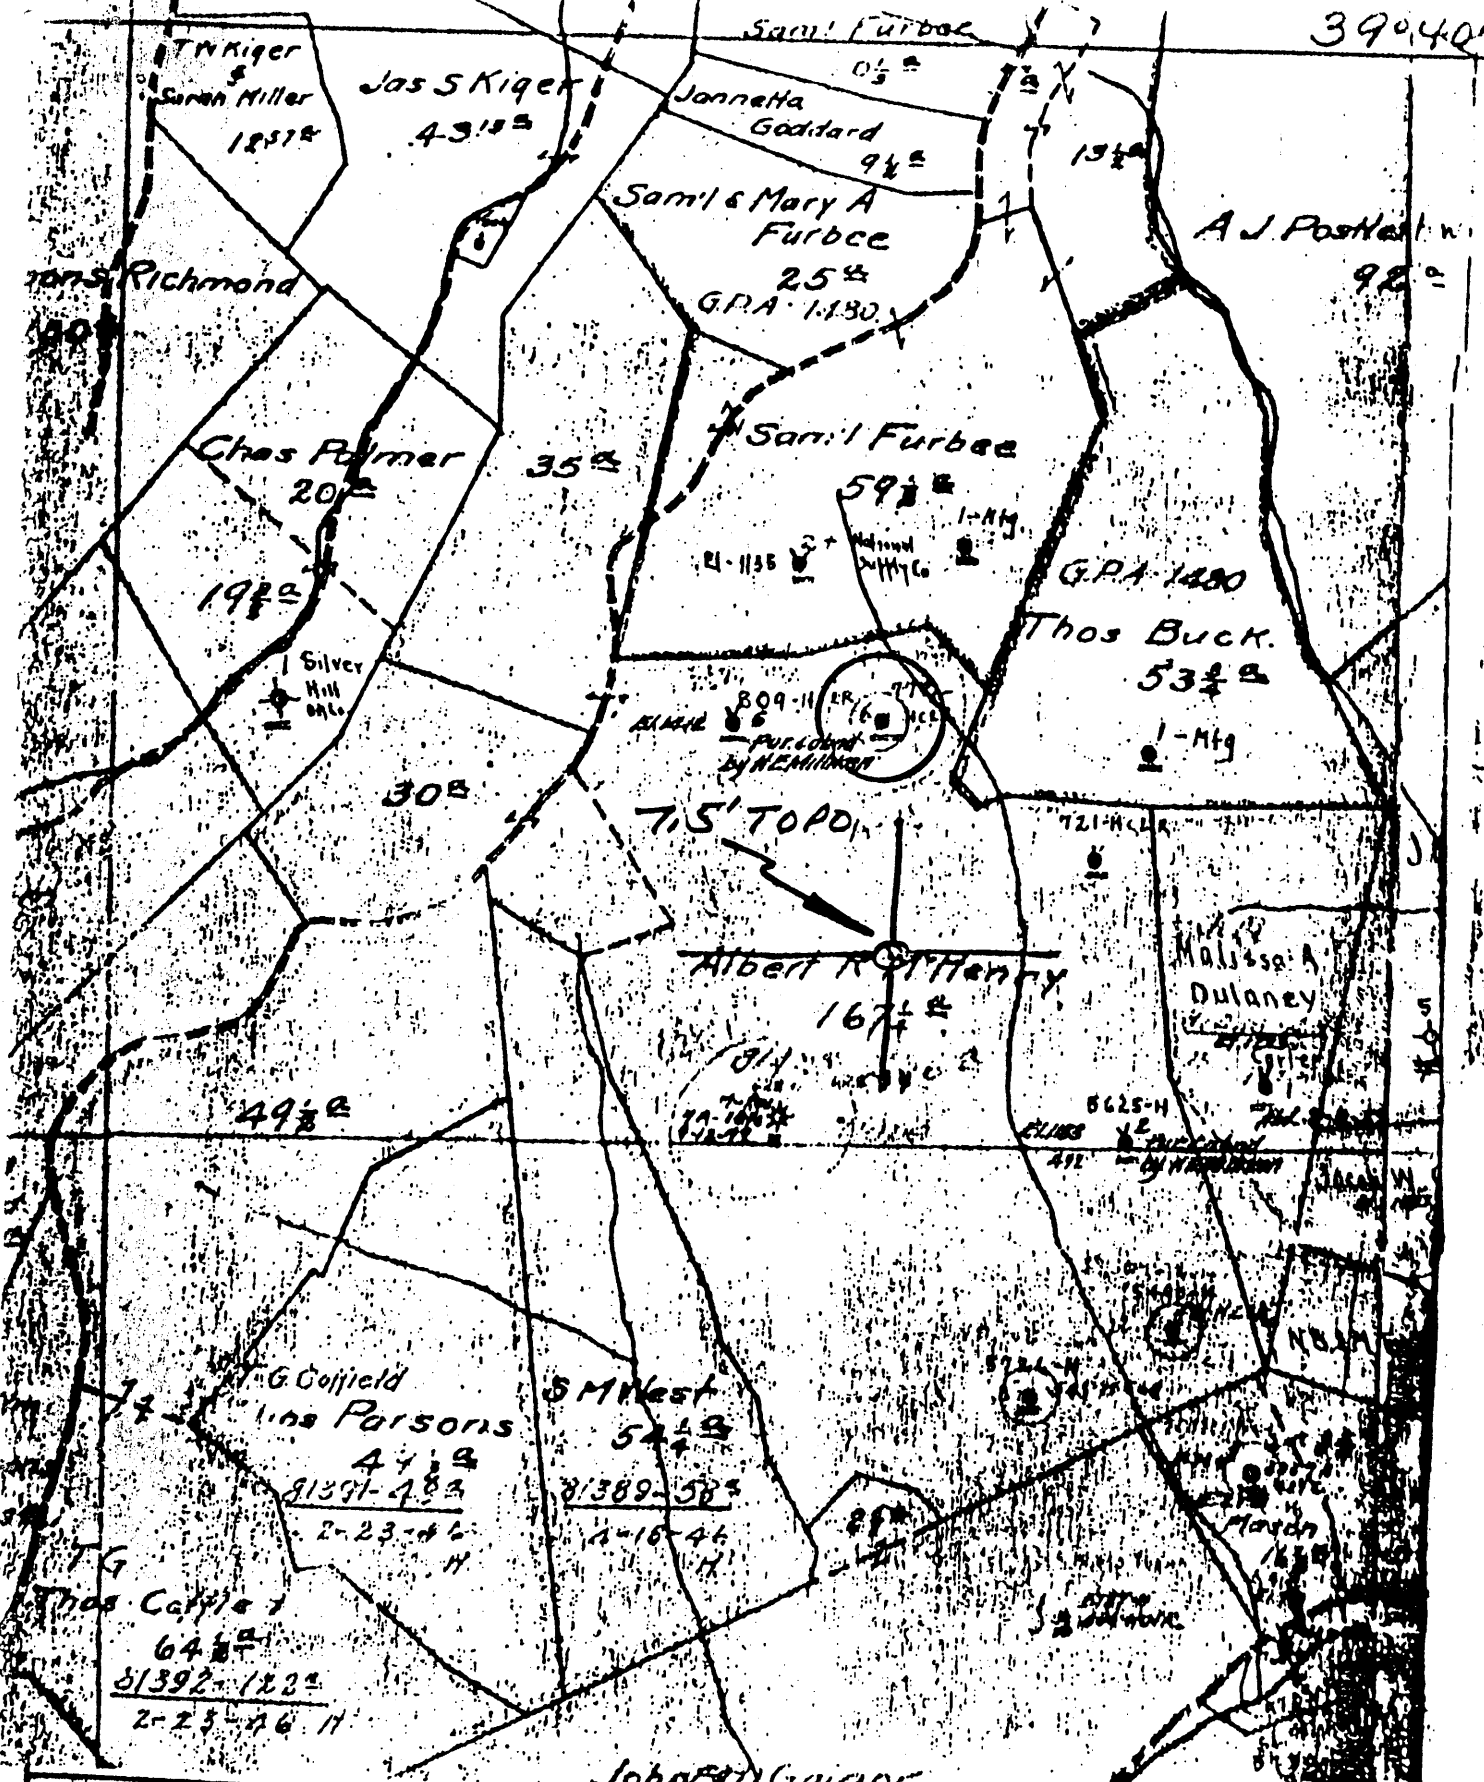

(+) DENOTES LOCATION OF WELL ON UNITED STATES TOPOGRAPHIC MAPS

FORM IV-6
(8-78)
N 77 N14 E4



DATE 1-5-, 1979
OPERATOR'S WELL NO. 6
API WELL NO. 47-103-0904
STATE COUNTY PERMIT

STATE OF WEST VIRGINIA
DEPARTMENT OF MINES
OIL AND GAS DIVISION

WELL TYPE: OIL GAS LIQUID INJECTION WASTE DISPOSAL
(IF "GAS", PRODUCTION STORAGE DEEP SHALLOW
LOCATION: ELEVATION _____ WATER SHED LITTLE FISHING CK
DISTRICT PROCTOR COUNTY WETZEL
QUADRANGLE WILLEYVILLE 7.5'
SURFACE OWNER _____
OIL & GAS ROYALTY OWNER _____ ACREAGE _____
LEASE NO. _____ LEASE ACREAGE _____
PROPOSED WORK: DRILL CONVERT DRILL DEEPER REDRILL FRACTURE OR
STIMULATE PLUS OFF OLD FORMATION PERFORATE NEW
FORMATION OTHER PHYSICAL CHANGE IN WELL (SPECIFY) _____

PLUS AND ABANDON CLEAN OUT AND REPLUG
TARGET FORMATION _____ ESTIMATED DEPTH _____
WELL OPERATOR Pennzoil Company DESIGNATED AGENT James A. Crowe
ADDRESS P. O. Box 1588 ADDRESS P. O. Box 1588
Parkersburg, WV 26101 Parkersburg, WV 26101

A.R. McHENRY

WILLIAM B. B. NAME of Mr. B. B.

PROJECT & LOCATION: *Electric*
 COMMENCED: *February 2, 1937*
 COMPLETED: *February 5, 1937*
 CONTRACTOR: *Electric Department of Co.*
 PURCHASED FROM: *Per Foot*
 DATE PURCHASED:
 DATE SHUT IN:
 DATE CONNECTED:
 DATE TUBING ON:
 DATE SURVEY/LOG:
 DATE DISCONNECTED:
 SOLD TO:
 DATE SOLD:
 DATE RE-PURCHASED:
 DATE PLUGGED:
 DATE ANALYZED:
 ESTIMATION: *APPROX 184 FEET*

RECORD

SYMBOL	DEPTH	DEPTH	THICKNESS	WATER AT	PERCENT (OR SAND)
Pittsburgh Coal	1000	1000			
Dunkard Sand	2000	2000			
Salt Sand	1770	1770			
Masson Sand	2150	2150			
Linton Sand	2000	2000			
Berry Sand	2100	2100			
Lease Sand	2100	2100			
Fifty foot sand	2000	2000			
Thirty foot sand	2100	2100			
Opal Sand	2000	2000			
Corbin Sand	2000	2000			
Peoria Sand	2000	2000			
Fish Sand	2000	2000			
Rayed Sand	2000	2000			
Spencer Sand	2000	2000			
Wash Sand	2000	2000			

SHOOTING

DATE	TIME	SAND	VALUE BEFORE	VALUE AFTER
1-26-37	10	London		
1-29-37	10	"		
1-26-37	10	"		

CASING AND TUBING

DEPTH	WT IN WELD	PELLED	COMMENTED
10 in. Casing	100.0		Per
20 in. Casing	200.5		Size tubing
24 in. Casing	200.11		Top
24 in. Tubing	200.11		Bottom
24 in. Casing	200.11		PL
24 in. Tubing	210.11		PL
24 in. Tubing	210.11		
24 in. Tubing	210.11		

VOLUME AND PRESSURE TESTS

DATE TAKEN	BEAD(S)	LIQUID	OPENING	INCHES THROUGH	1 MIN.	3 MIN.	10 MIN.	30 MIN.	ROCK	VOLUME	SAND	PACKERS
Feb 16 1936												
Feb 26 1937												

INITIAL OIL PRODUCTION

DATE	BARREL	BARREL
1-26-37	10	London
1-29-37	10	"
1-26-37	10	"