

WW-7
8-30-06



West Virginia Department of Environmental Protection
Office of Oil and Gas
WELL LOCATION FORM: GPS

API: 47-103-01041 WELL NO.: 7323

FARM NAME: I.D. MORGAN

RESPONSIBLE PARTY NAME: WEST VIRGINIA LAND RESOURCES INC.

COUNTY: WETZEL DISTRICT: GRANT

QUADRANGLE: BIG RUN W.VA

SURFACE OWNER: WALTER K. & CHRISTINIA L. EINSMINGER

ROYALTY OWNER: _____

UTM GPS NORTHING: 4,373,258 m 951 FT.

UTM GPS EASTING: 541,627 m GPS ELEVATION: 290 m


The Responsible Party named above has chosen to submit GPS coordinates in lieu of preparing a new well location plat for a plugging permit or assigned API number on the above well. The Office of Oil and Gas will not accept GPS coordinates that do not meet the following requirements:

1. Datum: NAD 1983, Zone: 17 North, Coordinate Units: meters, Altitude: height above mean sea level (MSL) – meters.
2. Accuracy to Datum – 3.05 meters
3. Data Collection Method:

Survey grade GPS _____ : Post Processed Differential _____
 Real-Time Differential _____
 Mapping Grade GPS X : Post Processed Differential X
 Real-Time Differential _____

4. Letter size copy of the topography map showing the well location.

I the undersigned, hereby certify this data is correct to the best of my knowledge and belief and shows all the information required by law and the regulations issued and prescribed by the Office of Oil and Gas.

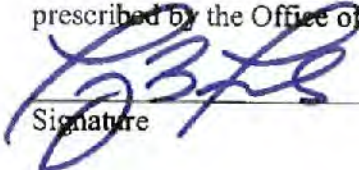
Signature

Professional Surveyor

Title

AUGUST 18, 2021

Date

10/01/2021



43°11'
32'30"
41°76'
41°75'
41°74'
41°73'00"N
39°30'
80°30'

439 32'30" 40 41

INTERNATIONAL GEODETIC SURVEY, RESTON, VIRGINIA - 1973
1:25000 E

1 MILE
7000 FEET
METER

ROAD CLASSIFICATION

- Heavy-duty
- Medium-duty
- Light-duty
- Unimproved dirt
- Slate Route

(WALLACE)
1962 N.W.M.

10/01/2021

BIG RUN, W. VA.

SE 1/4 LITTLETON 15' QUADRANGLE


Big Run, WV Scale: 1" = 2,370M; 810M; 2,000F; 1 M = 2,640'; 1" = 2,011M

47-103-01041P

Well# 7323

BIG RUN WV 7.5' Quad

Scale: 1" = 2000'

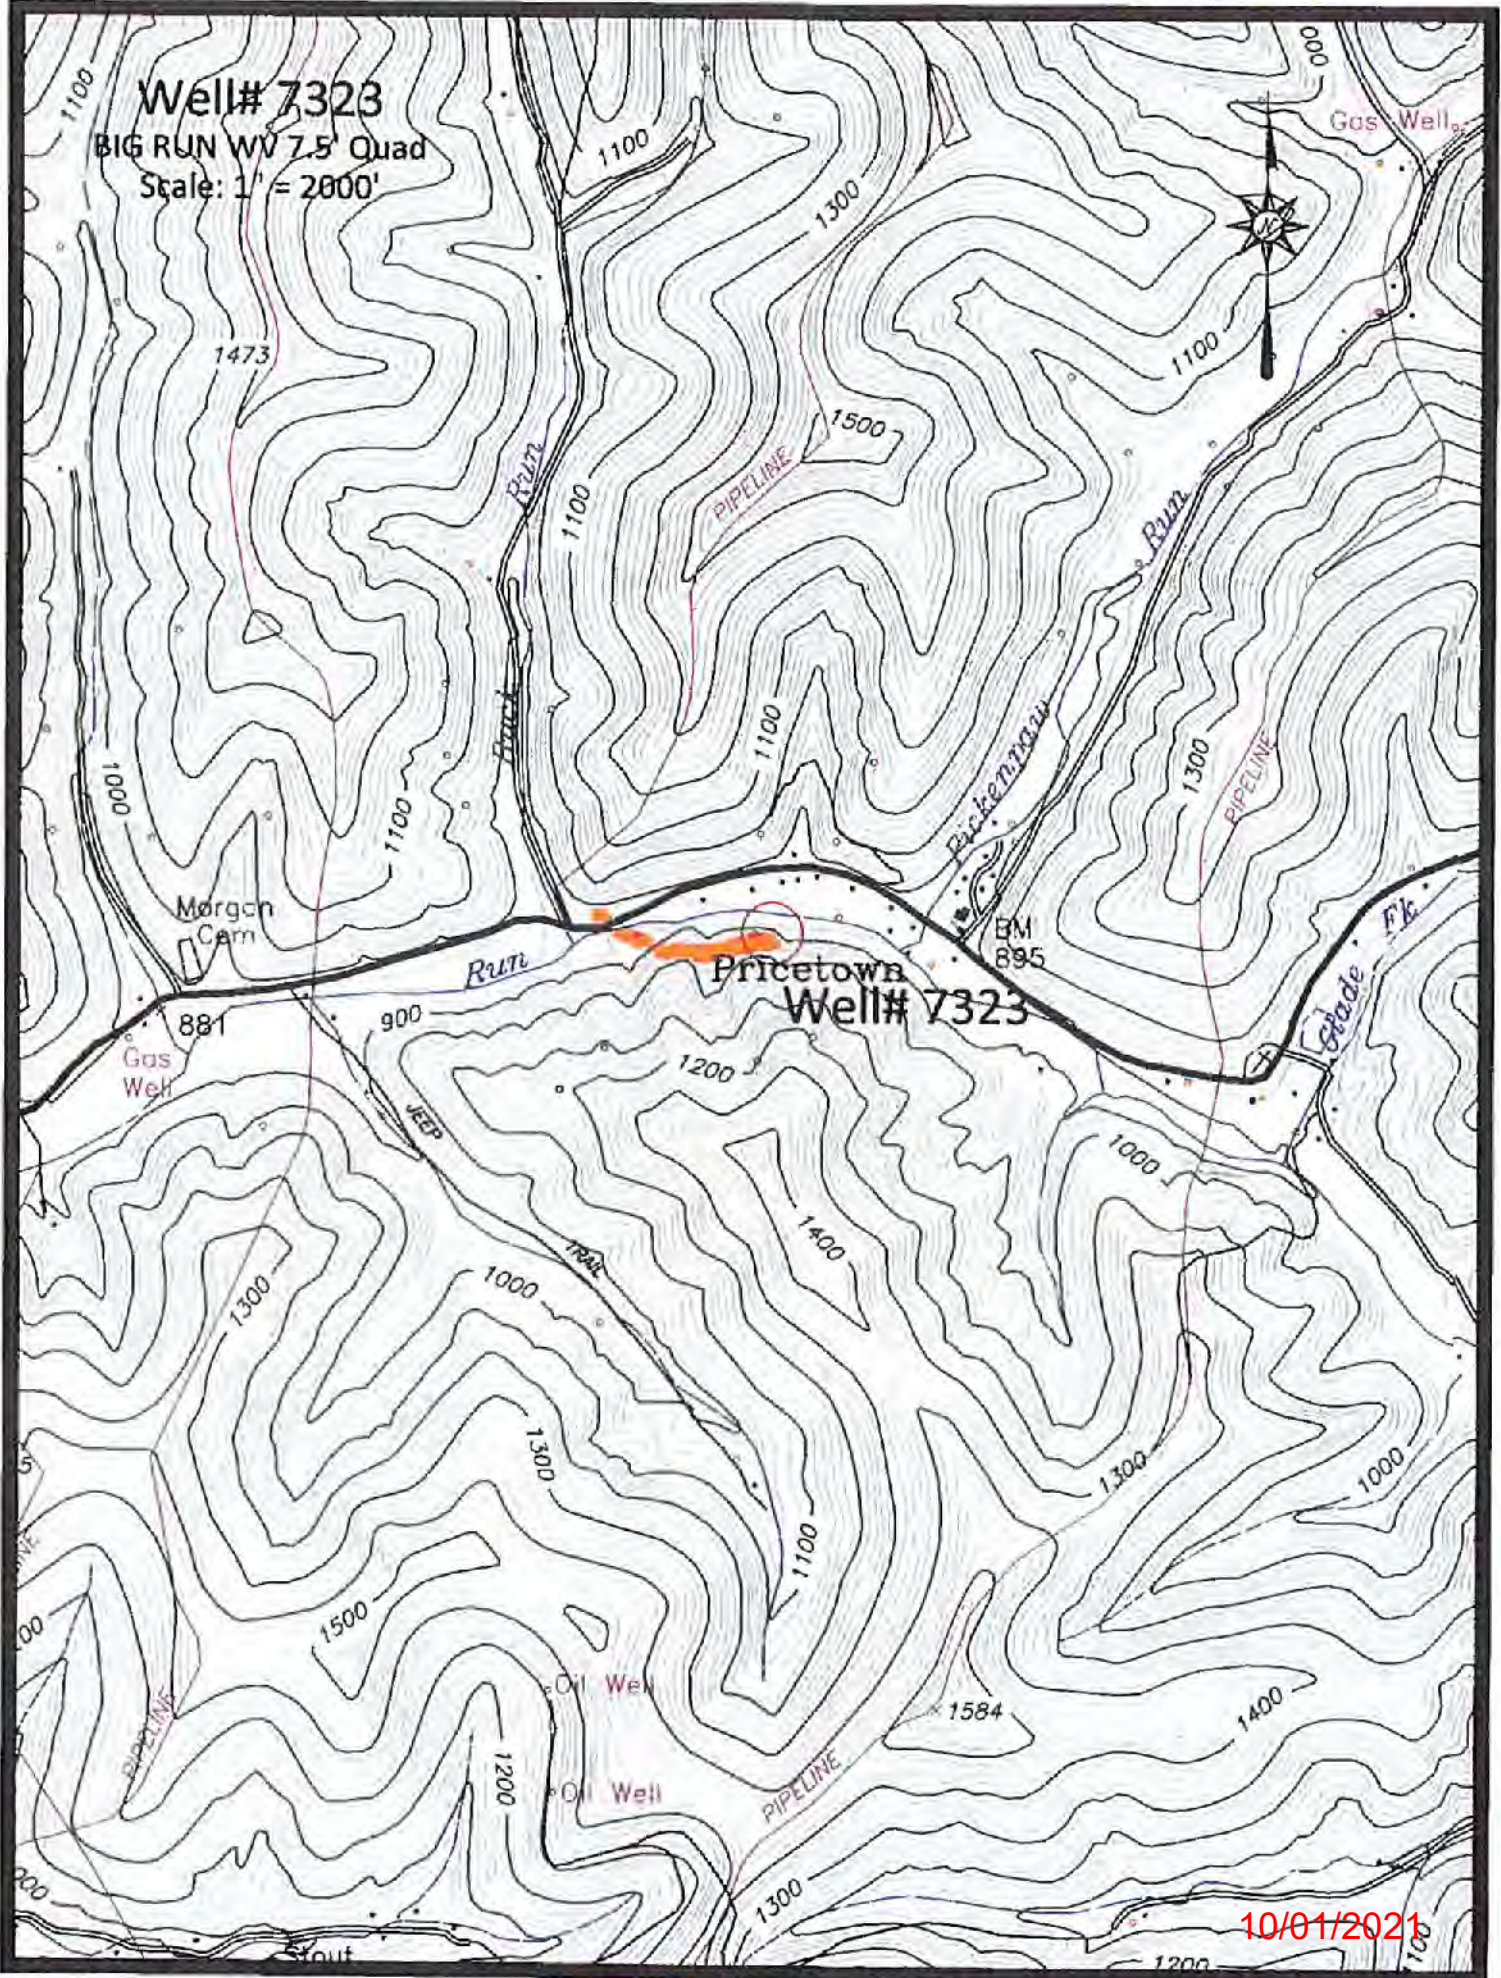

10/01/2021

km. -- R.

Well# 7323

BIG RUN WV 7.5' Quad

Scale: 1" = 500'



Buck

Picken Run

1100

BM
895

Pricetown

Well# 7323

1200

1400

1000

TRAIL

10/01/2021

House No. 1

