


LATITUDE 39° 40' 00"

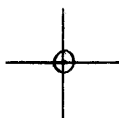

LONGITUDE 88° 03' 00"

7'5 OGIS topo location

7.5' LOC 0.18 S
1.68 W

15' LOC _____
(calc.) _____

Company _____

Farm _____

Quad LITRETON 7 1/2'


County WETZEL

District CLAY

WELL LOCATION MAP

File No. 103-1117

(24)

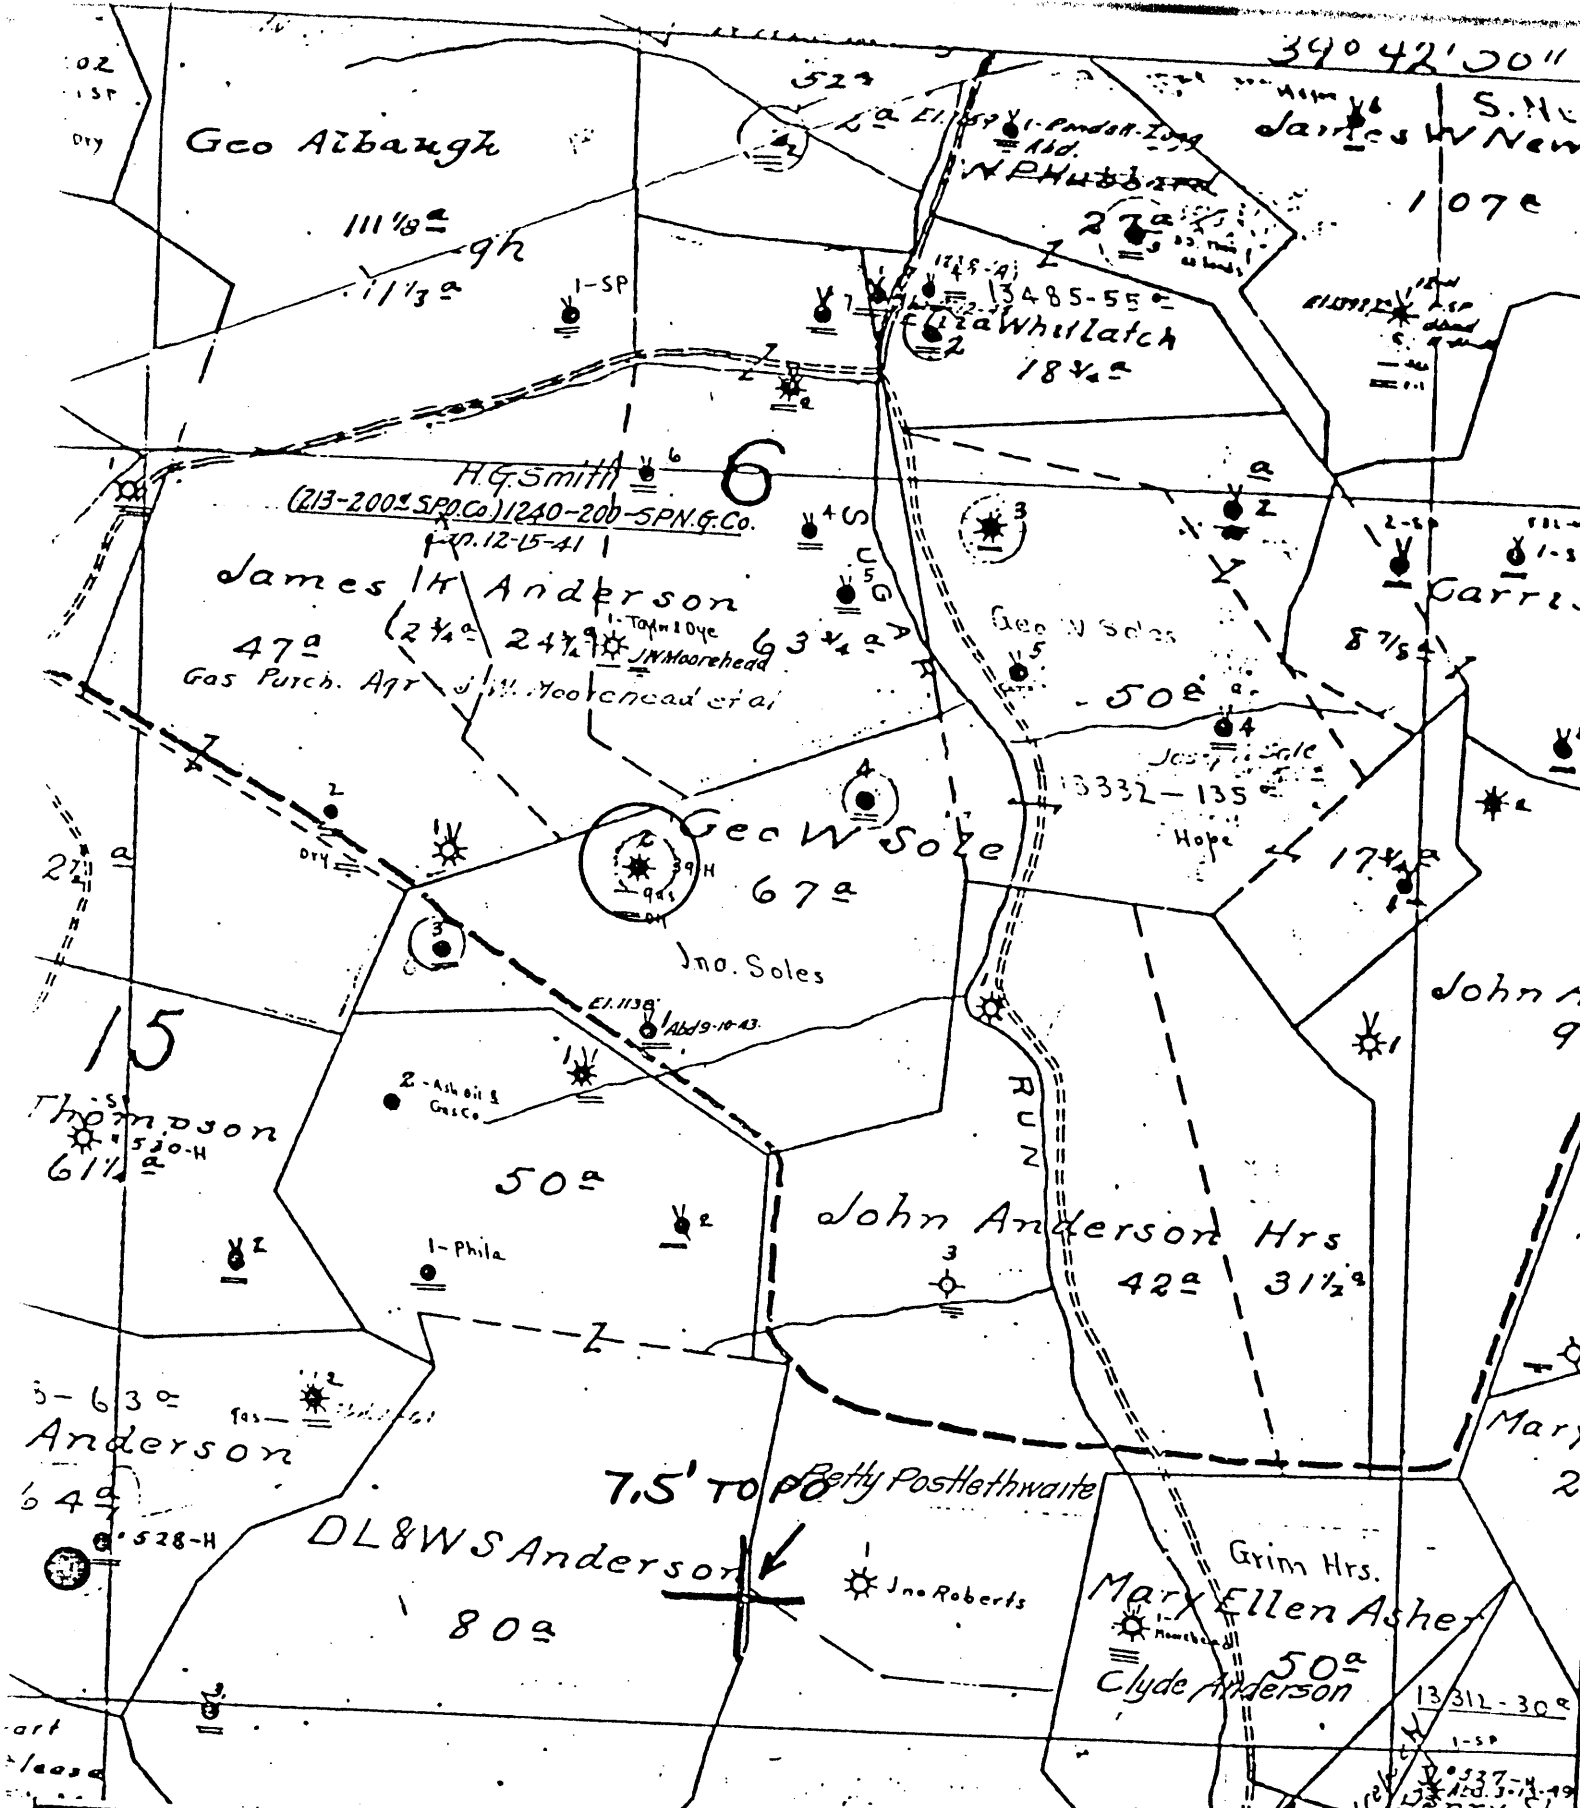

(+) DENOTES LOCATION OF WELL ON UNITED STATES TOPOGRAPHIC MAPS

FORM IV-6
(8-78)

N79 N16 E6



STATE OF WEST VIRGINIA
DEPARTMENT OF MINES
OIL AND GAS DIVISION

DATE Nov 30, 1978
OPERATOR'S WELL NO 2
API WELL NO. 47-103-1117
STATE COUNTY PERMIT

WELL TYPE: OIL GAS LIQUID INJECTION WASTE DISPOSAL
(IF "GAS", PRODUCTION STORAGE DEEP SHALLOW
LOCATION: ELEVATION WATER SHED Sugar Run COUNTY Wayne
DISTRICT Clay QUADRANGLE Littleton 7 1/2

SURFACE OWNER _____
OIL & GAS ROYALTY OWNER _____ ACREAGE _____
LEASE NO. 13332-50 LEASE ACREAGE 135

PROPOSED WORK: DRILL CONVERT DRILL DEEPER REDRILL FRACTURE OR STIMULATE PLUS OFF OLD FORMATION PERFORATE NEW FORMATION OTHER PHYSICAL CHANGE IN WELL (SPECIFY) _____

PLUS AND ABANDON CLEAN OUT AND REPLUG
TARGET FORMATION _____
WELL OPERATOR Pennzoil Company ESTIMATED DEPTH _____
ADDRESS P. O. box 1588 DESIGNATED AGENT James A. Crews
Parkersburg, WV 26101 ADDRESS P. O. Box 1588
Parkersburg, WV 26101

JOHN SOLES - 2

Farm.

Well No. 394 W. State

Lease No. Fairy District Well

County W.Va.

Rig built by O.W. B. B.

Contractor.

Well drilled by H. B. Bonds

Began drilling Sept 25 1904 Completed Jan 10 1905

ROCK FORMATION

TOP.

BOTTOM.

REMARKS.

Very fine

shaly

London

Oil

4 1/2

5 1/2

sand

"

Des 1904 Shot in by 250 230 7

London 3107 3170

3188 3200

3214 3220

3246 3251

3177 3155

3210

4 1/2" shale 16 gals

4 1/4" " 1 30 "

Quicker 22 gals

334b

Depth

OSASINO RECORD.

CHARGED TO WELL

PUT IN WELL

PULLED OUT

LEFT IN WELL

Transferred by

Left at Well

Not in Use

5 1/2

2745 6

2745 6

Well No. 4 W. State

Lease No. Fairy District Well

County W.Va.

Rig built by H. B. Bonds

Contractor.

Well drilled by H. B. Bonds

Began drilling Sept 25 1904 Completed Jan 10 1905

ROCK FORMATION

TOP.

BOTTOM.

REMARKS.

Very fine

shaly

London

Oil

4 1/2

5 1/2

sand

"

Des 1904 Shot in by 250 230 7

London 3107 3170

3188 3200

3214 3220

3246 3251

3177 3155

3210

4 1/2" shale 16 gals

4 1/4" " 1 30 "

Quicker 22 gals

334b

Depth

OSASINO RECORD.

CHARGED TO WELL

PUT IN WELL

PULLED OUT

LEFT IN WELL

Transferred by

Left at Well

Not in Use

5 1/2

2745 6

2748 6

Shot 11/9/05 - 80 gal. B. Bonds

103-1117