

WW-7
8-30-06



West Virginia Department of Environmental Protection
Office of Oil and Gas
WELL LOCATION FORM: GPS

API: 47-103-01335 WELL NO.: 8042
 FARM NAME: ALICE EDGELL
 RESPONSIBLE PARTY NAME: WEST VIRGINIA LAND RESOURCES INC.
 COUNTY: WETZEL DISTRICT: CHURCH
 QUADRANGLE: HUNDRED W.VA, PA
 SURFACE OWNER: MARGARET EDGELL / STEPHEN SHOWALTER
 ROYALTY OWNER: _____
 UTM GPS NORTHING: 4,388,999 m (1207')
 UTM GPS EASTING: 549,102 m GPS ELEVATION: 368 m

The Responsible Party named above has chosen to submit GPS coordinates in lieu of preparing a new well location plat for a plugging permit or assigned API number on the above well. The Office of Oil and Gas will not accept GPS coordinates that do not meet the following requirements:

- Datum: NAD 1983, Zone: 17 North, Coordinate Units: meters, Altitude: height above mean sea level (MSL) – meters.
- Accuracy to Datum – 3.05 meters
- Data Collection Method:

Survey grade GPS _____: Post Processed Differential _____

Real-Time Differential _____

Mapping Grade GPS X: Post Processed Differential X

Real-Time Differential _____

- Letter size copy of the topography map showing the well location.**

I the undersigned, hereby certify this data is correct to the best of my knowledge and belief and shows all the information required by law and the regulations issued and prescribed by the Office of Oil and Gas.

Signature

Professional Surveyor

MAY 24, 2023

Title

Date

RECEIVED
Office of Oil and Gas

JUN 07 2023

WV Department of
Environmental Protection


07/21/2023

4710301335



46 2730' 47 48 (GLOVERGAP) 49 GLOVERGAP 15 MI FAIRMONT 23 1 250 000 FEET (F

SCALE 1:24 000

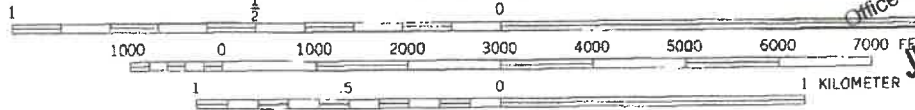

CONTOUR INTERVAL 20 FEET
NATIONAL GEODETIC VERTICAL DATUM OF 1929

RECEIVED
Office of Oil and Gas
JUN 07 2023

WV Department of
Environmental Protection

22'
MIL S

'Hundred' WV PA' Scale: 1" = 0.270MI; 610M; 2.000E; 1.1E = 0.640" 1.1E = 0.610M

07/21/2023

W VA