

INSTRUCTIONS

20
2
08

1) Attach a photo copy of the location of the well on a 7.5 minute Quadrangle with the corresponding Longitude and Latitude.
 2) Designate the location of the well with the symbol(+).

+ 0.865
1.930

I, the undersigned, Hereby certify that this plat is correct to the best of my knowledge and belief.

SIGNED Daryl L. Perkins
 TITLE V. Pres.

3.74S
4.15W

DATE June 22, 19 90
 OPERATORS WELL NO. Garner #1
 API WELL NO. 103-1486

STATE OF WEST VIRGINIA
 DEPARTMENT OF ENERGY
 OIL AND GAS DIVISION

WELL TYPE: OIL GAS LIQUID INJECTION WASTE DISPOSAL
 (if "GAS" PRODUCTION STORAGE DEEP SHALLOW

LOCATION: ELEVATION unknown WATER SHED _____
 DISTRICT Proctor COUNTY Wetzel
 QUADRANGLE Wileyville - Littleton

SURFACE OWNER Garner Heirs ACREAGE 1496
 OIL & GAS ROYALTY OWNER Garner Heirs LEASE ACREAGE 1496
 LEASE NO. _____

PRODUCING FORMATION Gordon TOTAL DEPTH 2878


WELL OPERATOR PERKINS OIL AND GAS, INC. DESIGNATED AGENT Daryl Perkins
 ADDRESS Rt. 2, Box 214 ADDRESS Rt 2 Box 214
Pennsboro, WV 26415 Pennsboro, WV

26415

Wileyville 4

Wileyville Quadrangle

New Martinsville Quadrangle

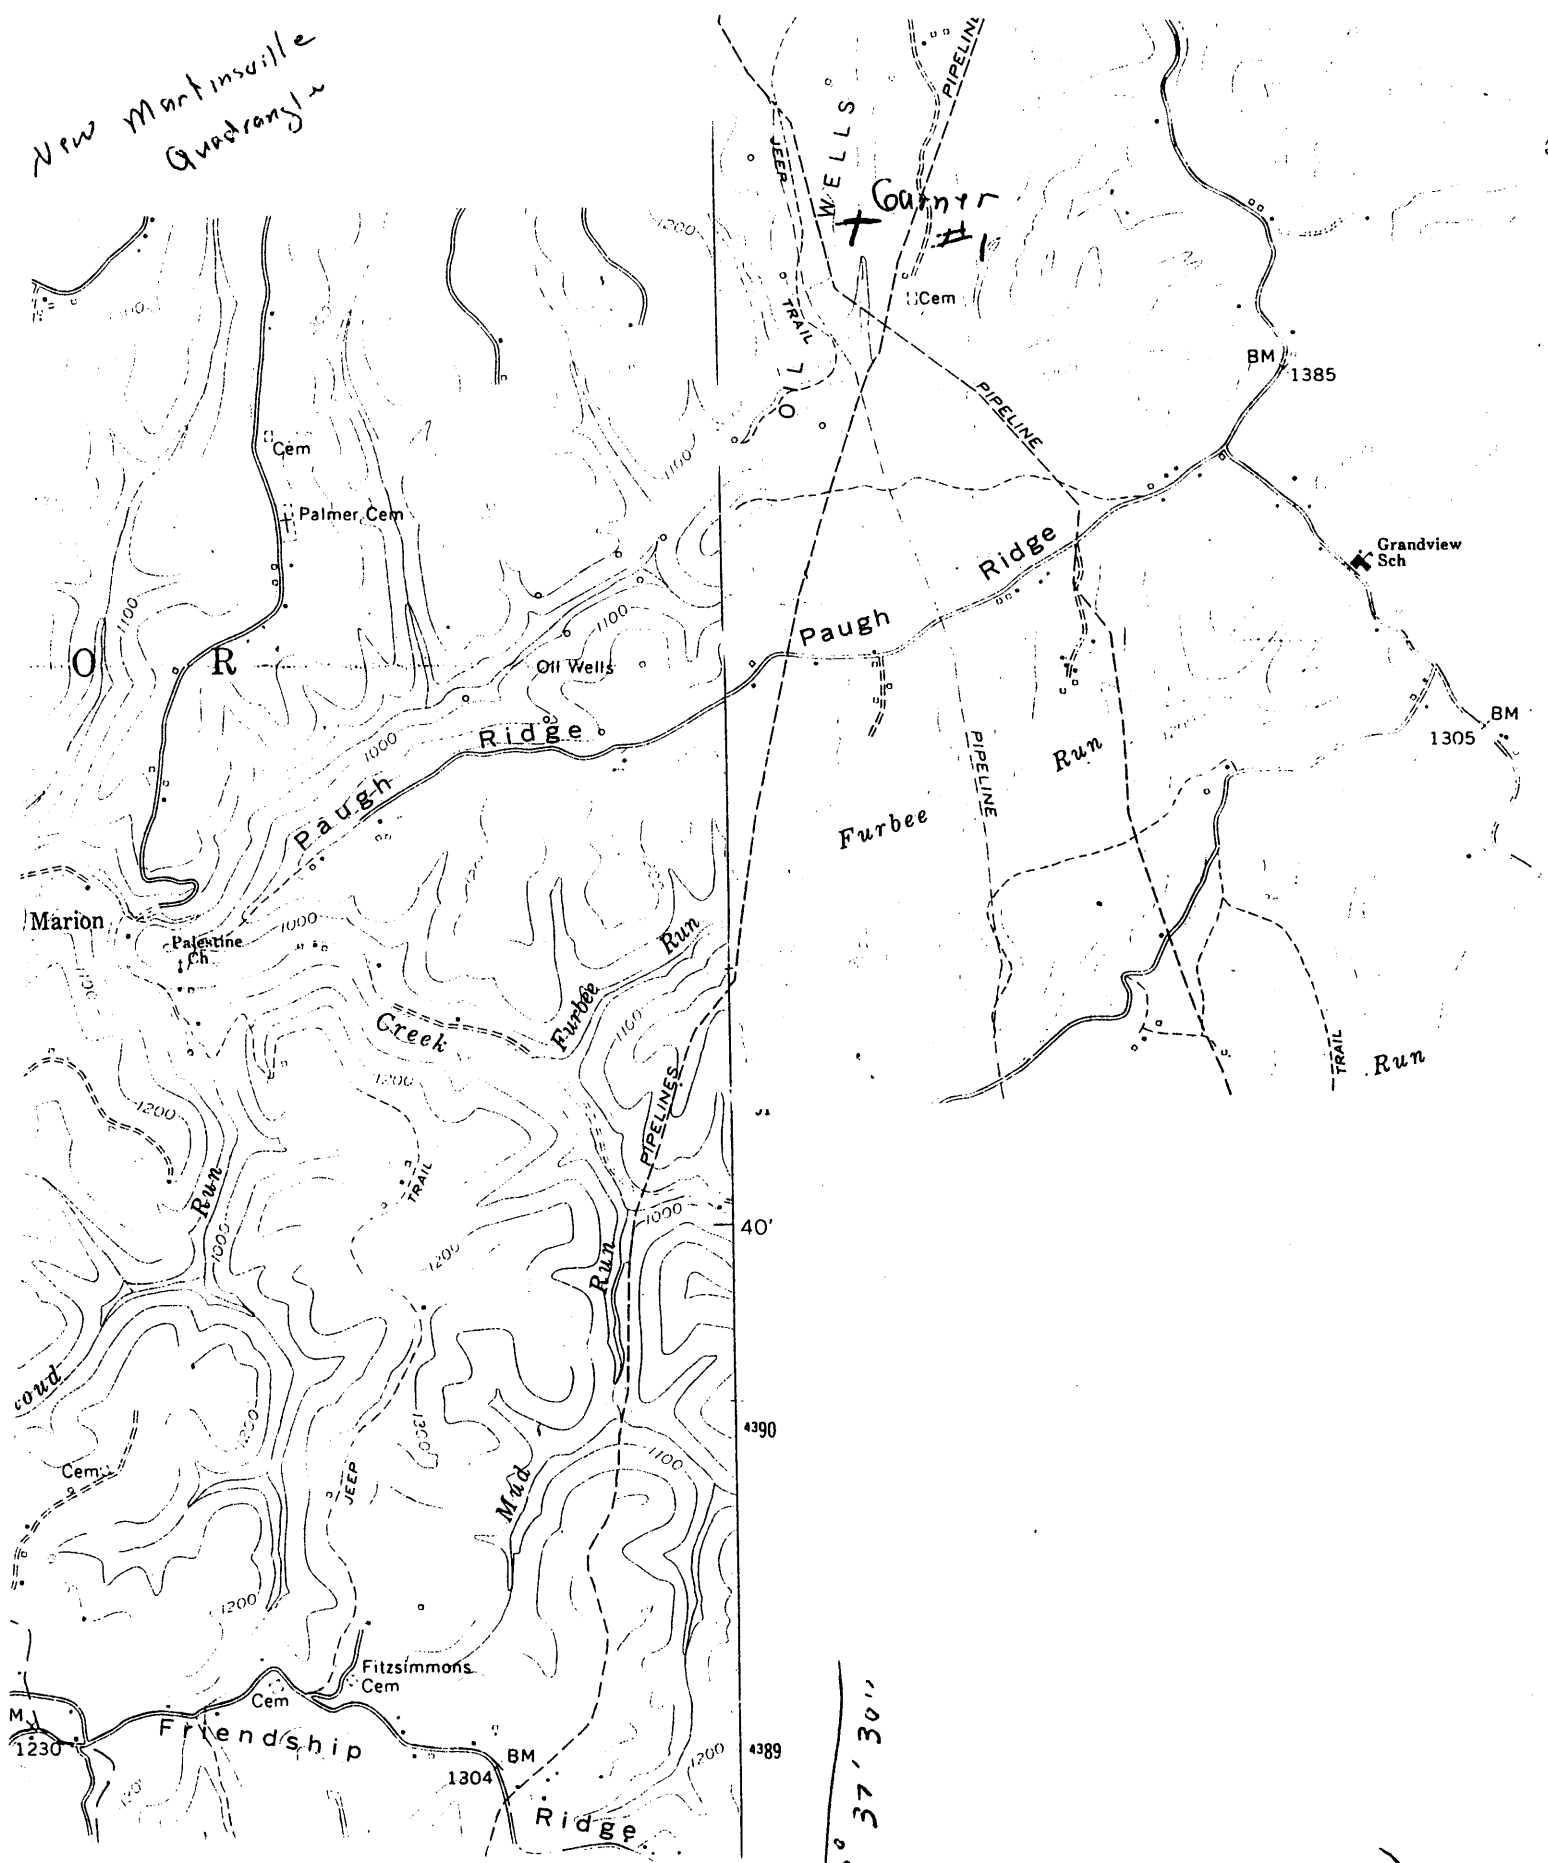

80° 45' 39" 37' 30" ↓ (Pine Grove 4863 1150)

MAR 16 1962