

INSTRUCTIONS

- 1) Attach a photo copy of the location of the well on a 7.5 minute Quadrangle with the corresponding Longitude and Latitude.
- 2) Designate the location of the well with the symbol(+).

+ 0.78
245

80 42 30

I, the undersigned, Hereby certify that this plat is correct to the best of my knowledge and belief.

SIGNED Daryl L. Perkins
TITLE U. Pres.

DATE June 22, 19 90
OPERATORS WELL NO. Garner #16
API WELL NO. 103-1488

STATE OF WEST VIRGINIA
DEPARTMENT OF ENERGY
OIL AND GAS DIVISION

70081?

WELL TYPE: OIL GAS LIQUID INJECTION WASTE DISPOSAL
(if "GAS" PRODUCTION STORAGE DEEP SHALLOW

LOCATION: ELEVATION unknown WATER SHED _____
DISTRICT Proctor COUNTY Wetzel
QUADRANGLE Wiltzville

SURFACE OWNER Garner Heirs ACREAGE 149.6
OIL & GAS ROYALTY OWNER _____ LEASE ACREAGE 149.6
LEASE NO. _____

PRODUCING FORMATION _____ TOTAL DEPTH 2970 +/-


WELL OPERATOR PERKINS OIL AND GAS, INC. DESIGNATED AGENT Daryl L. Perkins
ADDRESS Rt. 2, Box 214 ADDRESS _____
Pennsboro, WV 26415

JUN 20 1990

Wiltzville 4

Wileyville Quadrangle

New Martinsville Quadrangle

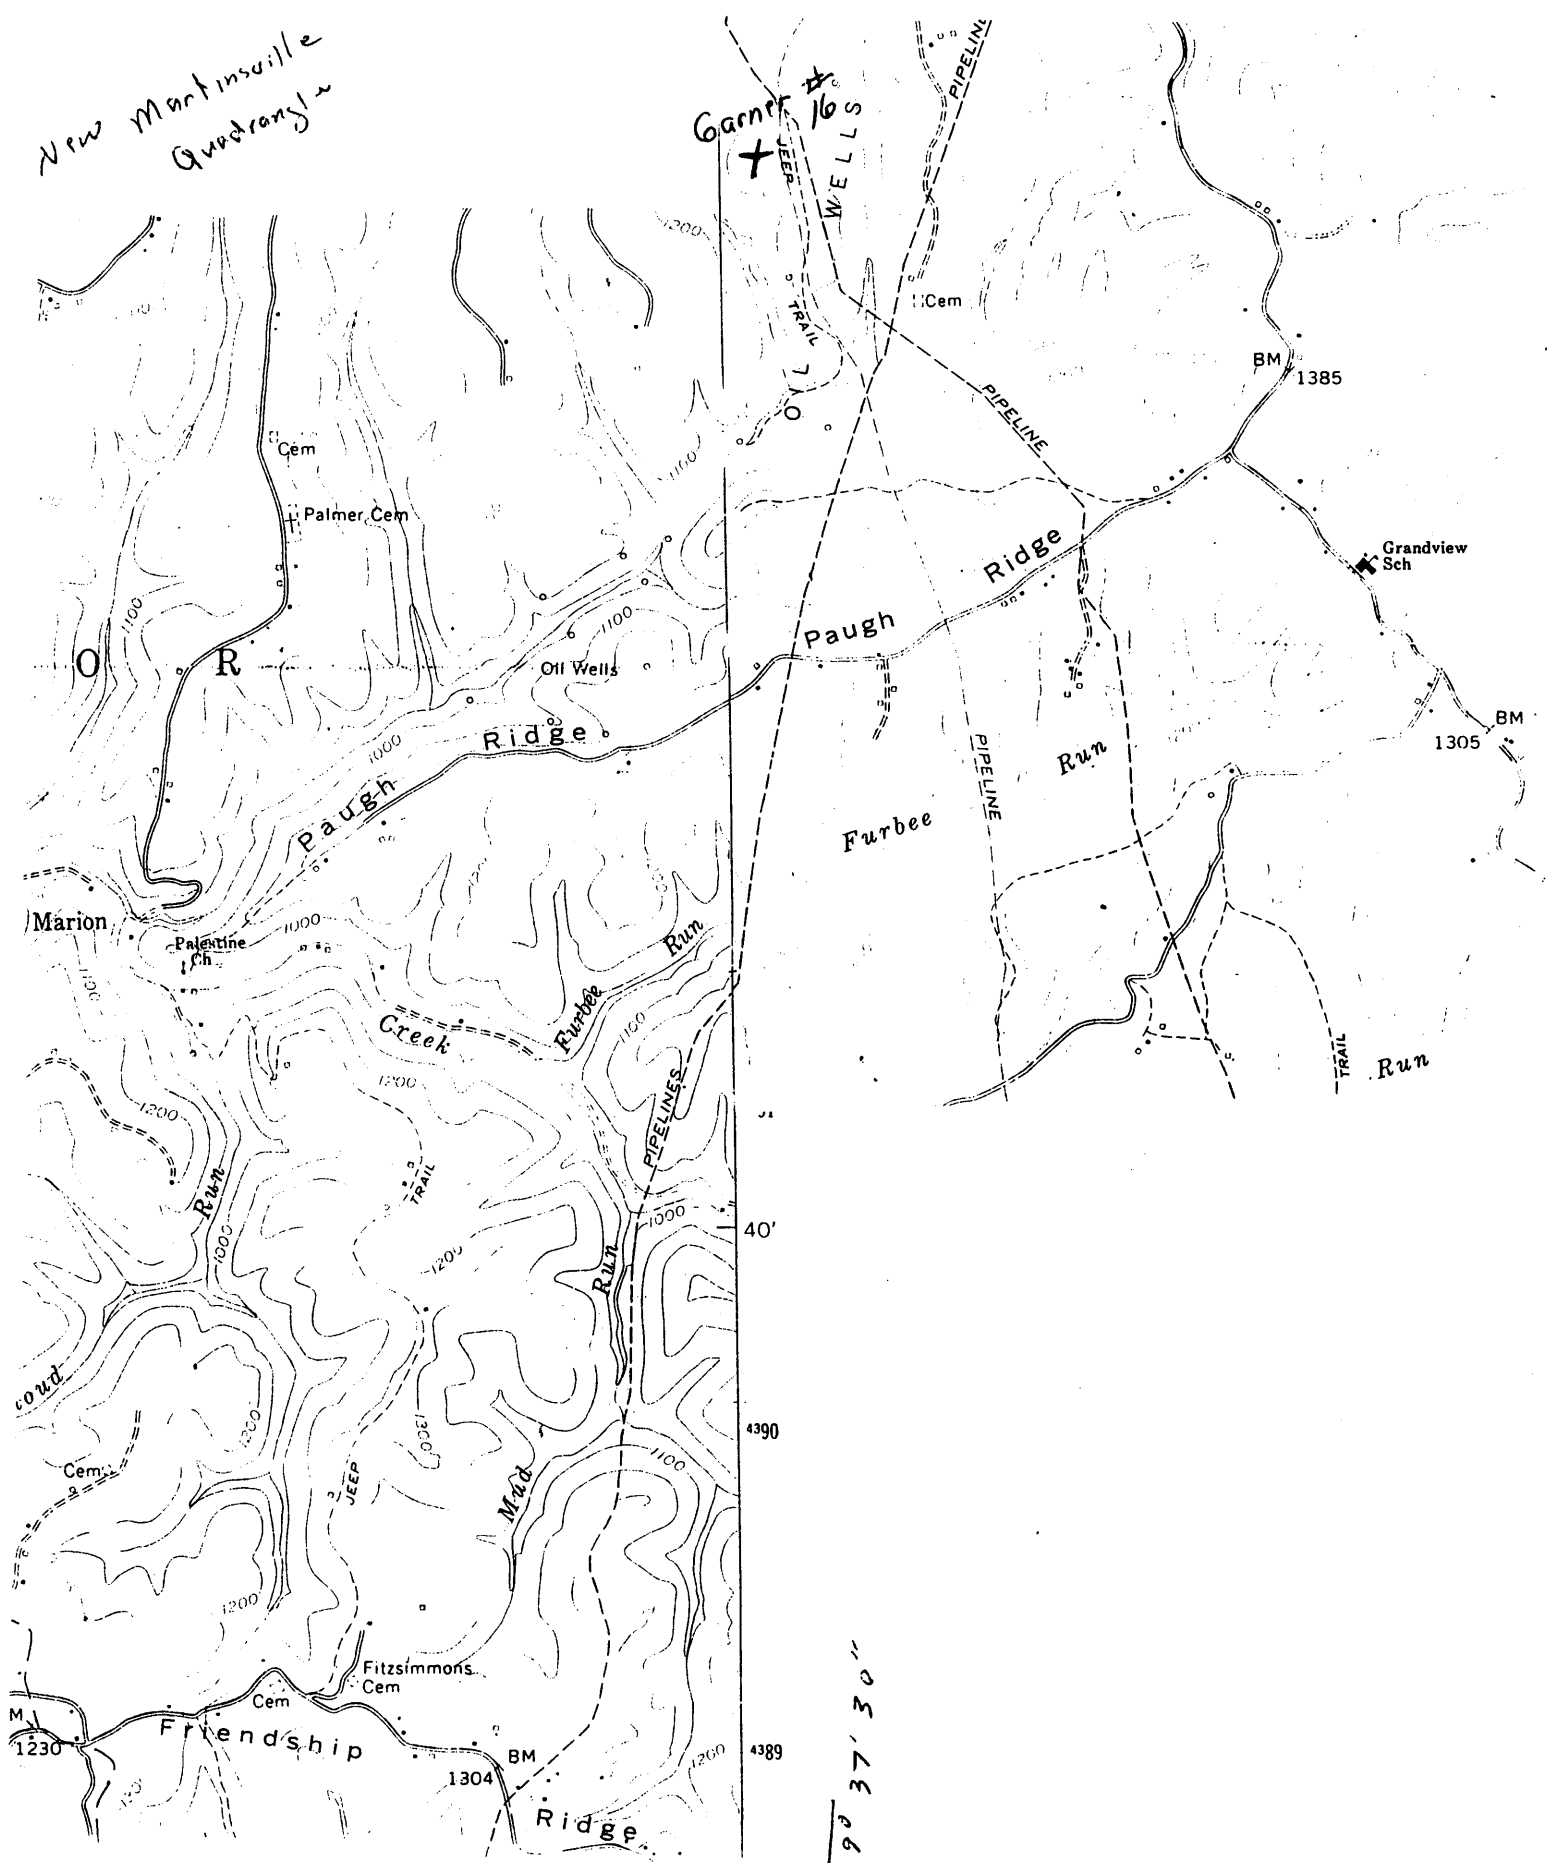

Garner #16
WELLS

80° 45' (Pine Grove) 4863 1/4 SW ↘
 390 37' 30"

MAR 16 1982