


1) Attach a photo copy of the location of the well on a 7.5 minute Quadrangle with the corresponding longitude and Latitude.  
 2) Designate the location of the well with the symbol (+).

MAP Ref.  $39^{\circ} 42' 30''$   
 WV. New Martinsville, (6) N.E.  
 QUADRANGLE - (304)  
 7.5' Tick

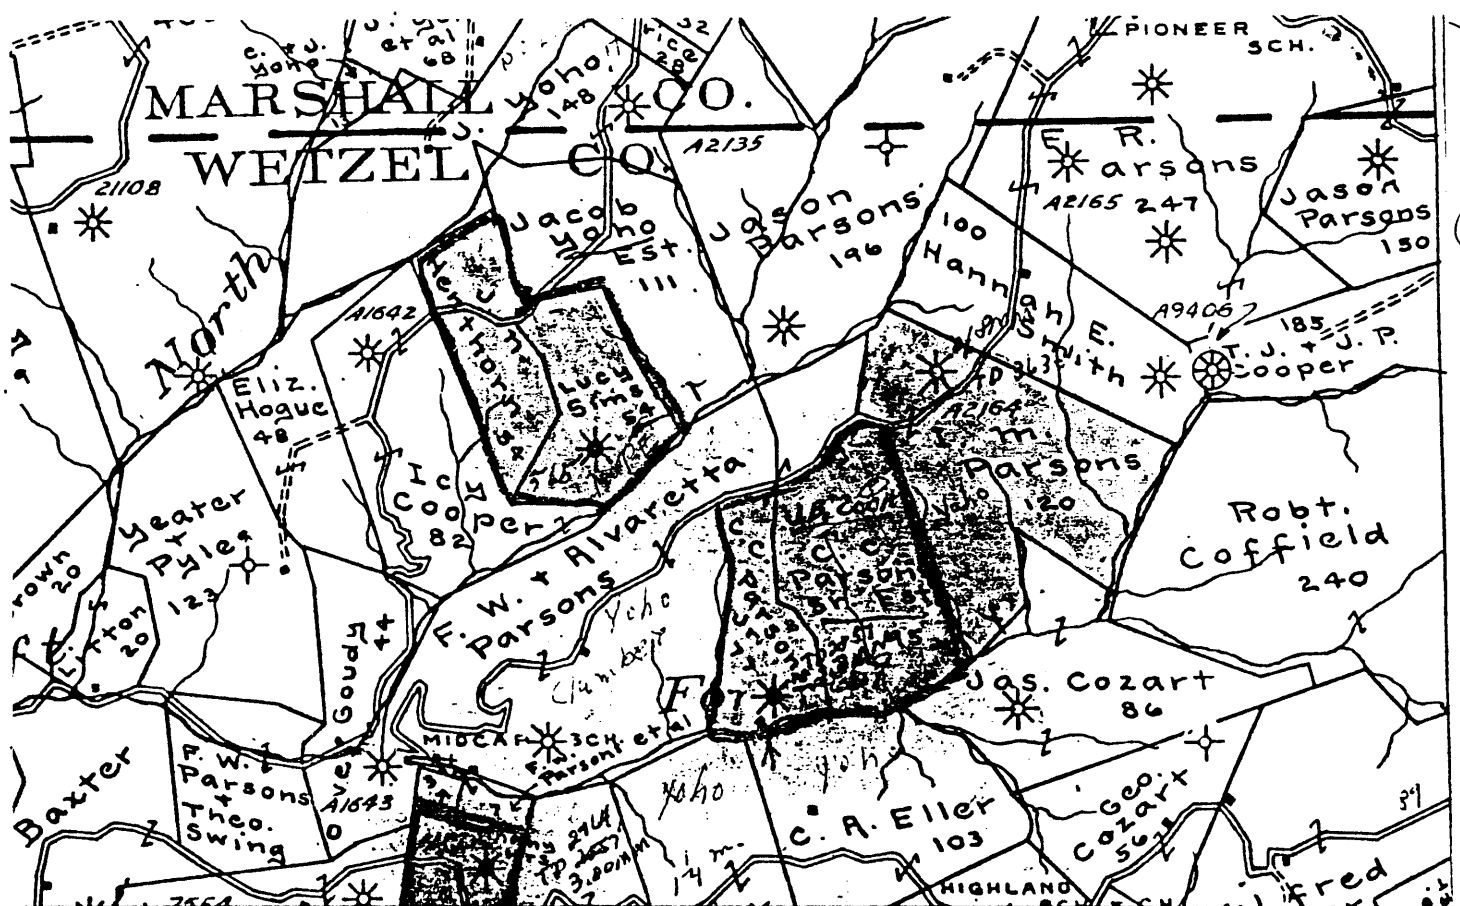

I, the undersigned, hereby certify that this plat is correct to the best of my knowledge and belief.

SIGNED Richard E. Goble  
 TITLE President

Well Name - MARIA PARSON

DATE 1/8, 1992

OPERATORS WELL NO. \_\_\_\_\_

API WELL NO. 103-1556-N

**RECEIVED**  
 WV Dept. of Environmental Protection  
 JAN 26 93  
 Permitting  
 Office of Oil & Gas

STATE OF WEST VIRGINIA  
 DEPARTMENT OF ENERGY  
 OIL AND GAS DIVISION

TYPE: OIL \_\_\_\_\_ GAS  LIQUID INJECTION \_\_\_\_\_ WASTE DISPOSAL \_\_\_\_\_  
 AS" PRODUCTION  STORAGE \_\_\_\_\_ DEEP \_\_\_\_\_ SHALLOW \_\_\_\_\_

LOCATION: ELEVATION 1060 WATER SHED \_\_\_\_\_  
 DISTRICT Procter COUNTY Wetzel  
 QUADRANGLE New Martinsville

FACE OWNER \_\_\_\_\_ ACREAGE \_\_\_\_\_  
 & GAS ROYALTY OWNER \_\_\_\_\_ LEASE ACREAGE 102 120  
 LEASE NO. \_\_\_\_\_

PRODUCING FORMATION \_\_\_\_\_ 19970 TOTAL DEPTH 2875


OPERATOR Greystone Oil Co. DESIGNATED AGENT John Lavelle  
 ADDRESS R.D.#1 Box 267 ADDRESS RD 1 Box 72  
New Freeport, PA 15352 Knob Fork, WV 26579  
New Martinsville 6

18238

80-45

Latitude

39°47' 30"

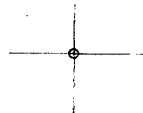

70°45'

Longitude

Topo Location

7.5' Loc. 0.215 15' Loc. \_\_\_\_\_  
1,30W (calc.) \_\_\_\_\_

Company Greentidge Oil Co

Farm Marla Parsons #659

15' Quad New Martinsville  
(sec.)

7.5' Quad New Martinsville

District Roctor

WELL LOCATION PLAT

County 103 Permit 1556-N