

STATE OF WEST VIRGINIA
DIVISION OF ENVIRONMENTAL PROTECTION
SECTION OF OIL AND GAS

WELL REGISTER ASSIGNMENT

This API Number 47-103-01564, issued to CHELSEA OIL & GAS, INC is evidence of permission to operate the well that is referenced at the location described on the attached plat, subject to the provisions of Chapters 22 and 22B of the West Virginia Code of 1931, as amended, and all rules and regulations promulgated thereunder. The name and telephone number of the Oil and Gas Inspector for this well is RANDAL MICK -
304-986-3324.

Spills or emergency discharges must be reported to 1-800-654-3312.

Failure to abide by all statutory and regulatory provisions governing all duties and operations hereunder may result in suspension or revocation of your permits and in addition may result in civil and/or criminal penalties.

The enclosed WR-35 must be completed by you and returned to this office. In addition annual production reports must be submitted on this well and failure to do so may require you to plug the well.

Theodore M. Streit
Chief

By:  _____

Title: _____

Operator's Well No: 4

Farm Name: MAIN, S.


API Well Number : 47-103-01564 N

Date Issued : 01/27/94

750' 39° 42' 30"

1) Attach a photo copy of the location of the well on a 7.5 minute Quadrangle with the corresponding Longitude and Latitude.
 2) Designate the location of the well with the symbol(+).

LATITUDE 39° 42' 15" 75' Tick
 LONGITUDE 80° 25' 10" 11
 0.28S
 014W
 152 008
 800 250

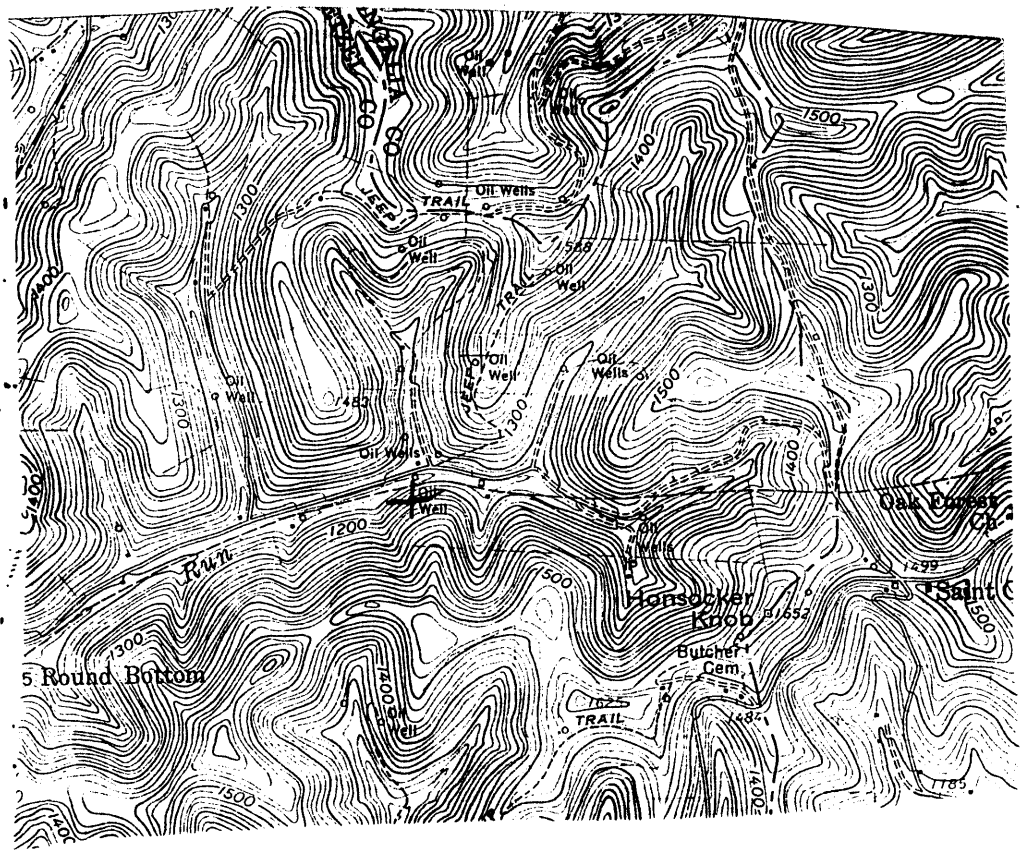

I, the undersigned, hereby certify that this plat is correct to the best of my knowledge and belief.

SIGNED [Signature]
 TITLE VICE-PRESIDENT

DATE MARCH 15, 1993
 OPERATORS WELL NO. #4
 API WELL NO. 103-1564-N

STATE OF WEST VIRGINIA
 DEPARTMENT OF ENERGY
 OIL AND GAS DIVISION

WELL TYPE: OIL GAS LIQUID INJECTION _____ WASTE DISPOSAL _____
 (IE "GAS" PRODUCTION STORAGE _____ DEEP _____ SHALLOW)

LOCATION: ELEVATION 1200 WATER SHED CARPO RUN
 DISTRICT CHURCH COUNTY WETZEL
 QUADRANGLE HUNDRED

SURFACE OWNER S. MAIN ACREAGE _____
 OIL & GAS ROYALTY OWNER _____ LEASE ACREAGE _____
 LEASE NO. _____

PRODUCING FORMATION STRAT & 4th SAND TOTAL DEPTH 3118

WELL OPERATOR CHELSEA OIL & GAS CO. INC DESIGNATED AGENT AL ANDERSON
 ADDRESS ~~115~~ BOX 1145 ADDRESS 901 WEST MAIN
BRIDGEPORT WV 26330 BRIDGEPORT WV 26330
Section 5

16999