

WW-7
8-30-06



West Virginia Department of Environmental Protection
Office of Oil and Gas
WELL LOCATION FORM: GPS

API: 47-103-01579 WELL NO.: 7294

FARM NAME: B. W. PETERSON

RESPONSIBLE PARTY NAME: WEST VIRGINIA LAND RESOURCES INC.

COUNTY: WETZEL DISTRICT: GRANT

QUADRANGLE: BIG RUN W.VA

SURFACE OWNER: MICHAEL A. BAKER SR.

ROYALTY OWNER: _____

UTM GPS NORTHING: 4,373,482 m

UTM GPS EASTING: 540,387 m GPS ELEVATION: 340 m (4115')

The Responsible Party named above has chosen to submit GPS coordinates in lieu of preparing a new well location plat for a plugging permit or assigned API number on the above well. The Office of Oil and Gas will not accept GPS coordinates that do not meet the following requirements:

1. Datum: NAD 1983, Zone: 17 North, Coordinate Units: meters, Altitude: height above mean sea level (MSL) – meters.
2. Accuracy to Datum – 3.05 meters
3. Data Collection Method:

Survey grade GPS _____ : Post Processed Differential _____


Real-Time Differential _____

Mapping Grade GPS X : Post Processed Differential X

Real-Time Differential _____

4. **Letter size copy of the topography map showing the well location.**


I the undersigned, hereby certify this data is correct to the best of my knowledge and belief and shows all the information required by law and the regulations issued and prescribed by the Office of Oil and Gas.

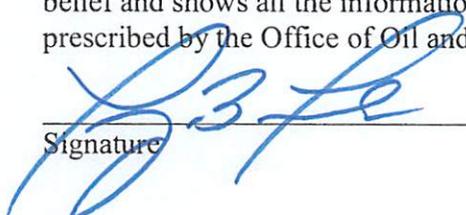
Signature

Professional Surveyor
Title

OCTOBER 10, 2021
Date

RECEIVED
Office of Oil and Gas
DEC 01 2021
WV Department of
Environmental Protection

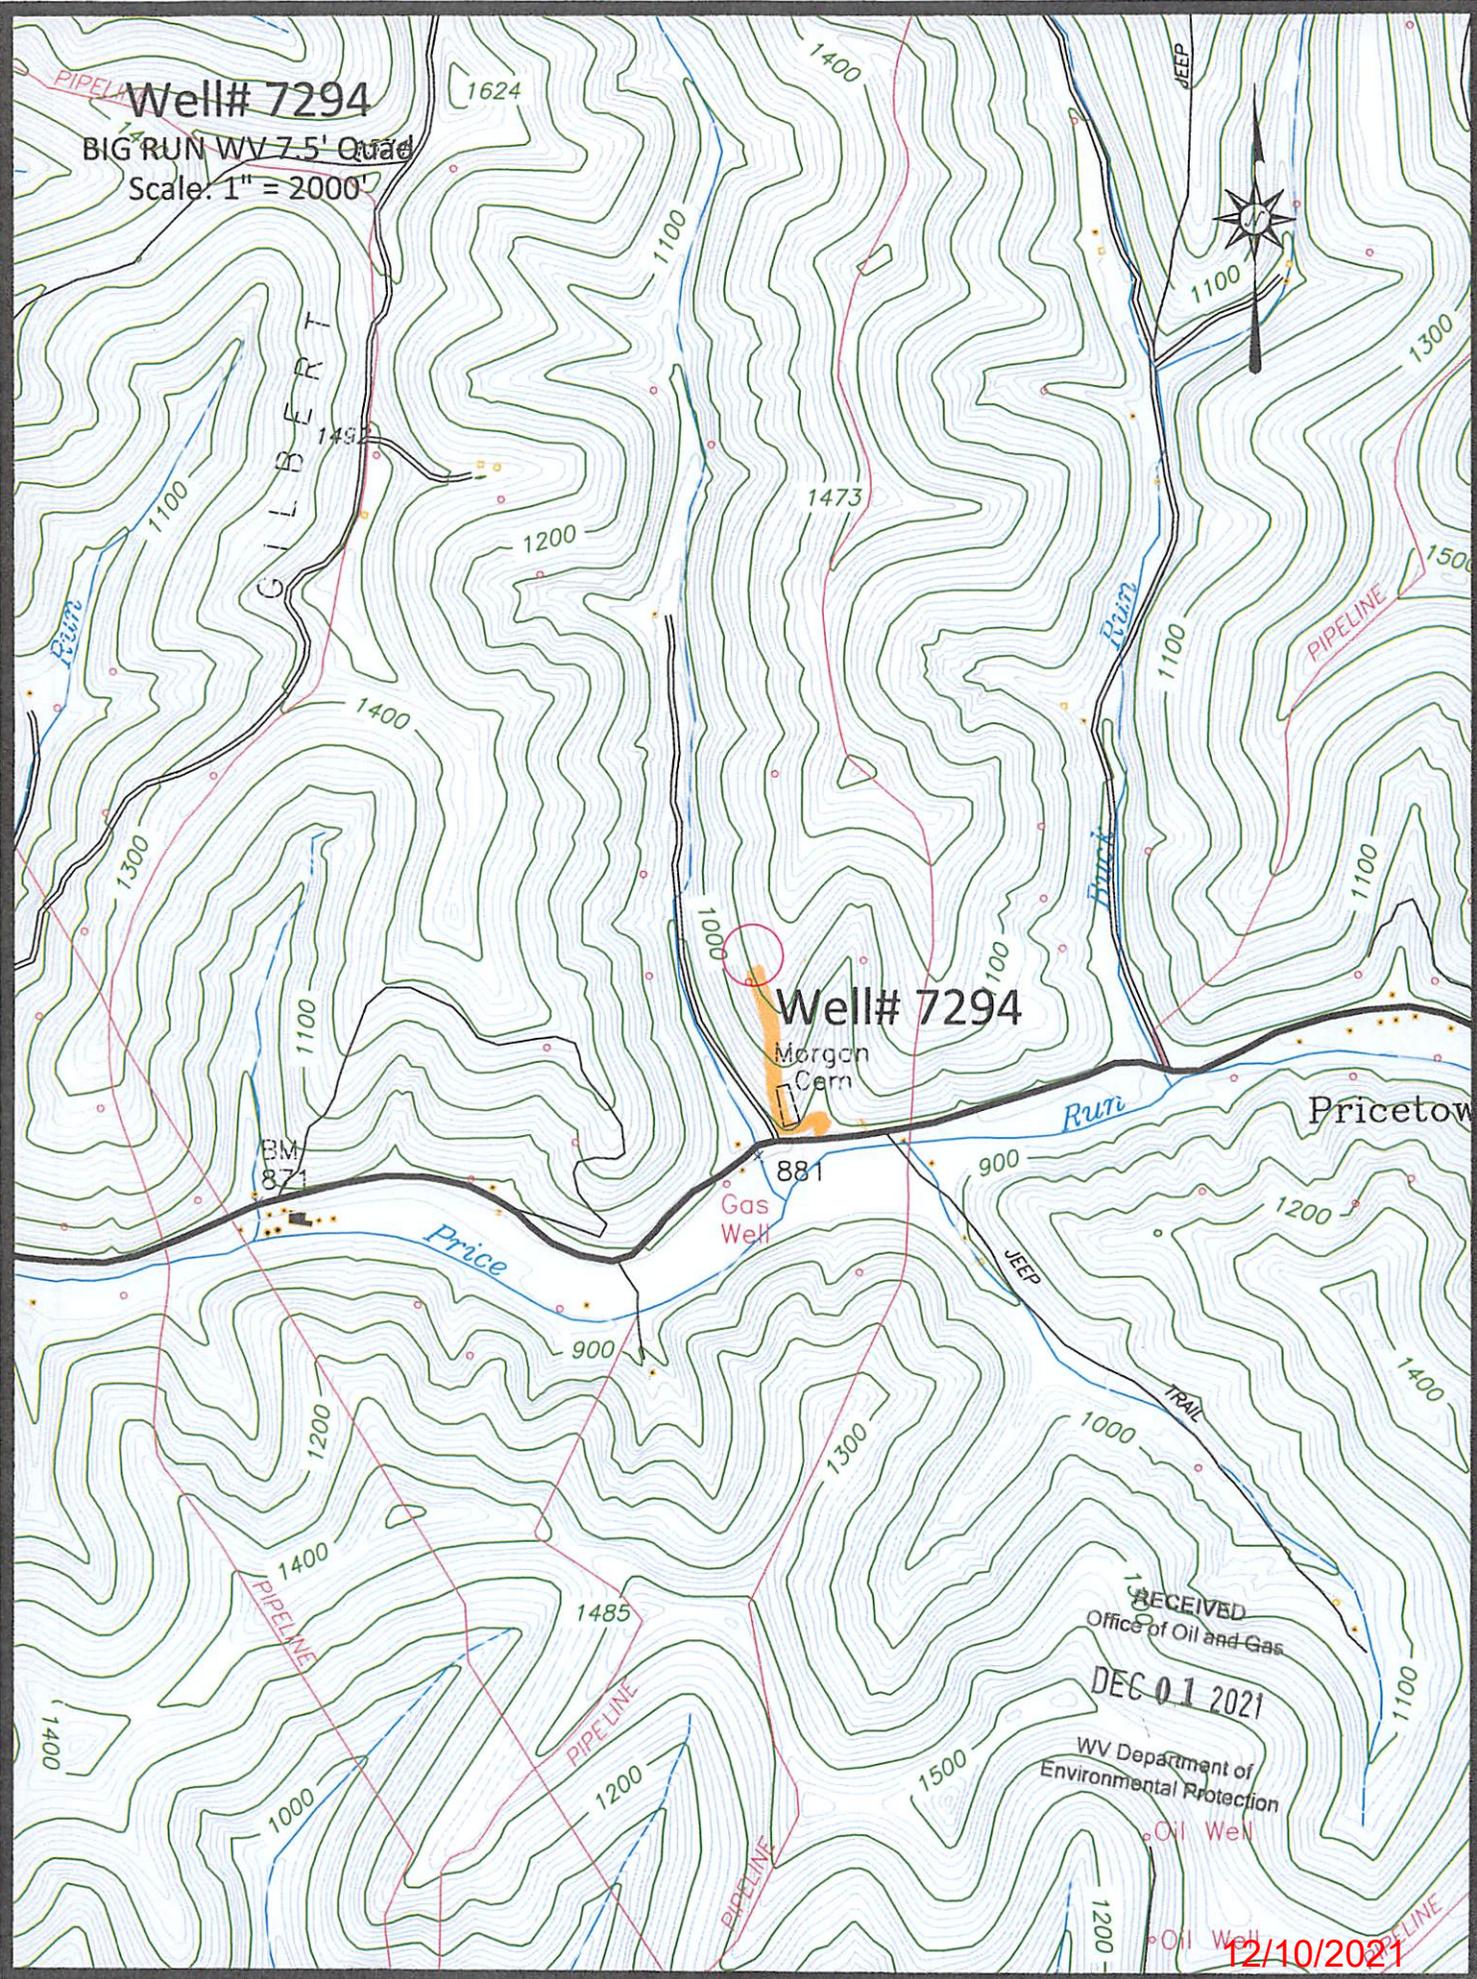

Well# 7294

BIG RUN WV 7.5' Quad

Scale: 1" = 2000'

Well# 7294

Morgan Cam

Pricetown

Gas Well

RECEIVED
Office of Oil and Gas

DEC 01 2021

WV Department of
Environmental Protection

Oil Well

Oil Well

12/10/2021

Access Road

Well# 7294

BIG RUN WV 7.5' Quad

Scale: 1" = 500'



1000

1100

Well# 7294

Morgan Cem

881

Gas Well

900

rice

RECEIVED
Office of Oil and Gas

DEC 01 2021

WV Department of
Environmental Protection

900

12/10/2021

Access Road

