

39° 40' 00"

Latitude ✓

80° 25' 00"

Longitude

o

**Topo Location**

7.5' Loc. 1.535 15' Loc. 1.535  
0.62N (calc.) 0.62W

Company Greenridge Oil Co.  
Farm Shay #9  
15' Quad Mannington (wc)  
(sec.)  
7.5' Quad Hundred  
District Church

**WELL LOCATION PLAT**

County 103 Permit 1621N

1) Attach a photo copy of the location of the well on a 7.5 minute Quadrangle with the corresponding longitude and Latitude.


2) Designate the location of the well with the symbol (+).

**RECEIVED**  
 WV Division of Environmental Protection  
 JAN 28 94  
 Permitting Office of Oil & Gas

3300' 39° 40'

49° E 89° N

152° 02'

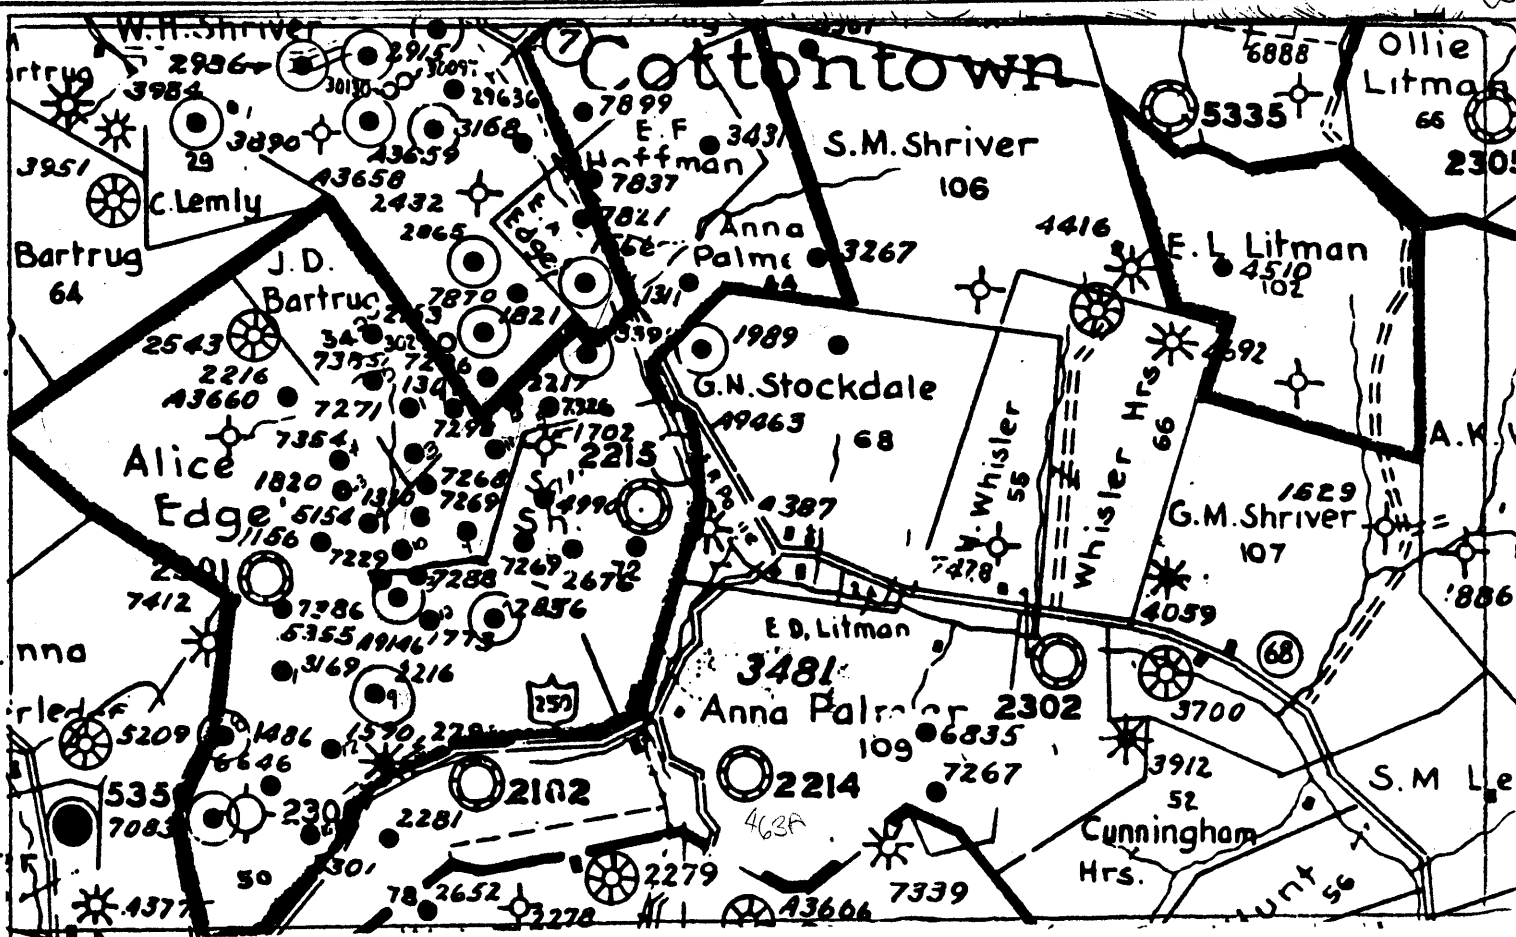

I, the undersigned, hereby certify that this plat is correct to the best of my knowledge and belief.

SIGNED Ralph C. Condit  
 TITLE President

**RECEIVED**

WV Division of Environmental Protection

JAN 26 93

Permitting Office of Oil & Gas

DATE 1/8, 1993  
 OPERATORS WELL NO. 9 (2216)  
 API WELL NO. 103-1621-d

Shaley # 9

18936

STATE OF WEST VIRGINIA  
 DEPARTMENT OF ENERGY  
 OIL AND GAS DIVISION

TYPE: OIL  GAS  LIQUID INJECTION  WASTE DISPOSAL   
 AS" PRODUCTION  STORAGE  DEEP  SHALLOW

LOCATION: ELEVATION 1200 WATER SHED Fish Creek  
 DISTRICT Church COUNTY Wetzel  
 QUADRANGLE 27 X 30 X 40'

SURFACE OWNER Hundred ACREAGE \_\_\_\_\_  
 OIL & GAS ROYALTY OWNER \_\_\_\_\_ LEASE ACREAGE 75  
 LEASE NO. \_\_\_\_\_

PRODUCING FORMATION Maxton Sand TOTAL DEPTH 2344  
 WELL OPERATOR Greenidge Oil Co. DESIGNATED AGENT John Lavelle  
 ADDRESS R.D. #1 Box 72 ADDRESS R.D. #1 Box 72  
New Freeport, PA. 15352 Knob Fork, WV 26579

STATE OF WEST VIRGINIA  
DIVISION OF ENVIRONMENTAL PROTECTION  
SECTION OF OIL AND GAS

WELL REGISTER ASSIGNMENT

This API Number 47-103-01621, issued to GREENRIDGE OIL, INC. is evidence of permission to operate the well that is referenced at the location described on the attached plat, subject to the provisions of Chapters 22 and 22B of the West Virginia Code of 1931, as amended, and all rules and regulations promulgated thereunder. The name and telephone number of the Oil and Gas Inspector for this well is RANDAL MICK -  
304-986-3324.

Spills or emergency discharges must be reported to 1-800-654-3312.

Failure to abide by all statutory and regulatory provisions governing all duties and operations hereunder may result in suspension or revocation of your permits and in addition may result in civil and/or criminal penalties.

The enclosed WR-35 must be completed by you and returned to this office. In addition annual production reports must be submitted on this well and failure to do so may require you to plug the well.

Theodore M. Streit  
Chief

By:  \_\_\_\_\_

Title: \_\_\_\_\_

Operator's Well No: 9

Farm Name: SHAY

API Well Number : 47-103-01621 N

Date Issued : 05/02/94