


← 5,800' →
LATITUDE 39° 42' 30"

LONGITUDE 80° 45' 00"
8,900'

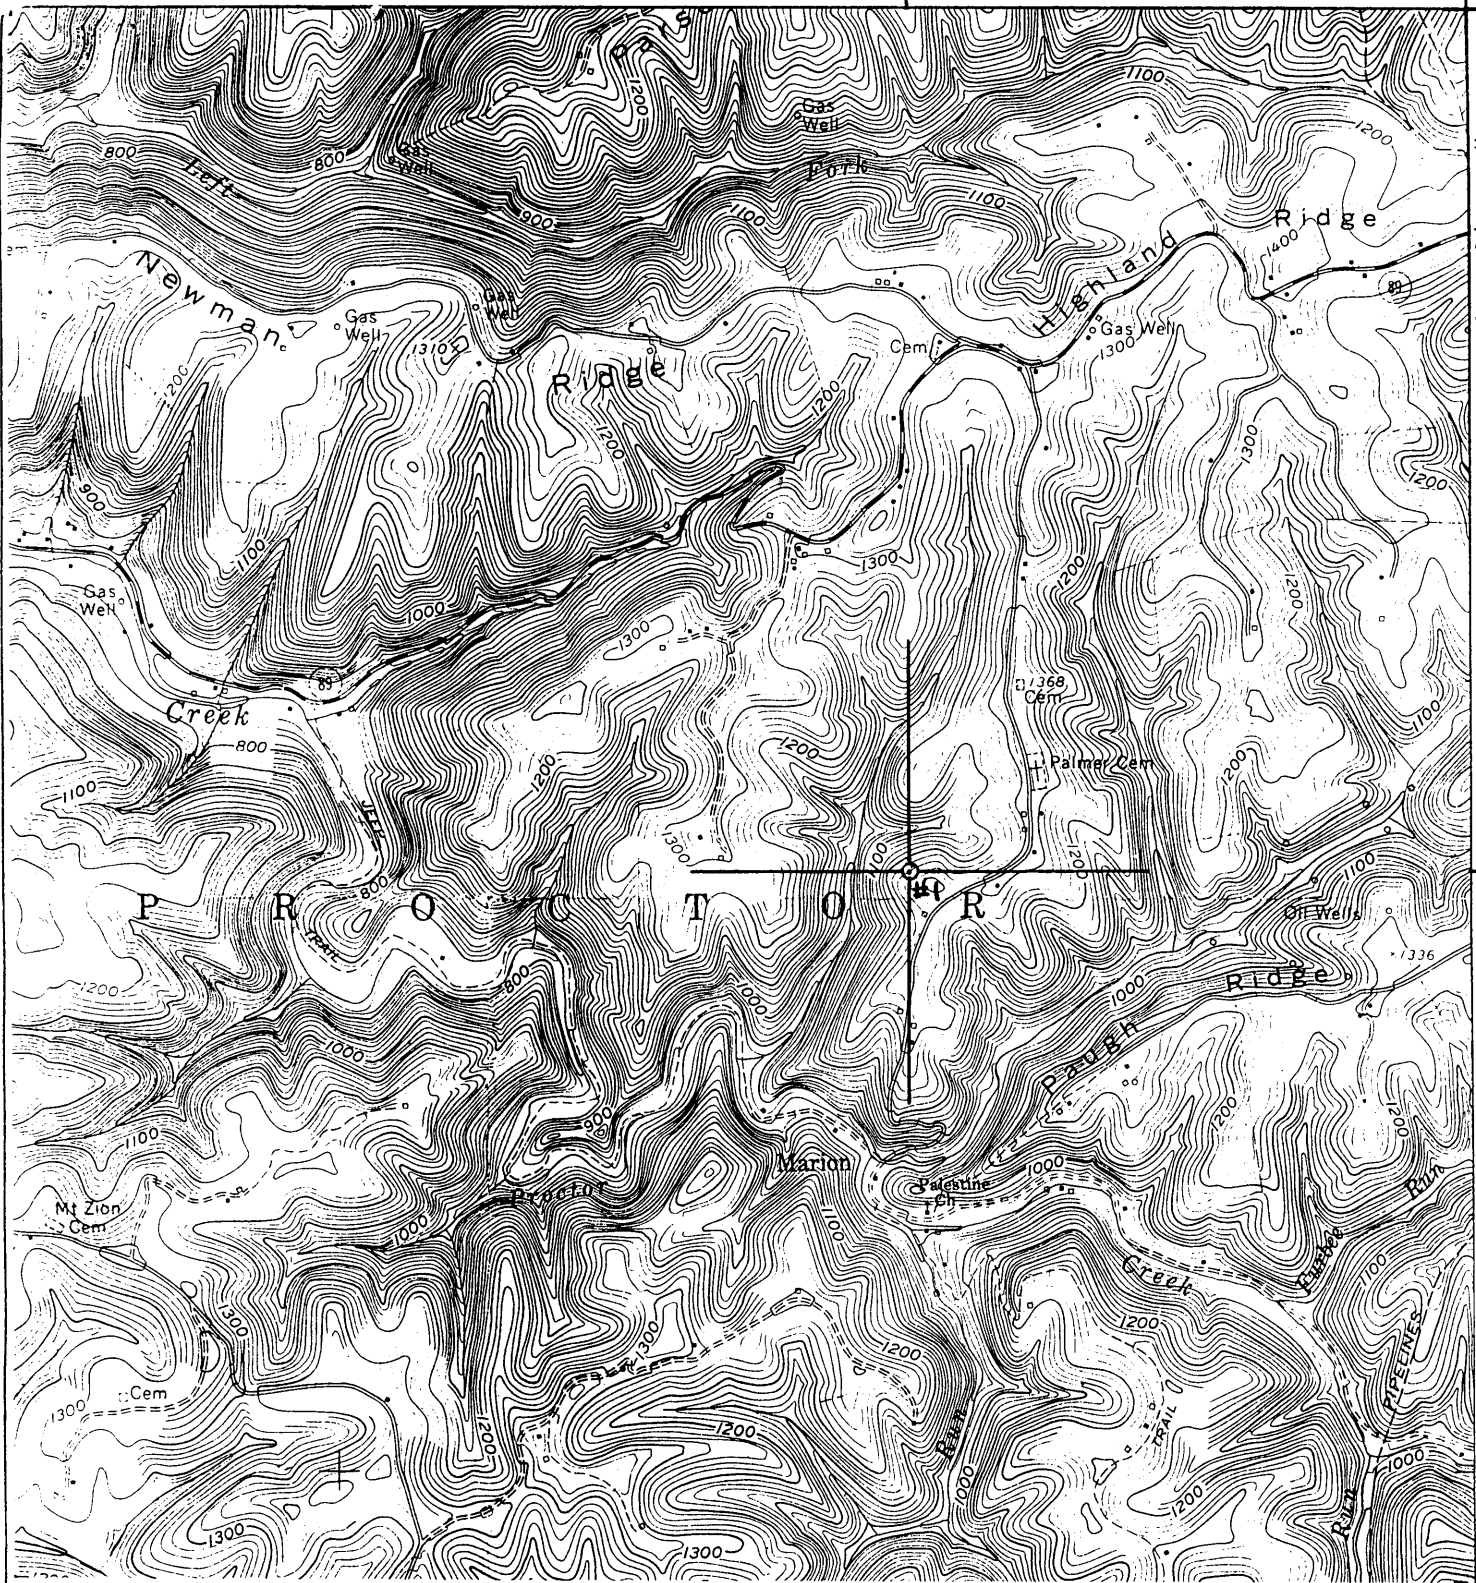

THE UNDERSIGNED, HEREBY CERTIFY THAT HIS PLAT IS CORRECT TO THE BEST OF MY KNOWLEDGE AND BELIEF.

SIGNED *Deryl Perkins*

TITLE Deryl Perkins - VICE PRESIDENT

20487

STATE OF WEST VIRGINIA
DIVISION OF ENVIRONMENTAL PROTECTION
OFFICE OF OIL AND GAS

DATE March 27, 19 95

FARM A.J. Briggs NO. 1

API WELL NO.
47-103-1661-N

WELL TYPE: OIL GAS _____ LIQUID INJECTION _____ WASTE DISPOSAL _____
(IF "GAS") PRODUCTION _____ STORAGE _____ DEEP _____ SHALLOW _____

LOCATION: ELEVATION 1240 Topo WATERSHED Proctor Creek

DISTRICT Proctor 7 COUNTY Wetzel

QUADRANGLE New Martinsville 509

SURFACE OWNER Unknown ACREAGE ?

OIL & GAS ROYALTY OWNER Unknown LEASE ACREAGE 122.5 Ac.

LEASE NO. _____

PRODUCING FORMATION Gordon TOTAL DEPTH 2900 +/-

WELL OPERATOR Perkins Oil & Gas ³⁷⁵⁰⁰ DESIGNATED AGENT Deryl Perkins

ADDRESS P.O. Box 547 ADDRESS P.O. Box 547

Pennsboro, West Virginia 26415 Pennsboro, West Virginia 26415

Latitude

Longitude

170s
110w

Topo Location

7.5' Loc. _____ 15' Loc. _____
(calc.) _____

Company Perkins O+G

Farm A J Buggs #1

15' Quad _____
(sec.)

7.5' Quad New Martinsville

District Procter

WELL LOCATION PLAT

County 103 Permit 1661-N

STATE OF WEST VIRGINIA
DIVISION OF ENVIRONMENTAL PROTECTION
SECTION OF OIL AND GAS

WELL REGISTER ASSIGNMENT

This API Number 47-103-01661, issued to PERKINS OIL & GAS, INC. is evidence of permission to operate the well that is referenced at the location described on the attached plat, subject to the provisions of Chapters 22 and 22B of the West Virginia Code of 1931, as amended, and all rules and regulations promulgated thereunder. The name and telephone number of the Oil and Gas Inspector for this well is RANDAL MICK
304-986-3324.

Spills or emergency discharges must be reported to 1-800-654-3312.

Failure to abide by all statutory and regulatory provisions governing all duties and operations hereunder may result in suspension or revocation of your permits and in addition may result in civil and/or criminal penalties.

The enclosed WR-35 must be completed by you and returned to this office. In addition annual production reports must be submitted on this well and failure to do so may require you to plug the well.

Theodore M. Streit
Chief

By: 

Title: _____

Operator's Well No: BRIGGS #1

Farm Name: BRIGGS, A.J.

API Well Number : 47-103-01661 N

Date Issued : 04/18/95