


7,300'
LATITUDE 39° 45' 00"

LONGITUDE 80° 42' 30"

20490



2.60s
1.40w

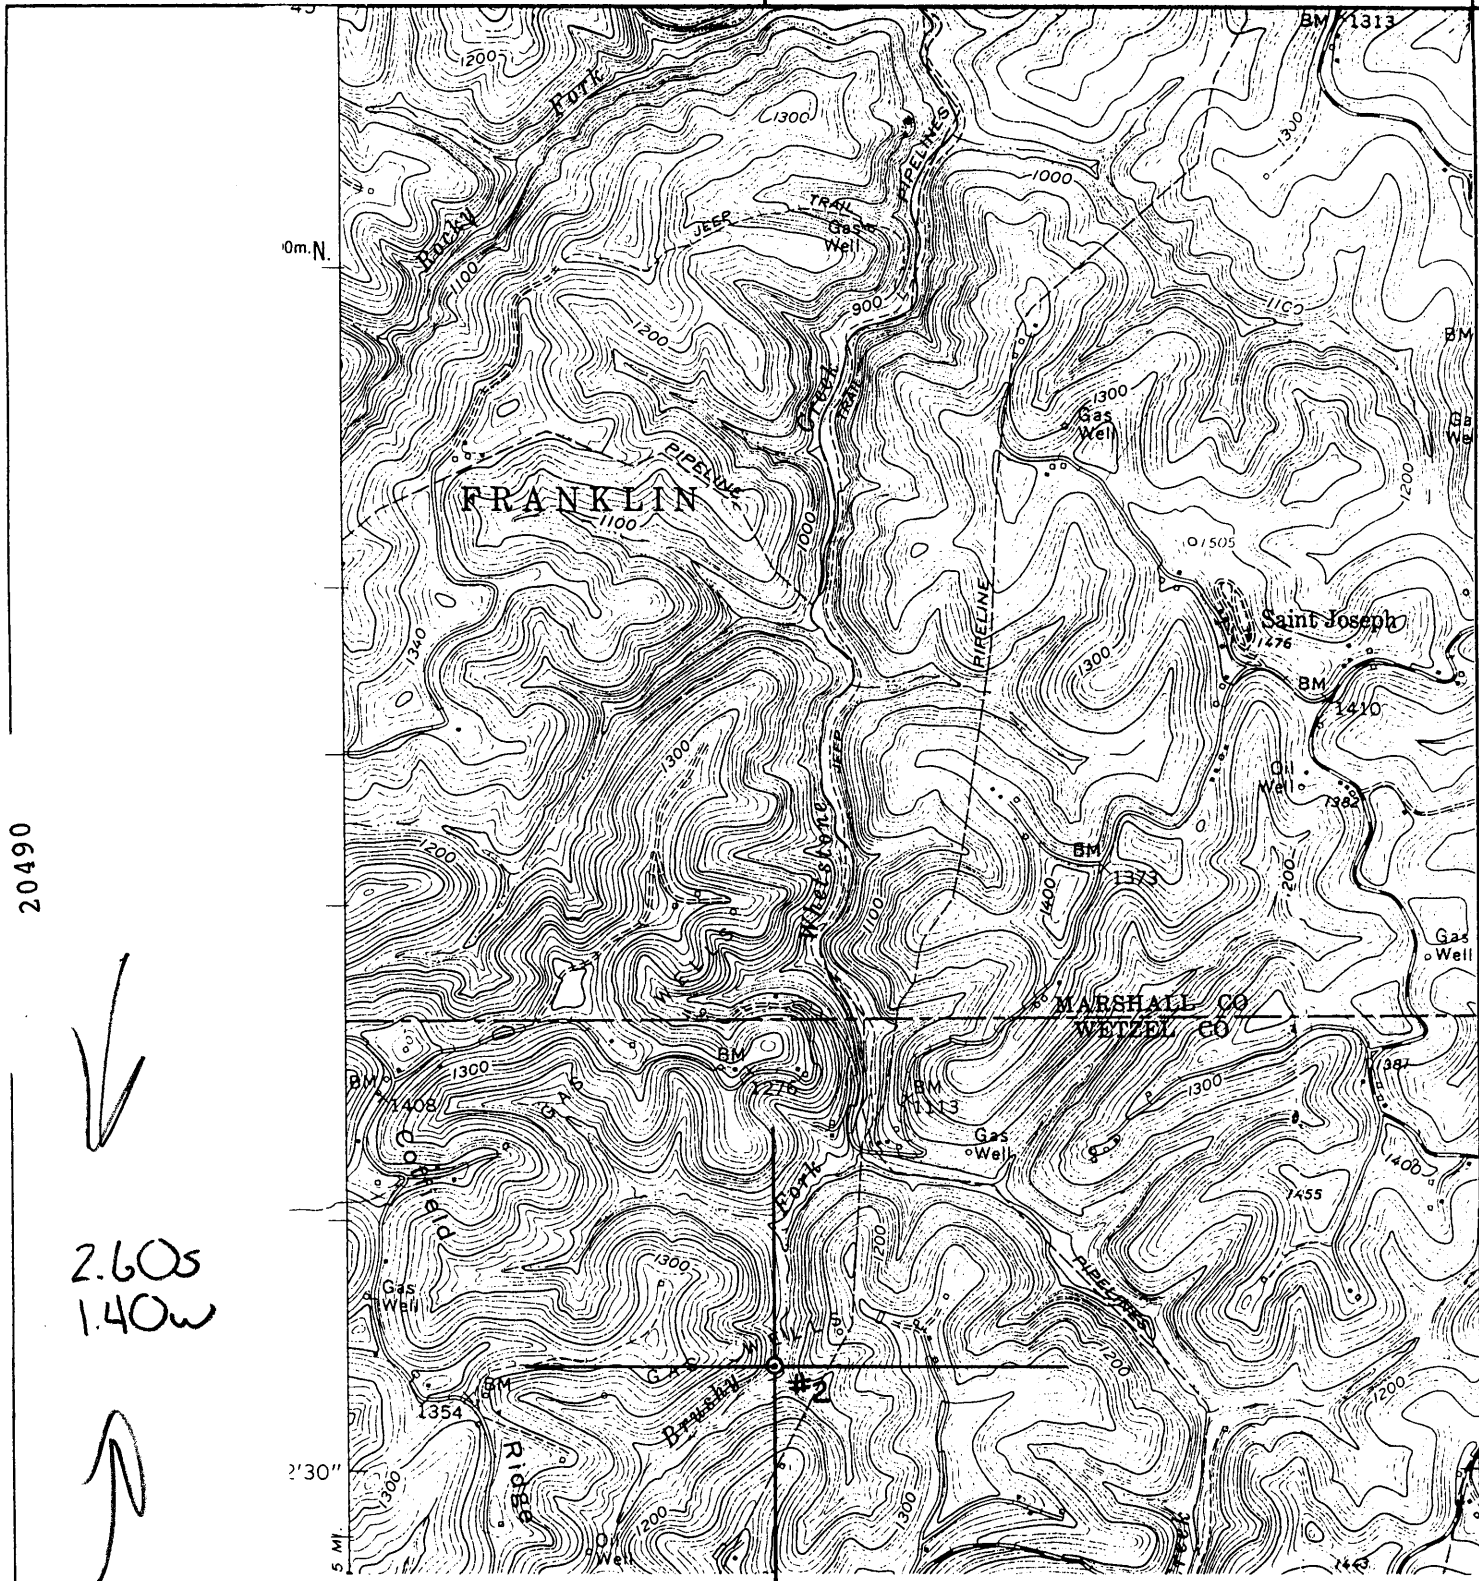

I THE UNDERSIGNED, HEREBY CERTIFY THAT THIS PLAT IS CORRECT TO THE BEST OF MY KNOWLEDGE AND BELIEF.

SIGNED

TITLE

Deryl Perkins - VICE PRESIDENT

STATE OF WEST VIRGINIA
DIVISION OF ENVIRONMENTAL PROTECTION
OFFICE OF OIL AND GAS

DATE March 27, 19 95

FARM James Henry NO. 2

API WELL NO.

47-103-1664-N

WELL TYPE: OIL GAS LIQUID INJECTION WASTE DISPOSAL
(IF "GAS") PRODUCTION STORAGE DEEP SHALLOW

70531?

LOCATION: ELEVATION 1047 WATERSHED Brushy Fork of Whetstone Creek

DISTRICT Proctor COUNTY Wetzel

QUADRANGLE Wileyville 681

SURFACE OWNER Unknown

ACREAGE ?

OIL & GAS ROYALTY OWNER Unknown

LEASE ACREAGE 80 Ac.

LEASE NO. _____

PRODUCING FORMATION Gordon

TOTAL DEPTH 2080 +/-

WELL OPERATOR Perkins Oil & Gas DESIGNATED AGENT Deryl Perkins

ADDRESS P.O. Box 547

ADDRESS P.O. Box 547

Pennsboro, West Virginia 26415

Pennsboro, West Virginia 26415

STATE OF WEST VIRGINIA
DIVISION OF ENVIRONMENTAL PROTECTION
SECTION OF OIL AND GAS

WELL REGISTER ASSIGNMENT

This API Number 47-103-01664, issued to PERKINS OIL & GAS, INC. is evidence of permission to operate the well that is referenced at the location described on the attached plat, subject to the provisions of Chapters 22 and 22B of the West Virginia Code of 1931, as amended, and all rules and regulations promulgated thereunder. The name and telephone number of the Oil and Gas Inspector for this well is RANDAL MICK -
304-986-3324.

Spills or emergency discharges must be reported to 1-800-654-3312.

Failure to abide by all statutory and regulatory provisions governing all duties and operations hereunder may result in suspension or revocation of your permits and in addition may result in civil and/or criminal penalties.

The enclosed WR-35 must be completed by you and returned to this office. In addition annual production reports must be submitted on this well and failure to do so may require you to plug the well.

Theodore M. Streit
Chief

By: *TM Streit*

Title: _____

Operator's Well No: HENRY #2

Farm Name: HENRY, JAMES

API Well Number : 47-103-01664 N

Date Issued : 04/18/95