


10,000' LATITUDE 39° 30' 00"

LONGITUDE 80° 32' 30"

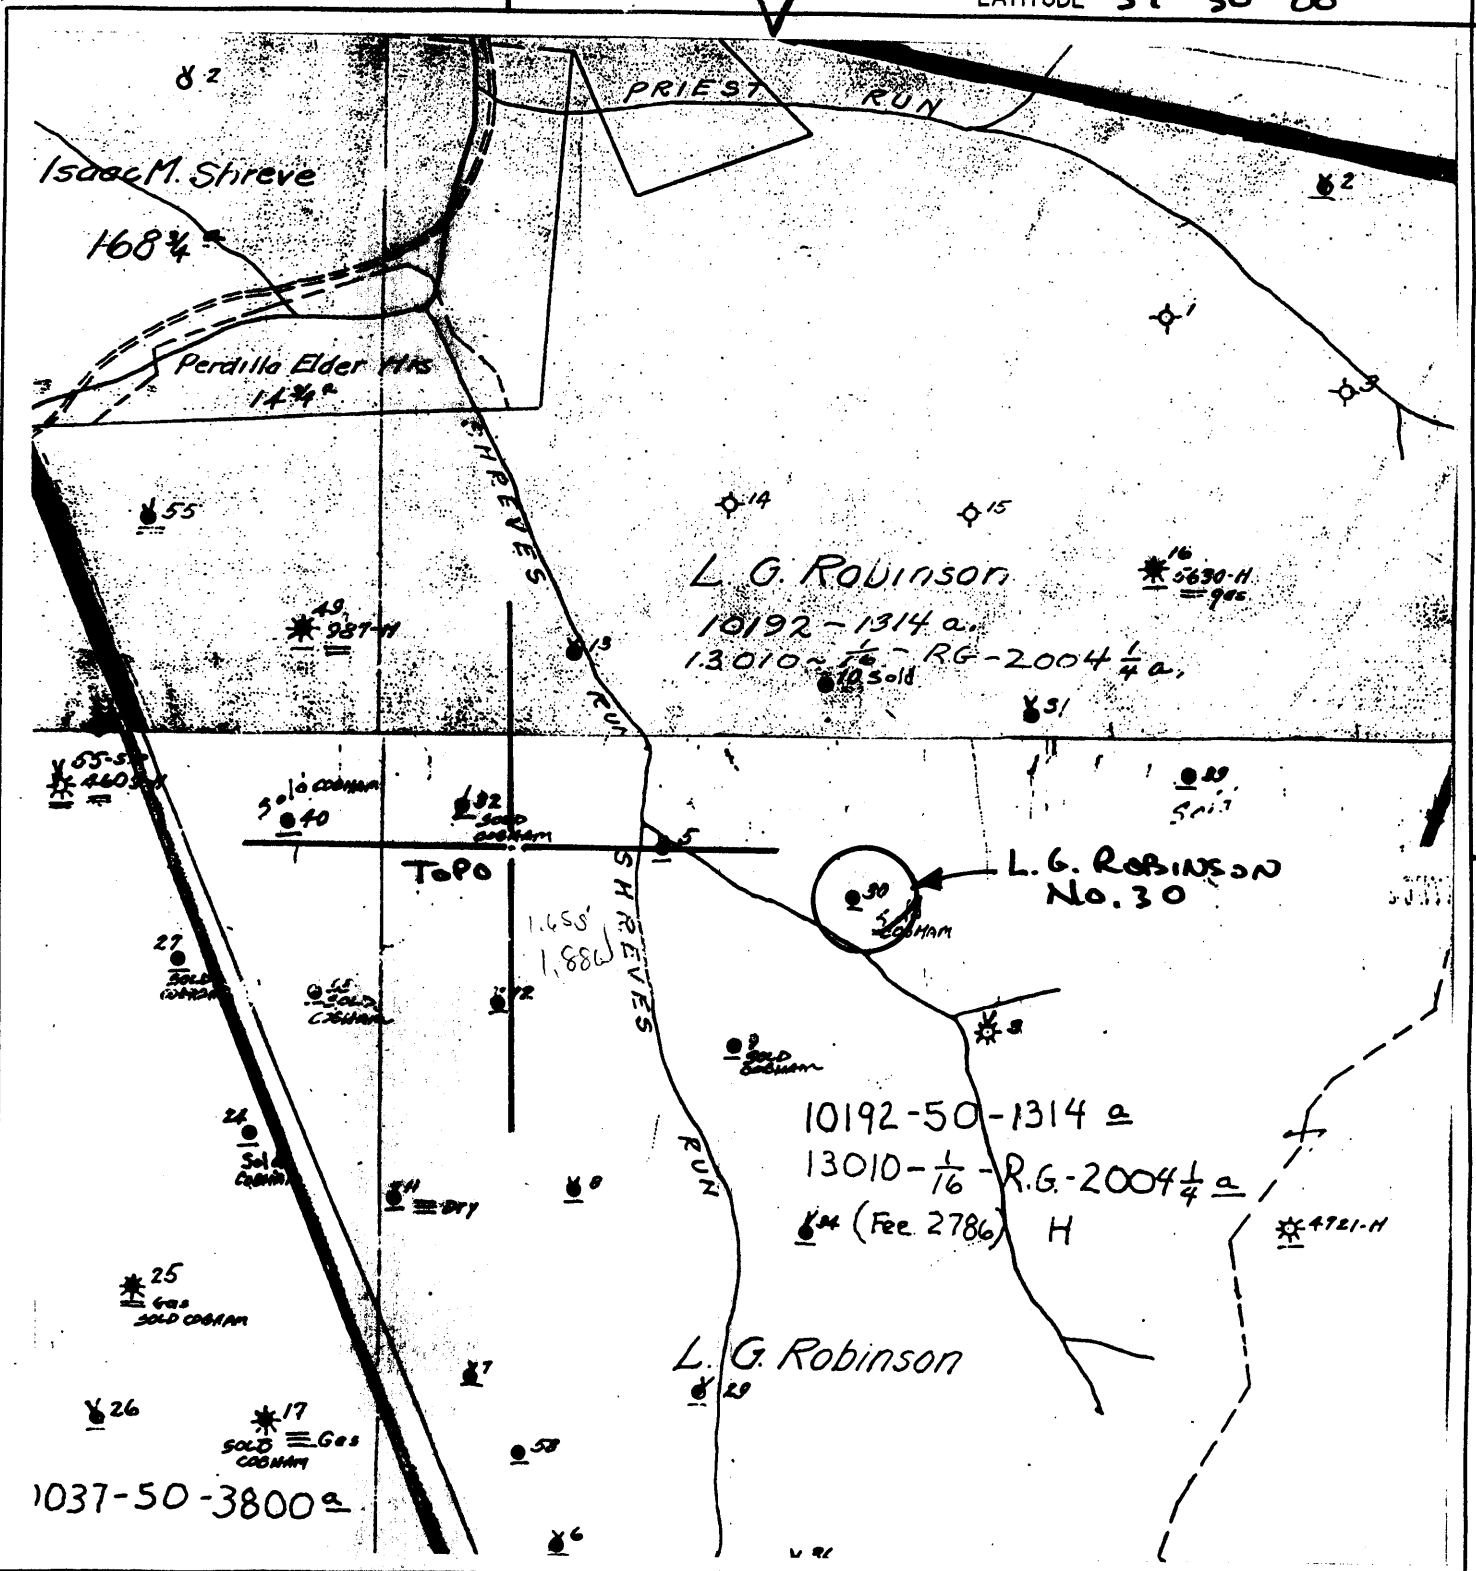

Scale 1" = 800'

WE, THE UNDERSIGNED, HEREBY CERTIFY THAT THIS PLAT IS CORRECT TO THE BEST OF MY KNOWLEDGE AND BELIEF.

SIGNED

*Philip S. Ondrusek*

TITLE

Supervisor, Surveying/Mapping

STATE OF WEST VIRGINIA  
DIVISION OF ENVIRONMENTAL PROTECTION  
OFFICE OF OIL AND GAS

DATE October 31, 19 96

FARM L.G. Robinson NO. 30

API WELL NO.

47-103-1732-H

WELL TYPE: OIL  GAS \_\_\_\_\_ LIQUID INJECTION \_\_\_\_\_ WASTE DISPOSAL \_\_\_\_\_  
(IF "GAS") PRODUCTION \_\_\_\_\_ STORAGE \_\_\_\_\_ DEEP \_\_\_\_\_ SHALLOW \_\_\_\_\_

WAD 103 70789

LOCATION: ELEVATION 1050 Topo WATERSHED ARCHES Fork

DISTRICT GRANT COUNTY Wetzel

QUADRANGLE Folsom

SURFACE OWNER Unknown

ACREAGE \_\_\_\_\_

OIL & GAS ROYALTY OWNER Unknown

LEASE ACREAGE 1314 Ac

LEASE NO. 10192-50

6-6-100

PRODUCING FORMATION Big Injun

TOTAL DEPTH 2119

WELL OPERATOR Pennzoil Products Company

DESIGNATED AGENT

Philip S. Ondrusek

ADDRESS P.O. Box 5519

ADDRESS

P.O. Box 5519

Vienna, WV 26105

Vienna, WV 26105

DEC 6 1996

22985

No. 1 Well Sold to J. & H. Productions 11-4-68 47-103-1732  
 SOUTH PENN OIL COMPANY—COMPLETION

SERIAL NO. \_\_\_\_\_ FARM ROBINSON, I.C. WELL No. 30  
 ELEVATION \_\_\_\_\_ N. \_\_\_\_\_ S. 2 E. 3 W. \_\_\_\_\_  
 LEASE No. 10196 ACRES 1314 Map 2951  
 WATERS OF Archer Fork, So. Fork Fishing Creek  
 DISTRICT Grant COUNTY Wetzel STATE W. Va.  
 DRILLING COMMENCED \_\_\_\_\_ COMPLETED 1/15/95 DEPTH 2189

SANDS	TOP	BOTTOM	ELEV. TOP	CASING
Pgh. COAL <u>***</u>	767	775		10 262
Dunkard Sand	1315	1500		8 1315
Salt Sand	1580	1760		6 2054
Big Lime	2030	2100		
Pencil Cave	2000			
Big Injun	2110			
1st Pay	2167			

INITIAL PROD. 75 Bbls SAND Big Injun DEPTH 2167  
 GAS TEST \_\_\_\_\_ " \_\_\_\_\_ " \_\_\_\_\_ "  
 SHOT 8/24/98 QUARTS 16 " \_\_\_\_\_ " \_\_\_\_\_ "  
 REMARKS \_\_\_\_\_

REPORTED BY WETZEL DISTRICT ABANDONED \_\_\_\_\_

RECEIVED  
 Office of Oil and Gas  
 OCT 04 1999  
 WV Division of  
 Environmental Protection

WET 1732

NOV 1 1999

✓

STATE OF WEST VIRGINIA  
DIVISION OF ENVIRONMENTAL PROTECTION  
SECTION OF OIL AND GAS

WELL REGISTER ASSIGNMENT

This API Number 47-103-01732, issued to PENNZOIL PRODUCTS COMPANY is evidence of permission to operate the well that is referenced at the location described on the attached plat, subject to the provisions of Chapters 22 and 22B of the West Virginia Code of 1931, as amended, and all rules and regulations promulgated thereunder. The name and telephone number of the Oil and Gas Inspector for this well is RANDAL MICK -  
304-759-0579.

Spills or emergency discharges must be reported to 1-800-654-3312.

Failure to abide by all statutory and regulatory provisions governing all duties and operations hereunder may result in suspension or revocation of your permits and in addition may result in civil and/or criminal penalties.

The enclosed WR-35 must be completed by you and returned to this office. In addition annual production reports must be submitted on this well and failure to do so may require you to plug the well.

Theodore M. Streit  
Chief

By: 

Title: \_\_\_\_\_

Operator's Well No: L.G.ROBONSON#30

Farm Name:

API Well Number : 47-103-01732 N

Date Issued : 12/04/96