

LATITUDE 39° 30' 00"  
5,400'

3,240'

LONGITUDE 80° 27' 30"

NORTH

TERRY AND MARY BARNETT

TO WV ROUTE 21/4

EVE MAE LIGGETT

TRIBUTARY OF TENMILE RUN

N71°00'00"E  
474.37'

S57°00'00"E  
528.00'

0.615  
1.02W

STONE IN COUNTY LINE

S31°30'00"W  
82.50'

ROBERT BRUCE HADOX

WELL #6366

PRIVATE ROADS

JUSTON AND ANNA REEL

N45°00'00"W  
165.00'

ROBERT BRUCE HADOX

EVE MAE LIGGETT  
56.5 ± ACRES

JOSEPH AND LINDA MARTIN

N43°00'00"W  
172.50'

N05°00'00"W  
528.00'

N42°28'12"W  
1761.84'



TWIN 20" OAK

MARY R. KOCHER

TALL TIMBER, INC.

JOSEPH AND LINDA MARTIN

UNNAMED TRIBUTARY OF TENMILE RUN

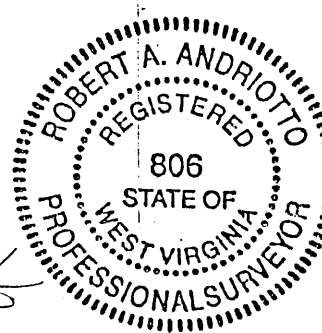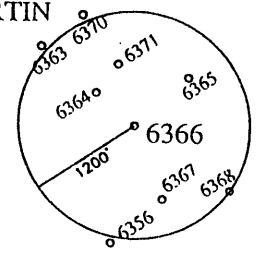

I THE UNDERSIGNED, HEREBY CERTIFY THAT THIS PLAT IS CORRECT TO THE BEST OF MY KNOWLEDGE AND BELIEF AND SHOWS ALL THE INFORMATION REQUIRED BY LAW AND THE REGULATIONS ISSUED AND PRESCRIBED BY THE DEPARTMENT OF ENERGY.

P.S. 806 *Robert A. Andriotto*

(+) DENOTES LOCATION OF WELL ON UNITED STATES TOPOGRAPHIC MAPS.

DATE AUGUST 10, 20 01

OPERATORS WELL NO. 6366

API WELL NO. 47 - 103 - 01895P  
STATE COUNTY PERMIT

MINIMUM DEGREE OF ACCURACY: 1/2500 FILE NO.: WELL6366.DWG  
PROVEN SOURCE OF ELEVATION: COMPANY NETWORK TIED INTO U.S.G.S.  
SCALE: 1"=400'

STATE OF WEST VIRGINIA  
DIVISION OF ENVIRONMENTAL PROTECTION  
OFFICE OF OIL AND GAS



WELL TYPE: OIL  GAS  LIQUID INJECTION  WASTE DISPOSAL  "GAS" PRODUCTION  STORAGE  DEEP  SHALLOW

LOCATION: ELEVATION: 1368.00' WATERSHED: TENMILE RUN QUADRANGLE: WALLACE, WV 7.5'

DISTRICT: GRANT COUNTY: WETZEL ACREAGE: 56.5 ±

SURFACE OWNER: EVE MAE LIGGETT LEASE ACREAGE: \_\_\_\_\_

ROYALTY OWNER: \_\_\_\_\_ LEASE NO.: \_\_\_\_\_

PROPOSED WORK: \_\_\_\_\_

DRILL: \_\_\_\_\_ CONVERT: \_\_\_\_\_ DRILL DEEPER: \_\_\_\_\_ REDRILL: \_\_\_\_\_ FRACTURE OR STIMULATE: \_\_\_\_\_ PLUG OFF OLD: \_\_\_\_\_

FORMATION: \_\_\_\_\_ PERFORATE NEW FORMATION: \_\_\_\_\_ PLUG AND ABANDON: X CLEAN OUT AND REPLUG: \_\_\_\_\_ OTHER: \_\_\_\_\_

PHYSICAL CHANGE IN WELL (SPECIFY): \_\_\_\_\_ TARGET FORMATION: NONE ESTIMATED DEPTH: \_\_\_\_\_

WELL OPERATOR: CONSOLIDATION COAL COMPANY  
ADDRESS: P.O. BOX 100 OSAGE, WV 26543

DESIGNATED AGENT: ROGER E. DUCKWORTH  
ADDRESS: P.O. BOX 100 OSAGE, WV 26543

COUNTY NAME WETZEL  
PERMIT 1895P



PERRY HALL NO. 2 WELL.

70092  
No. 71 on Map.

Grant District, Wetzell County, W. Va.

NO W 103 1895

South Penn Oil Co.

Completed Aug. 26, 1904.

Elevation, 1399'±

Oil well. Abandoned Jan. 25, 1906.

	Top.	Bottom.
Pittsburgh Coal	1244	- 1249
Big Lime	2469	- 2544
Big Injun Sand	2544	- 2674
50-Ft. (Berea) Sand	3145	- 3165
Stray (30-Ft.) Sand	3300	- 3333
Gordon (Stray) Sand	3343	- 3375
4th (Gordon) Sand (oil, 3388')	3385	- 3397
Total depth		3404