

WW-7  
8-30-06



West Virginia Department of Environmental Protection  
Office of Oil and Gas  
**WELL LOCATION FORM: GPS**

API: 47-103-02719<sup>P</sup> WELL NO.: WV 513827 (BIG 176 H10 - Kilcoyne)  
FARM NAME: John W. and Florence E. Kilcoyne  
RESPONSIBLE PARTY NAME: EQT Production Company  
COUNTY: Wetzel DISTRICT: Grant  
QUADRANGLE: Big Run 7.5'  
SURFACE OWNER: John W. and Florence E. Kilcoyne  
ROYALTY OWNER: EQT Production Company  
UTM GPS NORTHING: 4379072  
UTM GPS EASTING: 537803 GPS ELEVATION: 261 m (858 ft)

The Responsible Party named above has chosen to submit GPS coordinates in lieu of preparing a new well location plat for a plugging permit or assigned API number on the above well. The Office of Oil and Gas will not accept GPS coordinates that do not meet the following requirements:

1. Datum: NAD 1983, Zone: 17 North, Coordinate Units: meters, Altitude: height above mean sea level (MSL) – meters.
2. Accuracy to Datum – 3.05 meters
3. Data Collection Method:  
Survey grade GPS X: Post Processed Differential \_\_\_\_\_  
Real-Time Differential X  
Mapping Grade GPS \_\_\_\_: Post Processed Differential \_\_\_\_\_  
Real-Time Differential \_\_\_\_\_

4. **Letter size copy of the topography map showing the well location.**

I the undersigned, hereby certify this data is correct to the best of my knowledge and belief and shows all the information required by law and the regulations issued and prescribed by the Office of Oil and Gas.

Signature

PS # 2180  
Title

9/28/16  
Date

Received  
Office of Oil & Gas  
DEC 22 2016

01/06/2017

Topo Quad: Big Run 7.5'

Scale: 1" = 2000'

County: Wetzel

Date: September 12, 2016

District: Grant


Project No: 40-34-00-09

103-2719P

Water

### 47-103-02719 WV 513827 (BIG 176 H10 - Kilcoyne)

1 Potential Water Source within 1000'

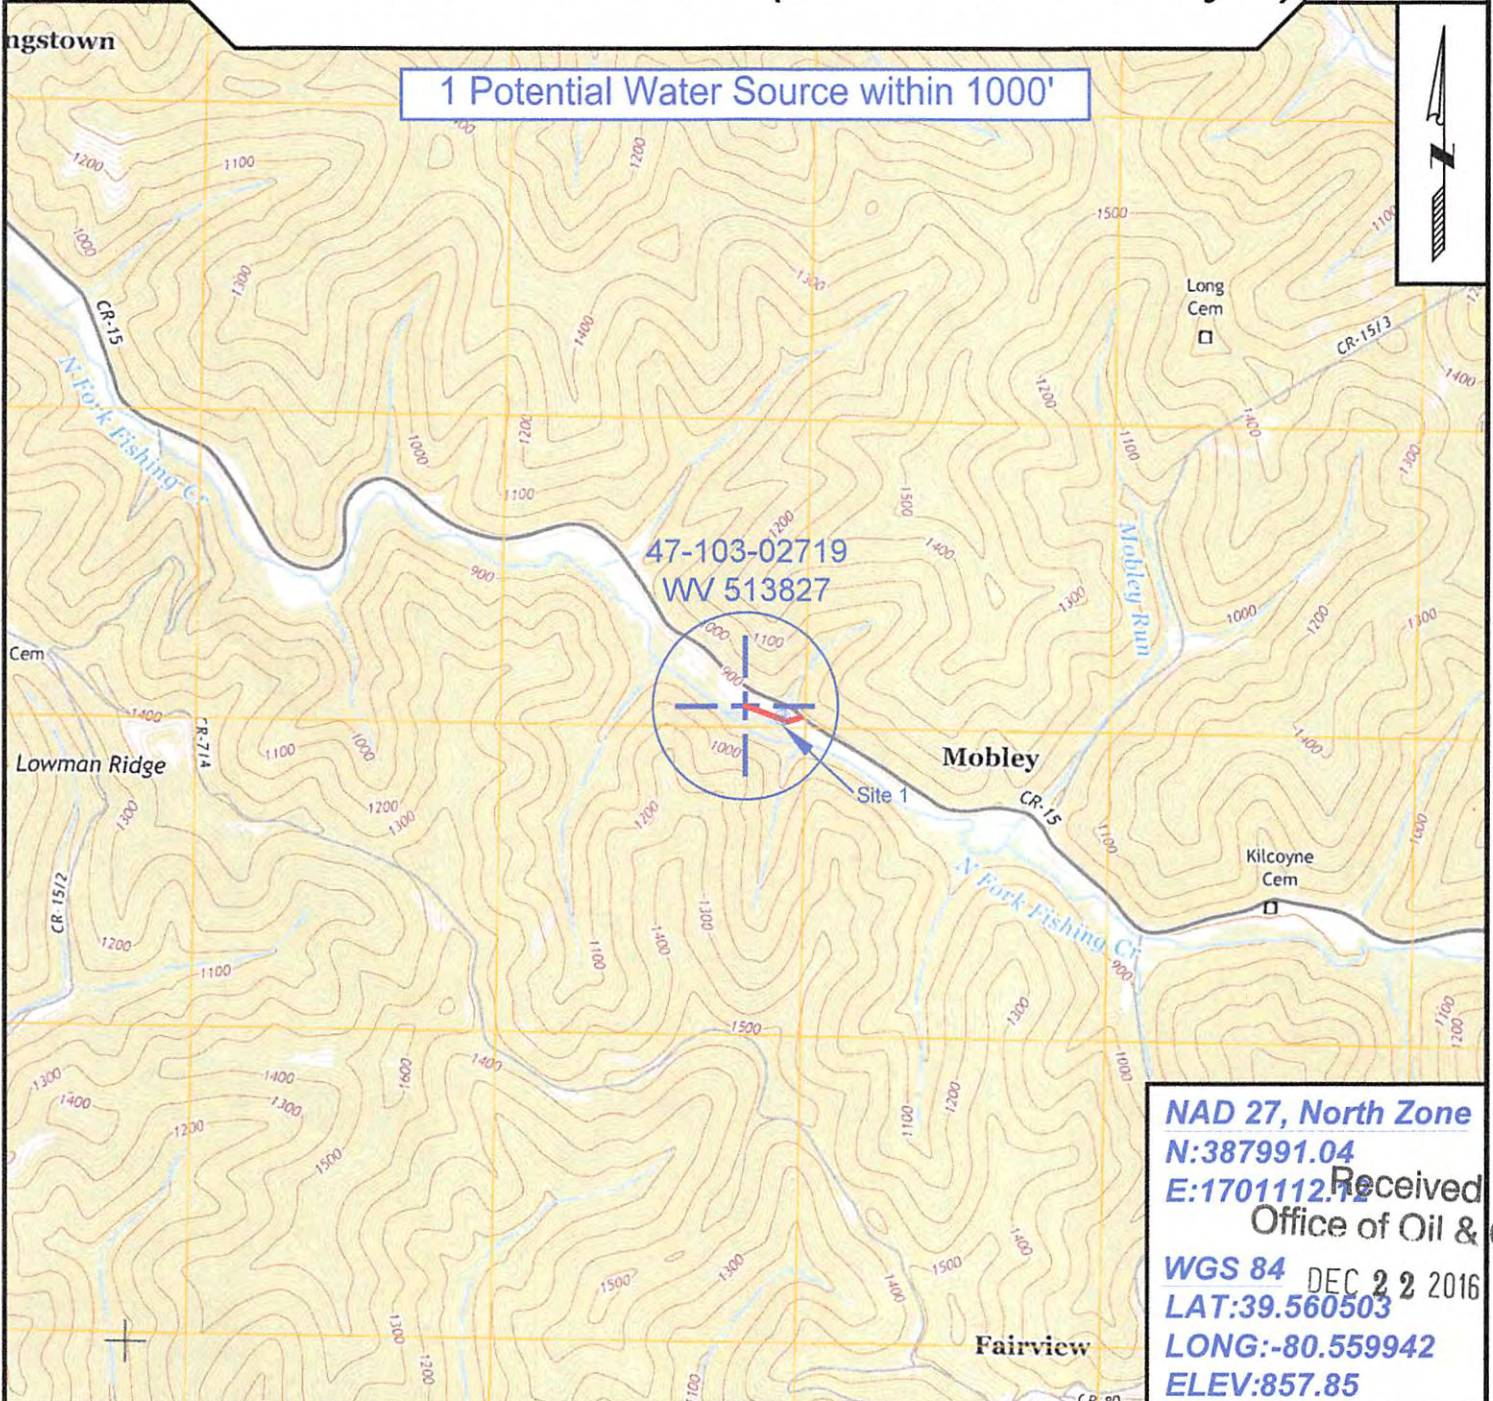

NAD 27, North Zone  
 N:387991.04  
 E:1701112.12  
 WGS 84  
 LAT:39.560503  
 LONG:-80.559942  
 ELEV:857.85

Received  
 Office of Oil & Gas

DEC 22 2016

SURVEYING AND MAPPING SERVICES PERFORMED BY:

PREPARED FOR:



## ALLEGHENY SURVEYS, INC.

1-800-482-8606  
 237 Birch River Road  
 Birch River, WV 26610  
 PH: (304) 649-8606  
 FAX: (304) 649-8608

## EQT Production Company

P.O. Box 280  
 Bridgeport, WV 26330

01/06/2017