


Erlewine 1H
Erlewine
EQT Production Company

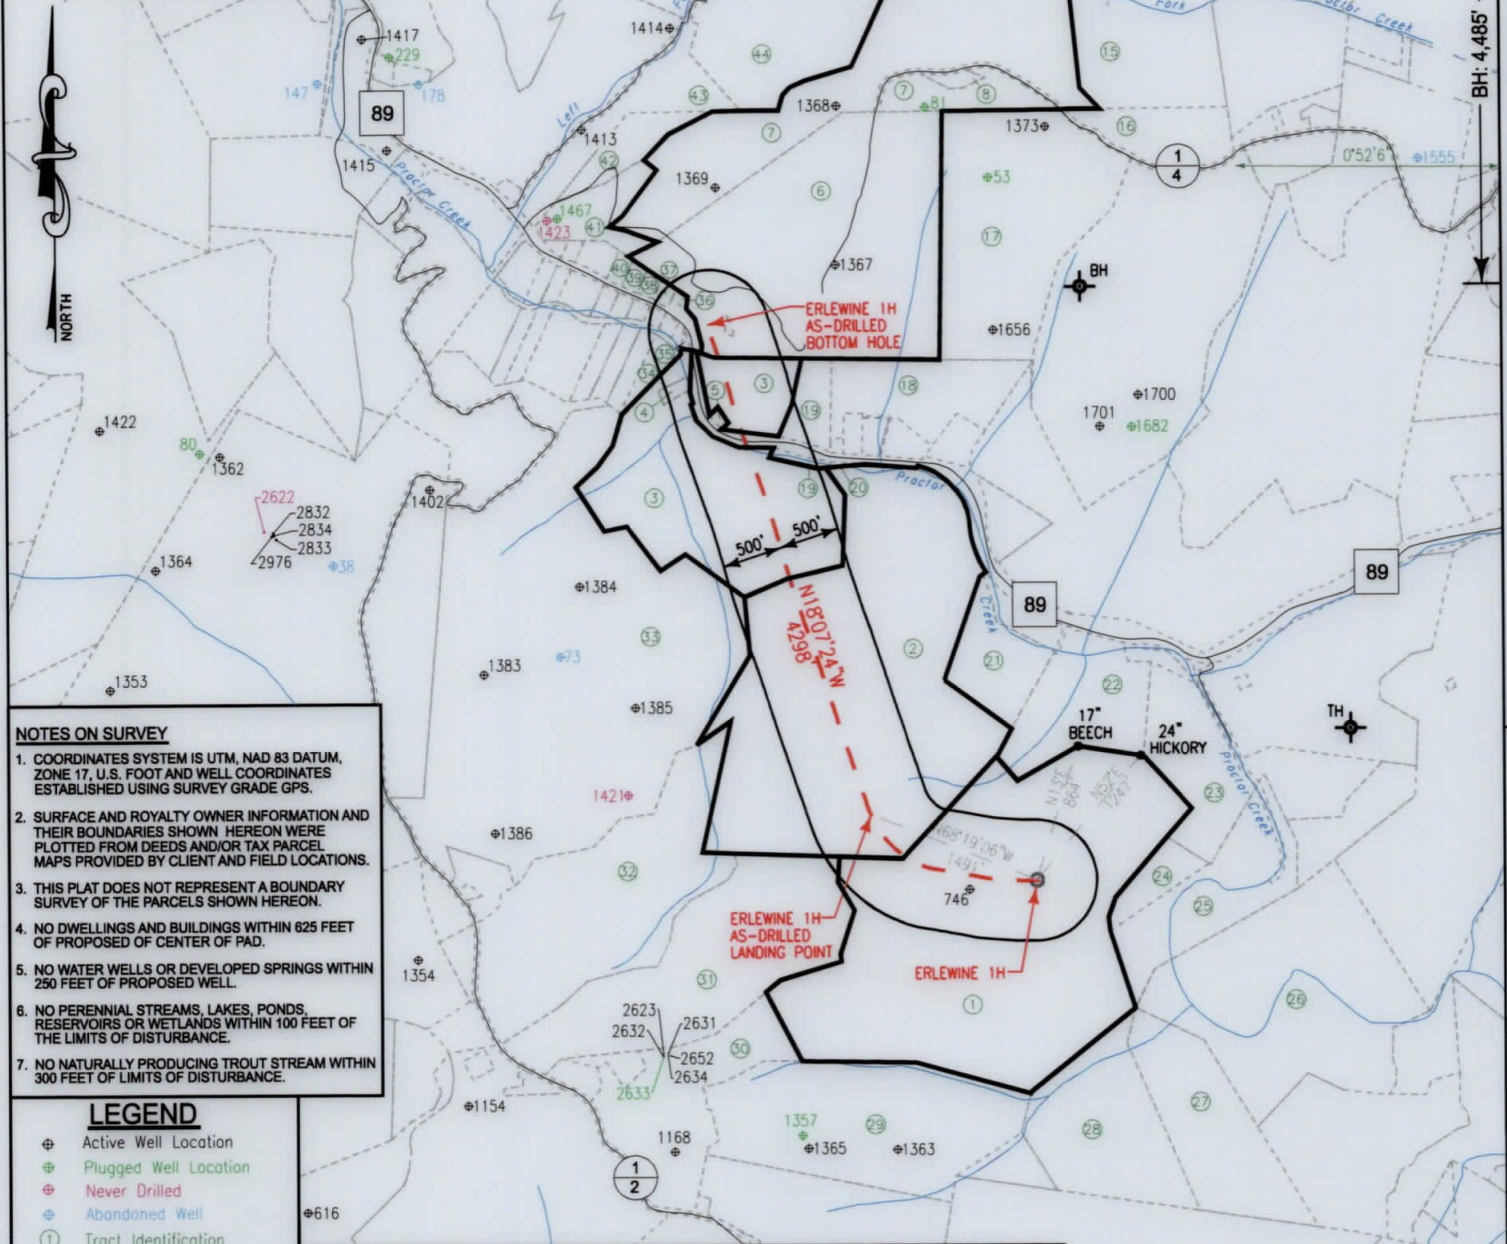

- NOTES ON SURVEY**
- COORDINATES SYSTEM IS UTM, NAD 83 DATUM, ZONE 17, U.S. FOOT AND WELL COORDINATES ESTABLISHED USING SURVEY GRADE GPS.
 - SURFACE AND ROYALTY OWNER INFORMATION AND THEIR BOUNDARIES SHOWN HEREON WERE PLOTTED FROM DEEDS AND/OR TAX PARCEL MAPS PROVIDED BY CLIENT AND FIELD LOCATIONS.
 - THIS PLAT DOES NOT REPRESENT A BOUNDARY SURVEY OF THE PARCELS SHOWN HEREON.
 - NO DWELLINGS AND BUILDINGS WITHIN 625 FEET OF PROPOSED WELL.
 - NO WATER WELLS OR DEVELOPED SPRINGS WITHIN 250 FEET OF PROPOSED WELL.
 - NO PERENNIAL STREAMS, LAKES, PONDS, RESERVOIRS OR WETLANDS WITHIN 100 FEET OF THE LIMITS OF DISTURBANCE.
 - NO NATURALLY PRODUCING TROUT STREAM WITHIN 300 FEET OF LIMITS OF DISTURBANCE.

- LEGEND**
- ⊕ Active Well Location
 - ⊕ Plugged Well Location
 - ⊕ Never Drilled
 - ⊕ Abandoned Well
 - ① Tract Identification
 - Proposed Gas Well
 - Located Corner, as noted
 - - - Surface Tract Lines
 - Reference Line
 - Lease Boundary
 - Creek or Drain
 - ⊙ WV County Route
 - ⊙ WV State Route


Tract ID.	Lease No.	Acres	Owner
1	873753	130.201343	Ronald Carney ET UX
2	873438	126.755241	Piney Holdings, Inc
3	873754	73.741558	George R. Baxter ET UX
6	873671	187.739475	Clarence W. Baxter ET UX

(⊕) Denotes Location of Well on United States Topographic Maps



I, the undersigned, hereby certify that this plat is correct to the best of my knowledge and belief and shows all the information required by law and the regulations issued and prescribed by the Department of Environmental Protection.

Thomas C. Smits
L. L. S. 687

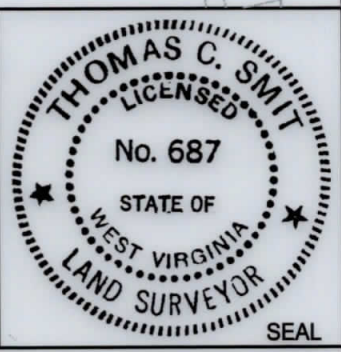

FILE NO: W2192 (BK 65-61)
DRAWING NO: _____
SCALE: 1" = 1600'
MINIMUM DEGREE OF ACCURACY: 1:2500
PROVEN SOURCE OF ELEVATION: NGS CORS Station

STATE OF WEST VIRGINIA
DEPARTMENT OF ENVIRONMENTAL PROTECTION
OIL AND GAS DIVISION

DATE: JUNE 25 20 19
OPERATORS WELL NO: ERLEWINE 1H
API WELL NO: 47 - 103 - 02950
STATE COUNTY PERMIT


WELL TYPE: OIL GAS LIQUID INJECTION WASTE DISPOSAL
(IF GAS) PRODUCTION: STORAGE DEEP SHALLOW
LOCATION ELEVATION: 1,220' WATERSHED: TRIBUTARY OF PROCTOR CREEK QUADRANGLE: NEW MARTINSVILLE 7.5'
DISTRICT: Proctor COUNTY: Wetzel
SURFACE OWNER: Richard Erlewine ACREAGE: 135 ±
ROYALTY OWNER: Ronald Carney, et ux LEASE NO: 873753 ACREAGE: 130.20 ±
PROPOSED WORK: DRILL CONVERT DRILL DEEPER FRACTURE OR STIMULATE PLUG OFF OLD FORMATION
 PERFORATE NEW FORMATION OTHER PHYSICAL CHANGE IN WELL (SPECIFY) _____
 PLUG AND ABANDON CLEAN OUT AND REPLUG TARGET FORMATION: Marcellus ESTIMATED DEPTH: 6,750'

WELL OPERATOR: EQT Production Company DESIGNATED AGENT: Jason Ranson
ADDRESS: 115 Professional Place PO Box 280 ADDRESS: 115 Professional Place PO Box 280
Bridgeport, WV 26330 Bridgeport, WV 26330

TOPHOLE AS-DRILLED

**Erlwine 1H
Erlwine
EQT Production Company**

Tract ID.	Tax Map No.	Parcel No.	County	District	Surface Tract Owner	Acres
1	6	46	Wetzel	Proctor	Richard L. Erlwine	136.18
2	6	36	Wetzel	Proctor	Richard L. Erlwine	127.14
3	6	24	Wetzel	Proctor	George R. Baxter	83.92
4	6	24.1	Wetzel	Proctor	Robert Lee Sandridge	0.66
5	6	25	Wetzel	Proctor	Williams Ohio Valley	0.32
6	6	6	Wetzel	Proctor	Baxter Farm LLC	88.5
7	1	32	Wetzel	Proctor	Baxter Farm LLC	76.67
8	1	33	Wetzel	Proctor	William & Christina Wilkinson	0.99
9	1	29	Wetzel	Proctor	Baxter Farm LLC	2.11
10	1	N/A	Wetzel	Proctor	N/A	1.45
11	1	30	Wetzel	Proctor	Proctor Creek School	0.66
12	1	31	Wetzel	Proctor	Steven Jack & Susan Hafer	19.08
13	1	20	Wetzel	Proctor	Charles E. Frohnappel	124.67
14	1	34.1	Wetzel	Proctor	Herbert & Virginia Parsons	2.42
15	1	34	Wetzel	Proctor	Ronald J. & Linda Petrecca	29.06
16	6	52	Wetzel	Proctor	Ronald J. & Linda Petrecca	11.23
17	6	7.3	Wetzel	Proctor	Austin & Marlene Postlethwait	54.57
18	6	26.3	Wetzel	Proctor	Michael G. & Kathleen F. Baxter	18.7
19	6	26	Wetzel	Proctor	Larry K. Keene	6.26
20	6	26.4	Wetzel	Proctor	Larry K. Keene	0.44
21	6	38	Wetzel	Proctor	Ethel Anderson EST	12.56
22	6	30	Wetzel	Proctor	Albert Ray Anderson	102.63
23	6	40	Wetzel	Proctor	Kevin S. Goff	19.13
24	6	47	Wetzel	Proctor	Victor Richard Reed ET AL	5.55
25	7	34	Wetzel	Proctor	Kevin Goff	23.31
26	7	37	Wetzel	Proctor	Rost Energy Company	64.56
27	12	1	Wetzel	Proctor	Kevin Goff	28.69
28	11	5	Wetzel	Proctor	Emma L. & John J. Moore	30.34
29	11	3	Wetzel	Proctor	Christy Leek & Mary Wilson EST	52.33
30	6	45	Wetzel	Proctor	Christy Leek	29.51
31	6	45.1	Wetzel	Proctor	Donald F. & Martha J. Arrick	53.9
32	6	35	Wetzel	Proctor	Donald F. & Martha J. Arrick	58.96
33	6	23	Wetzel	Proctor	George Lemoyne Horner & Joseph Lemoyne Horner	156.55
34	6A	11	Wetzel	Proctor	Robert L. & Mary E. Stillwagner	2.38
35	6	18	Wetzel	Proctor	Douglas Farrow	0.16
36	6A	11.2	Wetzel	Proctor	Robert L. & Mary Ellen Stillwagner	0.32
37	6A	10	Wetzel	Proctor	Jay Edward & Kathleen S. Smith	3.33
38	6A	9	Wetzel	Proctor	Joyce Kay Morris	3.47
39	6A	8	Wetzel	Proctor	Candis Darlene Clark	3.67
40	6A	7	Wetzel	Proctor	Janice Capobianco	8.42
41	6	5	Wetzel	Proctor	Steven & Susan Louise Hafer	8.68
42	6	4	Wetzel	Proctor	Steven J. Hafer	6.91
43	1	27	Wetzel	Proctor	Steven J. Hafer	79.29
44	1	28	Wetzel	Proctor	Floyd R. & Mitzie Lou Cecil	87.73

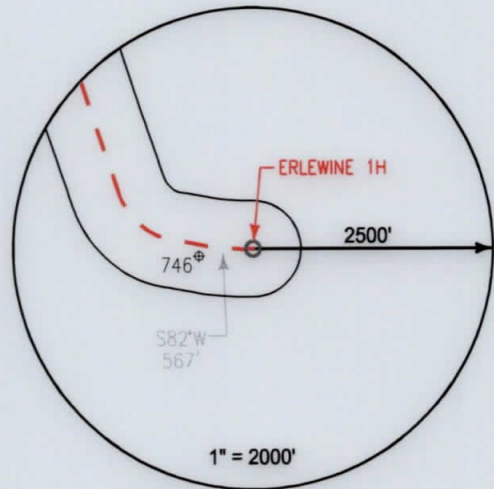

Notes:
ERLEWINE 1H As-Drilled coordinates are
 NAD 27 N: 433,674.003 E: 1,634,878.000
 NAD 27 Lat: 39.684902 Long: -80.797365
 NAD 83 UTM N: 4,392,652.021 E: 517,392.092



ERLEWINE 1H As-Drilled Landing Point coordinates are
 NAD 27 N: 434,224.703 E: 1,633,492.930
 NAD 27 Lat: 39.684902 Long: -80.802315
 NAD 83 UTM N: 4,392,812.738 E: 516,967.321

ERLEWINE 1H As-Drilled Bottom Hole coordinates are
 NAD 27 N: 438,308.783 E: 1,632,156.070
 NAD 27 Lat: 39.696061 Long: -80.807275
 NAD 83 UTM N: 4,394,050.172 E: 516,539.299

West Virginia Coordinates system of 1927 (North Zone)
 based upon Differential GPS Measurements
 Plat orientation, Corner and well ties are based upon
 the grid north meridian
 Well location references are based upon the grid north
 meridian.
 UTM coordinates are NAD83, Zone 17, Meters.


LEGEND

- ⊕ Active Well Location
- Proposed Gas Well
- Located Corner, as noted
- Surface Tract Lines
- - - - - Reference Line
- ▬ Lease Boundary
- Creek or Drain
- ⊙ WV County Route
- ⊙ WV State Route

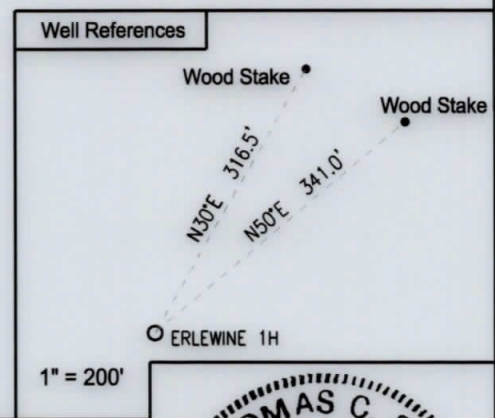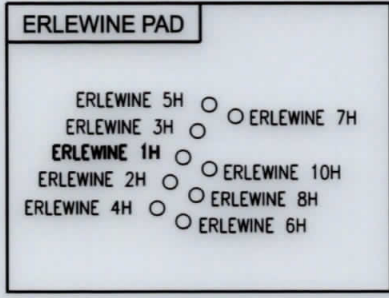

I, the undersigned, hereby certify that this plat is correct to the best of my knowledge and belief and shows all the information required by law and the regulations issued and prescribed by the Department of Environmental Protection.

Thomas C. Smalls
 L. L. S. 687

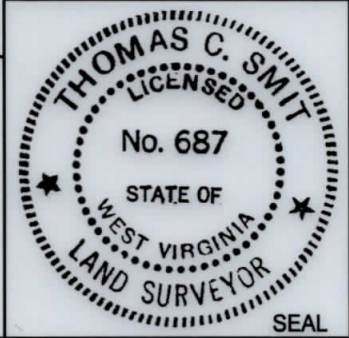

FILE NO: W2192 (BK 65-61)
 DRAWING NO: _____
 SCALE: 1" = 1000'
 MINIMUM DEGREE OF ACCURACY:
1:2500
 PROVEN SOURCE OF ELEVATION:
NGS CORS Station

STATE OF WEST VIRGINIA
 DEPARTMENT OF ENVIRONMENTAL PROTECTION
OIL AND GAS DIVISION

DATE: JUNE 25 20 19
 OPERATORS WELL NO: ERLEWINE 1H
API WELL NO
47 - 103 - 02950
 STATE COUNTY PERMIT

WELL TYPE: OIL GAS LIQUID INJECTION WASTE DISPOSAL
 (IF GAS) PRODUCTION: STORAGE DEEP SHALLOW

LOCATION ELEVATION: 1,220' WATERSHED: TRIBUTARY OF PROCTOR CREEK QUADRANGLE: NEW MARTINSVILLE 7.5'
 DISTRICT: Proctor COUNTY: Wetzel

SURFACE OWNER: Richard Erlwine ACREAGE: 135 ±
 ROYALTY OWNER: Ronald Carney, et ux LEASE NO: 873753 ACREAGE: 130.20 ±

PROPOSED WORK: DRILL CONVERT DRILL DEEPER FRACTURE OR STIMULATE PLUG OFF OLD FORMATION
 PERFORATE NEW FORMATION OTHER PHYSICAL CHANGE IN WELL (SPECIFY) _____
 PLUG AND ABANDON CLEAN OUT AND REPLUG TARGET FORMATION: Marcellus ESTIMATED DEPTH: 6,750'

WELL OPERATOR: EQT Production Company DESIGNATED AGENT: Jason Ranson
 ADDRESS: 115 Professional Place PO Box 280 ADDRESS: 115 Professional Place PO Box 280
Bridgeport, WV 26330 Bridgeport, WV 26330