

API # & DISTANCE TO WELL

103-01688	- N 85°53'36" W 280'
103-01738	- N 25°58'02" W 646'
103-01645	- S 34°46'25" W 723'
103-71815	- N 72°19'48" E 805'
103-01937	- N 89°17'07" W 918'
103-71811	- N 58°10'02" E 1160'
103-70041	- N 46°52'33" E 1206'
103-01086	- S 82°55'51" W 1399'
103-02663	- N 68°25'18" W 1454'

REFERENCE NOTE  
Boundaries as shown taken from deeds, tax maps and field locations. A full boundary survey is not expressed nor implied. All bearings are based on true north. Ownership taken from public records WETZEL County, West Virginia JANUARY 2022 State Plane Coordinates & NAD 83 Lat/Long by differential submeter mapping grade GPS Drafted by EAH

14,940' SOUTH OF LATITUDE 39°30'00"  
10,160' WEST OF LONGITUDE 80°37'30"

FILE #: TRB1

DRAWING #: 3053

SCALE: PLAT: 1" = 2000'  
TICK: 1" = 2000'


MINIMUM DEGREE

PROVEN SOURCE OF ELEVATION: SUBMETER MAPPING GRADE GPS

I, THE UNDERSIGNED, HEREBY CERTIFY THAT THIS PLAT IS CORRECT TO THE BEST OF MY KNOWLEDGE AND BELIEF AND SHOWS ALL THE INFORMATION REQUIRED BY LAW AND THE REGULATIONS ISSUED AND PRESCRIBED BY THE DEPARTMENT OF ENVIRONMENTAL PROTECTION.

Signed: [Signature]

L.L.S. #2124 : Ernest J. Benchek III

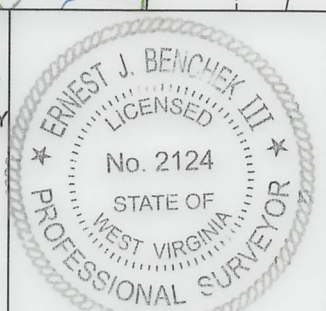

(+) DENOTES LOCATION OF WELL ON UNITED STATES TOPOGRAPHIC MAPS WVDEP

OFFICE OF OIL & GAS  
601 57TH STREET  
CHARLESTON, WV 25304

Well Type:  Oil  Waste Diposal  Production  Deep  
 Gas  Liquid Injection  Storage  Shallow

WATERSHED: FISHING CREEK

COUNTY/DISTRICT: WETZEL / GREENE

SURFACE OWNER: J.S. BOOTH ESTATE AND DALLISON LUMBER

OIL & GAS ROYALTY OWNER: JAMES K. BOOTH & JERRY MARTIN BOOTH

LEASE NUMBERS:

DATE: NOVEMBER 10, 2023

OPERATOR'S WELL #: Reilly N GRN WZ 1H

API WELL #: 47 103 03088

STATE COUNTY PERMIT

AS-BUILT ELEVATION: 1,474'

QUADRANGLE: CENTER POINT

ACREAGE: 21.00 +/-

ACREAGE: 1,331.503 +/-

DRILL  CONVERT  DRILL DEEPER  REDRILL  FRACTURE OR STIMULATE   
 PLUG OFF FORMATION  PERFORATE NEW FORMATION  PLUG & ABANDON   
 CLEAN OUT & REPLUG  OTHER CHANGE  (SPECIFY):

TARGET FORMATION: MARCELLUS

WELL OPERATOR: TRIBUNE RESOURCES, LLC

ADDRESS: 3861 AMBASSADOR CAFFERY PARKWAY SUITE 600

CITY: LAFAYETTE STATE: LA ZIP CODE: 70503

DRILLED DEPTH: TVD: 7,522' TMD: 23,092'

DESIGNATED AGENT: HARMAN BROWN

ADDRESS: 18396 MOUNTAINEER HIGHWAY

CITY: WILEYVILLE STATE: WV ZIP CODE: 26581

PROPERTY OWNER INDEX	
5-23-26	THEODORE J & PAULA ADAMEROVICH
5-23-38	J S BOOTH ESTATE
5-23-33	J S BOOTH ESTATE
5-23-37	BERYL FLUHARTY ET AL
5-26-2	STATE OF WEST VIRGINIA
5-26-4	STATE OF WEST VIRGINIA
5-26-3	STATE OF WEST VIRGINIA
5-26-15	STATE OF WEST VIRGINIA
5-27-1	STATE OF WEST VIRGINIA
5-8-46	CHARLES AND LISA CRAMER
5-9-1	LEROY WILSON ESTATE
5-8-41	CHESTER C. YEATER TRUST

LEASE INDEX			
A	MARC00702-000	H	MARC00962-001
B	MARC01113-001	I	MARC00780-001
C	MARC01045-000	J	MARC00860-001
D	MARC00746-000	K	MARC01031-001
E	MARC00741-000	L	MARC001136-000
F	MARC00764-000	M	MARC00855-001
G	MARC00751-000		

02/16/2024

FILE #: TRB1

DRAWING #: 3053

SCALE: N/A

DATE: NOVEMBER 10, 2023

OPERATOR'S WELL #: REILLY N GRN WZ 1H

API WELL #: 47 103 03088  
STATE COUNTY PERMIT