

API # & DISTANCE TO WELL

103-00900	N 02°32'00" E 1317'	103-02503	N 66°38'32" E 30'
103-02133	N 13°48'02" E 1274'	103-01771	S 74°12'42" W 1350'
095-00781	N 29°20'04" E 1192'	103-02214	N 89°48'18" E 1093'
103-01162	N 31°16'52" E 1192'	103-00880	S 26°03'05" W 497'
103-00902	N 31°08'48" W 783'	103-02393	S 50°54'40" W 734'
103-30621	N 25°03'47" E 958'	103-02505	S 55°30'57" E 768'
103-01695	N 63°02'37" W 701'	103-02134	S 08°13'42" W 499'
FOUND IN FIELD	N 53°48'23" E 258'	103-02504	S 04°29'57" W 994'
103-00781	N 74°17'48" E 80'	103-72663	S 11°01'28" W 1051'
103-00874	N 72°22'11" W 731'	103-72670	S 26°13'39" E 1101'

I, THE UNDERSIGNED, HEREBY CERTIFY THAT THIS PLAT IS CORRECT TO THE BEST OF MY KNOWLEDGE AND BELIEF AND SHOWS ALL THE INFORMATION REQUIRED BY LAW AND THE REGULATIONS ISSUED AND PRESCRIBED BY THE DEPARTMENT OF ENVIRONMENTAL PROTECTION.

Signed: *[Signature]*

L.L.S. #2124 : Ernest J. Benchek III

NOTE:
NO WATER WELLS WERE FOUND WITHIN 250' OF THE CENTER OF WELL PAD.
NO DWELLINGS WERE FOUND WITHIN 525' OF THE CENTER OF WELL PAD.

REFERENCE NOTES
Boundaries as shown taken from deeds, tax maps and field locations. A full boundary survey is not expressed nor implied. All bearings are based on true north. Computations taken from public records WETZEL County, West Virginia JULY 2018
State Plane Coordinates & NAD 83 Lat/Long by differential submeter mapping grade GPS
Drafted by: E.A.M.

FILE #: TRB1

DRAWING #: 2888

SCALE: PLAT: 1" = 2200'
TRK: 1" = 2000'

MINIMUM DEGREE OF ACCURACY: 1/200


PROVEN SOURCE OF ELEVATION: SUBMETER MAPPING GRADE GPS

DATE: MARCH 21, 2019

OPERATOR'S WELL #: WILEY N GRN WZ 3H

API WELL #: 47 103 03100 D

STATE COUNTY PERMIT

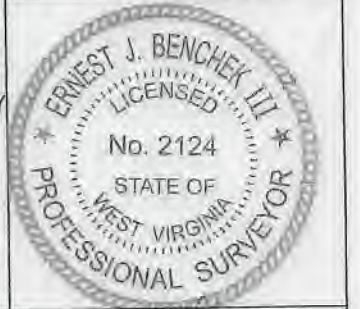

(+) DENOTES LOCATION OF WELL ON UNITED STATES TOPOGRAPHIC MAPS WYDEP

OFFICE OF OIL & GAS
601 57TH STREET
CHARLESTON, WV 25304

Well Type: Oil Waste Diposal Production Deep
 Gas Liquid Injection Storage Shallow

WATERSHED: FISHING CREEK

COUNTY/DISTRICT: WETZEL / GREEN

SURFACE OWNER: COASTAL LUMBER COMPANY

OIL & GAS ROYALTY OWNER: CHARLES W. McCOY Jr ET AL

LEASE NUMBERS: _____

DRILL CONVERT DRILL DEEPER REDRILL FRACTURE OR STIMULATE
PLUG OFF FORMATION PERFORATE NEW FORMATION PLUG & ABANDON
CLEAN OUT & REPLUG OTHER CHANGE (SPECIFY): _____

TARGET FORMATION: MARCELLUS

WELL OPERATOR: TRIBUNE RESOURCES, LLC

ADDRESS: 3861 AMBASSADOR CAFFERY PARKWAY SUITE 600

CITY: LAFAYETTE STATE: LA ZIP CODE: 70503

AS-BUILT ELEVATION: 1,286.8'

QUADRANGLE: CENTER POINT, WV - BOTTOM HOLE

ACREAGE: 154.51 +/-

ACREAGE: 1220.77 +/-

ESTIMATED DEPTH: TMD: 17,583' TVD: 7361'

DESIGNATED AGENT: HARMAN BROWN

ADDRESS: 18396 MOUNTAINEER HIGHWAY

CITY: WILEYVILLE STATE: WV ZIP CODE: 26581

WILEY N GRN WZ 3H
PINE GROVE, WV
CENTER POINT, WV

47103031000

05/24/2019

LEWIS WETZEL
PUBLIC HUNTING

PINE GROVE QUAD
CENTER POINT QUAD

LEWIS WETZEL

G R E E N

TOTAL BORED DISTANCE FROM
LP TO BH = 10,000'

WETZEL CO
TYLER CO

