


39° 30' 00"

80° 24' 30"

Latitude

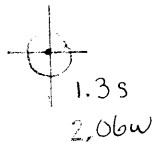

Longitude

Topo Location

7.5' Loc. _____ 15' Loc. _____
 (calc.) _____

Company South Penn Oil Co

Farm GENINE ROBINSON #60


15' Quad _____
(sec.)

7.5' Quad Wallace

District GRANT

WELL LOCATION PLAT

County 103 **Permit** 30065

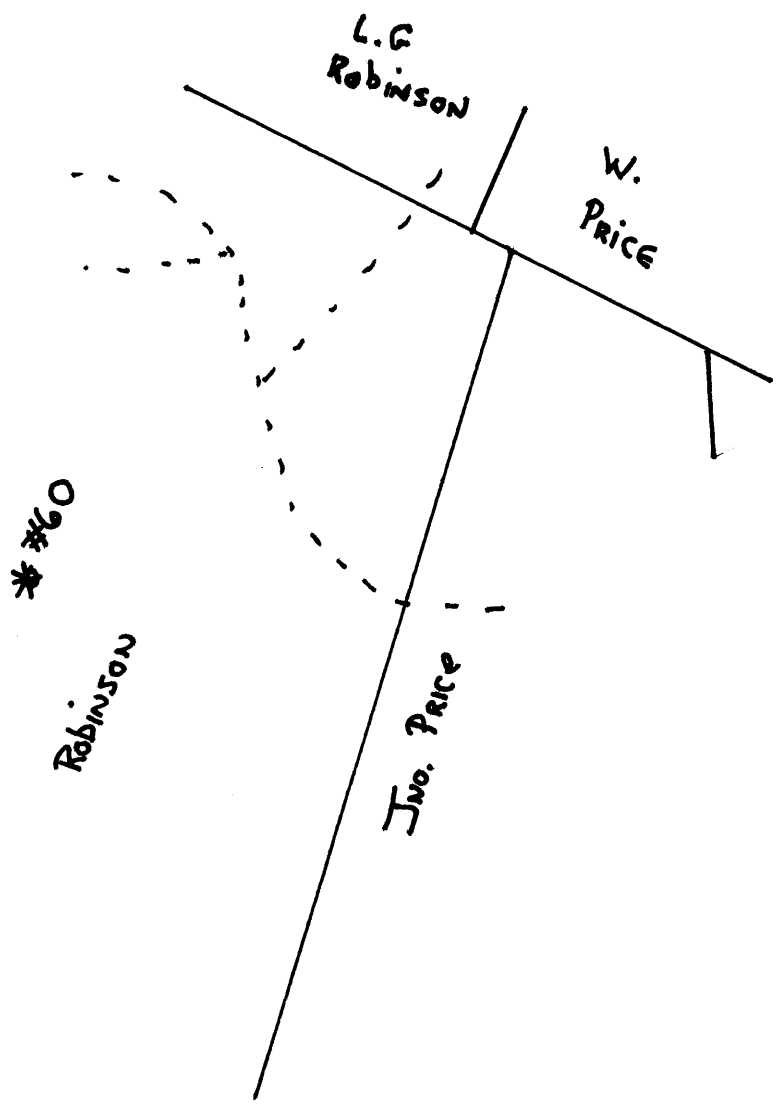

Grant District, Wetzel County, W. Va. 65A
 By South Penn Oil Co., Drawer 1255, Pittsburgh, Pa.
 On 2600 acres, surface and minerals owned by Robinson Improvement Co.,
 A. W. Lewis, The Plains, Virginia.

Elevation, 1162' L.

16' conductor; 10" casing, 210'; 8 $\frac{1}{4}$ " , 1390'; 6-5/8" , 2419'; 5-3/16" ,
 2458'. The 10" and 8 $\frac{1}{4}$ " casing has been pulled.

Coal was encountered at 1030-1035'.

Abandonment reported to Dept. of Mines Oct. 19, 1931.

Well was shot twice (depth unknown).

Oil well.

	Top.	Bottom.	Thickness.
Conductor	0	- 16	16
Bluff Sand	720	- 760	40
Pittsburgh Coal	1030	- 1035	5
Little Dunkard Sand	1380		
Big Dunkard Sand	1506	- 1714	208
Salt Sand	1915	- 2027	112
Maxton Sand	2087	- 2107	20
Big Lime	2255	- 2325	70
Big Injun Sand	2325	- 2425	100
Upper 30-Ft. Sand	2810	- 2855	45
50-Ft. Sand (gas, 2958')	2956		
Stray Sand (oil, 3105-3114')	3080	- 3132	52
Gordon Sand	3141	- 3159	18
Total depth		3180	