

STATE OF WEST VIRGINIA
DEPARTMENT OF ENVIRONMENTAL PROTECTION
OFFICE OF OIL AND GAS

AFFIDAVIT OF PLUGGING AND FILLING WELL

AFFIDAVIT SHOULD BE IN TRIPLICATE, one copy mailed to the Department, one copy to be retained by the Well Operator and the third copy (and extra copies if required) should be mailed to each coal operator at their respective addresses.

Farm name: Fairfield-Peterson Operator Well No.: 6342

LOCATION: Elevation: 1078.97 Quadrangle: WALLACE, WV 7.5'
District: Grant County: Wetzel
Latitude: _____ Feet South of 39 Deg. 29 Min. 41.5104 Sec.
Longitude: _____ Feet West of 80 Deg. 29 Min. 34.64880 Sec.

Well Type: OIL X GAS _____

Company Consolidation Coal Co. Coal Operator 1 Bridge Street Monongah, WV 26554
or Owner _____
Agent David Roddy Coal Operator _____
or Owner _____
Permit Issued Date 04/18/2019

AFFIDAVIT

STATE OF WEST VIRGINIA,
County of Monongalia ss:

Mark A. Wilson and Matthew A. Yearsley being first duly sworn according to law depose and say that they are experienced in the work of plugging and filling oil and gas wells and were employed by the above named well operator, and participated in the work of plugging and filling the above well say that said work was commenced on the 25th day of April, 2019, and the well was plugged and filled in the following manner:

TYPE	FROM	TO	PIPE REMOVED	LEFT
Thixotropic	1204'	784'		
Expandable Cement	784'	Surface		
7" casing	1074'	Unknown	82'	Unknown
16" Conductor Casing	Surface	20'	0	20'

Description of monument: 77" of 7" casing with company name, well #, API #, and date cemented. and that the work of plugging and filling said well was completed on the 14th day of May, 2019.

And further deponents saith not. Mark A. Wilson
Matthew A. Yearsley



Sworn and subscribe before me this 25th day of May, 2019

My commission expires: 9-15-22 Carol A Mayle
Notary Public

RECEIVED
Office of Oil and Gas

MAY 30 2019

Affidavit reviewed by the Office of Oil and Gas: Derek M. Haught Title: Oil & Gas Inspector

Plugging Report for MSHA

Well Number: 6342 Mine: Harrison County Mine
 Permit Number: 47-103-03292
 Date Clean Out Started: 4/25/2019
 Date Well Bore Plugged: 5/14/2019
 Pittsburgh Coal Seam: 984 ft. To 991 ft.

Plugs:	From	To	Type of Cement
	1204'	784'	Thixotropic Cement w/ Green Dye
	784'	Surface	Expandable Cement

Casing Remaining in Well Bore

	Top	Bottom	Left	Pulled
Sucker Rods				
2 3/8" tubing				
5 1/2" casing				
7" casing	1074'	Unknown	Unknown	82'
7" fiberglass				
8 5/8" casing				
10 3/4" casing				
16" Conductor	Surface	20'	20'	0


Cement:

Expandable _____ 405 _____ sacks
 Thixotropic _____ 170 _____ sacks
 Econofill _____ _____ sacks
 Mud Flush _____ 1000 _____ gal
 Other _____ _____
 Est. Top Thix _____ ft
 Did Cement Circ. _____ YES _____

Comments:

Caving: Extreme Moderate Normal
 Lost Circulation: Extreme Moderate Normal
 Difficulty in Removing Casing: Extreme Moderate Normal
 Debris in Well Bore: Wood Steel Other: _____

Surface Elevation (Surveyed) 1018.22
 Bottom of Coal Structure (Map) 105
 Difference 913.216

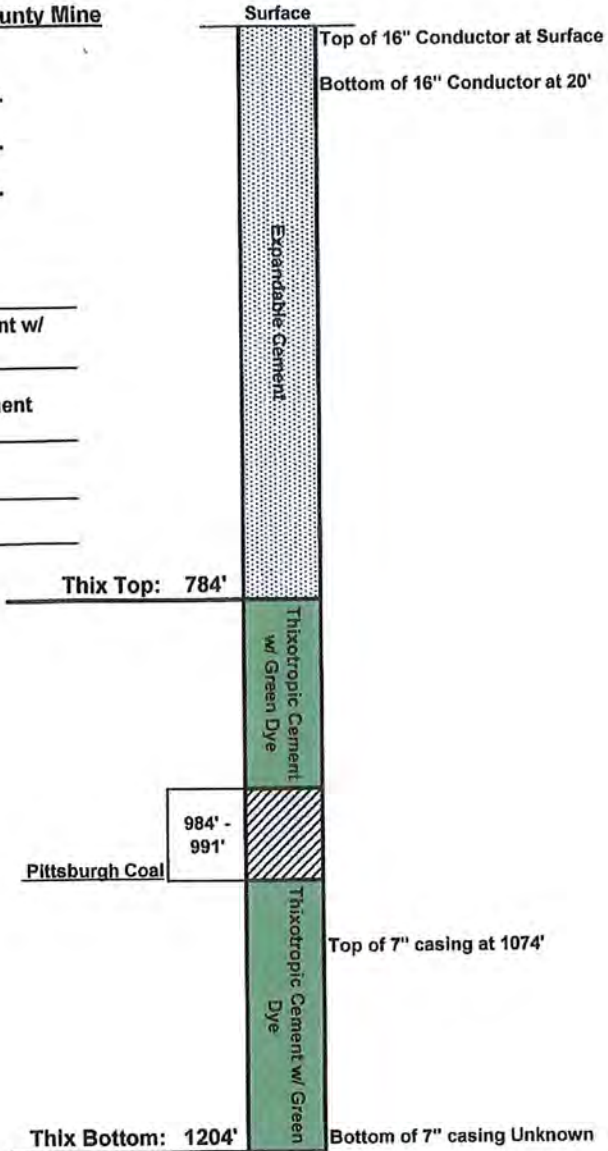

RECEIVED
 Office of Oil and Gas
 MAY 30 2019
 WV Department of
 Environmental Protection

AFFIDAVIT OF PLUGGING AND FILLING WELL

AFFIDAVIT SHOULD BE MADE IN TRIPLICATE, one copy mailed to the Division, one copy to be retained by the Well Operator and the third copy (and extra copies if required) should be mailed to each coal operator at their respective addresses.

CONSOLIDATION COAL CO.
Coal Operator or Owner
1 BRIDGE STREET MONONGAH, WV 26554
Address

CONSOLIDATION COAL CO.
Coal Operator or Owner
1 BRIDGE STREET MONONGAH, WV 26554
Address

CONSOLIDATION COAL COMPANY
Lease or Property Owner
1000 CONSOL ENERGY DRIVE CANONSBURG, PA 15317
Address

CONSOLIDATION COAL CO.
Name of Well Operator
1 BRIDGE STREET MONONGAH, WV 26554
Complete Address
WALLACE, WV 7.5'
Well Location
GRANT
District
WETZEL
County
6342
Well No.
FAIRFIELD-PETERSON
Farm

STATE INSPECTOR SUPERVISING PLUGGING Derek M. Haught

AFFIDAVIT

STATE OF WEST VIRGINIA,
County of MONONGALIA ss:
MARK A. WILSON and MATTHEW A. YEARSLEY being first duly sworn according to law depose and say that they are experienced in the work of plugging and filling oil and gas wells and were employed by Consolidation Coal Company well operator, and participated in the work of plugging and filling the above well, that said work was commenced on the 25th day of April, 2019 and that the well was plugged in the following manner:

Sand or Zone Record Formation	Filling Material	Casing/Tubing Size	Casing Pulled	Casing Left In
Cleaned a 12 1/4" hole from surface to 344'. Reduced hole to 9 7/8" at 344'. Cleaned a 9 7/8" hole from 344' to 1074'. Reduced hole to 6 1/4" hole at 1074'. Cleaned 6 1/4" hole from 1074' to 1204'. Tagged plug at 1204. Cleaned a 9 7/8" hole through the Pittsburgh Coal Seam from 984' to 991'. Pulled 82' of 7" casing from 992' to 1074' with extreme difficulty. Attempted to remove 7" casing by pulling 150% of string weight. All Attempts were unsuccessful. Left an unknown amount of 7" casing in well bore from 1074' to unknown depth. Cut 7" casing at 1202', 1140' and 1095'. Left 20' of 16" conductor from surface to 20'.		7" Casing 16" Conductor	82' 0	Unknown 20'
Cement hole from 1204' back to surface as follows: Cement from 1204' to 784' with 170 sacks of Thixotropic Cement with green dye. Cement hole from 784' to surface with 405 sacks of Expandable Cement. Cement did circulate at surface.				
Coal Seams		Description of Monument		
<u>Pittsburgh</u>	<u>984' - 991'</u>	<u>77' of 7" casing w/ company name, well number, permit number and date cemented stated on 7" casing. Well marker will be attached to cement plug at ground level.</u>		

... and that the work of plugging and filling said well was completed on the 14th day of May, 2019

And further deponents saith not.

Mark A. Wilson
Mark A. Wilson
Matthew A. Yearsley
Matthew A. Yearsley

RECEIVED
Office of Oil and Gas

Sworn to and subscribed before me this 25th day of May 2019

MAY 30 2019

Carol A. Mayle
Notary Public

WV Department of
Environmental Protection

My commission expires:



Permit No. 47-103-03292
Well No. 6342
Latitude: 39° 29' 41.5104"N
Longitude: 80° 29' 34.64880"W