


API # & DISTANCE TO WELL	
103-00900 : N 00°19'16" E 1347'	103-02503 : N 27°08'59" W 50'
103-02133 : N 11°17'02" E 1295'	103-01771 : S 76°03'25" W 1391'
095-00781 : N 26°27'55" E 1197'	103-02214 : N 87°59'28" E 1043'
103-01162 : N 28°24'13" E 1195'	103-00860 : S 32°58'58" W 494'
103-00902 : N 32°58'19" W 837'	103-02393 : S 55°14'02" W 755'
103-30621 : N 21°32'10" E 967'	103-02505 : S 55°20'43" E 709'
103-01696 : N 62°36'34" W 761'	103-02134 : S 14°48'15" W 478'
FOUND IN FIELD : N 40°29'09" E 243'	103-02504 : S 07°38'25" W 967'
103-00781 : N 26°19'07" E 60'	103-72663 : S 14°07'54" W 1031'
103-00874 : N 71°15'11" W 789'	103-72670 : S 24°31'35" E 1051'

REFERENCE NOTES
 Boundaries as shown taken from deeds, tax maps and field locations. A full boundary survey is not expressed nor implied. All bearings are based on true north. Ownership taken from public records WETZEL County, West Virginia JULY 2018
 State Plane Coordinates & NAD 83 Lat/Long by differential submeter mapping grade GPS
 Drafted by EAM

FILE #: TRB1
 DRAWING #: 2891
 SCALE: PLAT: 1" = 1800'
 TACK: 1" = 2000'
 MINIMUM DEGREE OF ACCURACY: 1/200
 PROVEN SOURCE OF ELEVATION: SUBMETER MAPPING GRADE GPS

I, THE UNDERSIGNED, HEREBY CERTIFY THAT THIS PLAT IS CORRECT TO THE BEST OF MY KNOWLEDGE AND BELIEF AND SHOWS ALL THE INFORMATION REQUIRED BY LAW AND THE REGULATIONS ISSUED AND PRESCRIBED BY THE DEPARTMENT OF ENVIRONMENTAL PROTECTION.
 Signed: *[Signature]*
 L.L.S. #2124 : Ernest J. Benchek III

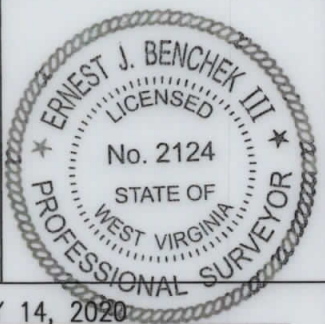

(+) DENOTES LOCATION OF WELL ON UNITED STATES TOPOGRAPHIC MAPS WVDEP
 OFFICE OF OIL & GAS
 601 57TH STREET
 CHARLESTON, WV 25304
 Well Type: Oil Waste Diposal Production Deep
 Gas Liquid Injection Storage Shallow
 WATERSHED: FISHING CREEK
 COUNTY/DISTRICT: WETZEL / GREEN
 SURFACE OWNER: COASTAL LUMBER COMPANY
 OIL & GAS ROYALTY OWNER: CHARLES W. MCCOY JR ET AL
 LEASE NUMBERS: _____

DATE: JANUARY 14, 2020
 OPERATOR'S WELL #: WILEY GRN WZ 9H
 API WELL #: 47 103
 STATE COUNTY PERMIT

AS-BUILT ELEVATION: 1,286.8'
 QUADRANGLE: PINE GROVE, WV - TOPHOLE
 CENTER POINT, WV - BOTTOM HOLE
 ACREAGE: 154.51 +/-
 ACREAGE: 5892.26 +/-

DRILL CONVERT DRILL DEEPER REDRILL FRACTURE OR STIMULATE
 PLUG OFF FORMATION PERFORATE NEW FORMATION PLUG & ABANDON
 CLEAN OUT & REPLUG OTHER CHANGE (SPECIFY): _____

TARGET FORMATION: MARCELLUS
 ESTIMATED DEPTH: TMD: 17,954' TVD: 7,357.9'
 WELL OPERATOR: TRIBUNE RESOURCES, LLC
 DESIGNATED AGENT: HARMAN BROWN
 ADDRESS: 3861 AMBASSADOR CAFFERY PARKWAY SUITE 600
 ADDRESS: 18396 MOUNTAINEER HIGHWAY
 CITY: LAFAYETTE STATE: LA ZIP CODE: 70503
 CITY: WILEYVILLE STATE: WV ZIP CODE: 26581