

WW-7
8-30-06



West Virginia Department of Environmental Protection
Office of Oil and Gas

WELL LOCATION FORM: GPS

API: 47-103-70672 WELL NO.: 6390

FARM NAME: CHAS SNODGRASS

RESPONSIBLE PARTY NAME: CONSOLIDATION COAL COMPANY

COUNTY: WETZEL DISTRICT: GRANT

QUADRANGLE: GLOVER GAP, WV 7.5'

SURFACE OWNER: WILLIAM J. ROHRIG ET. AL

ROYALTY OWNER: _____

UTM GPS NORTHING: 4,372,722 m

UTM GPS EASTING: 543,897 m GPS ELEVATION: 366 m (1200')

The Responsible Party named above has chosen to submit GPS coordinates in lieu of preparing a new well location plat for a plugging permit or assigned API number on the above well. The Office of Oil and Gas will not accept GPS coordinates that do not meet the following requirements:

- 1. Datum: NAD 1983, Zone: 17 North, Coordinate Units: meters, Altitude: height above mean sea level (MSL) – meters.
- 2. Accuracy to Datum – 3.05 meters
- 3. Data Collection Method:

Survey grade GPS _____ : Post Processed Differential _____

Real-Time Differential _____

Mapping Grade GPS X : Post Processed Differential X

Real-Time Differential _____

- 4. Letter size copy of the topography map showing the well location.


I the undersigned, hereby certify this data is correct to the best of my knowledge and belief and shows all the information required by law and the regulations issued and prescribed by the Office of Oil and Gas.

[Signature]
Signature

Professional Surveyor
Title


JUNE 10, 2019
Date

RECEIVED
Office of Oil and Gas
AUG 19 2019
WV Department of Environmental Protection

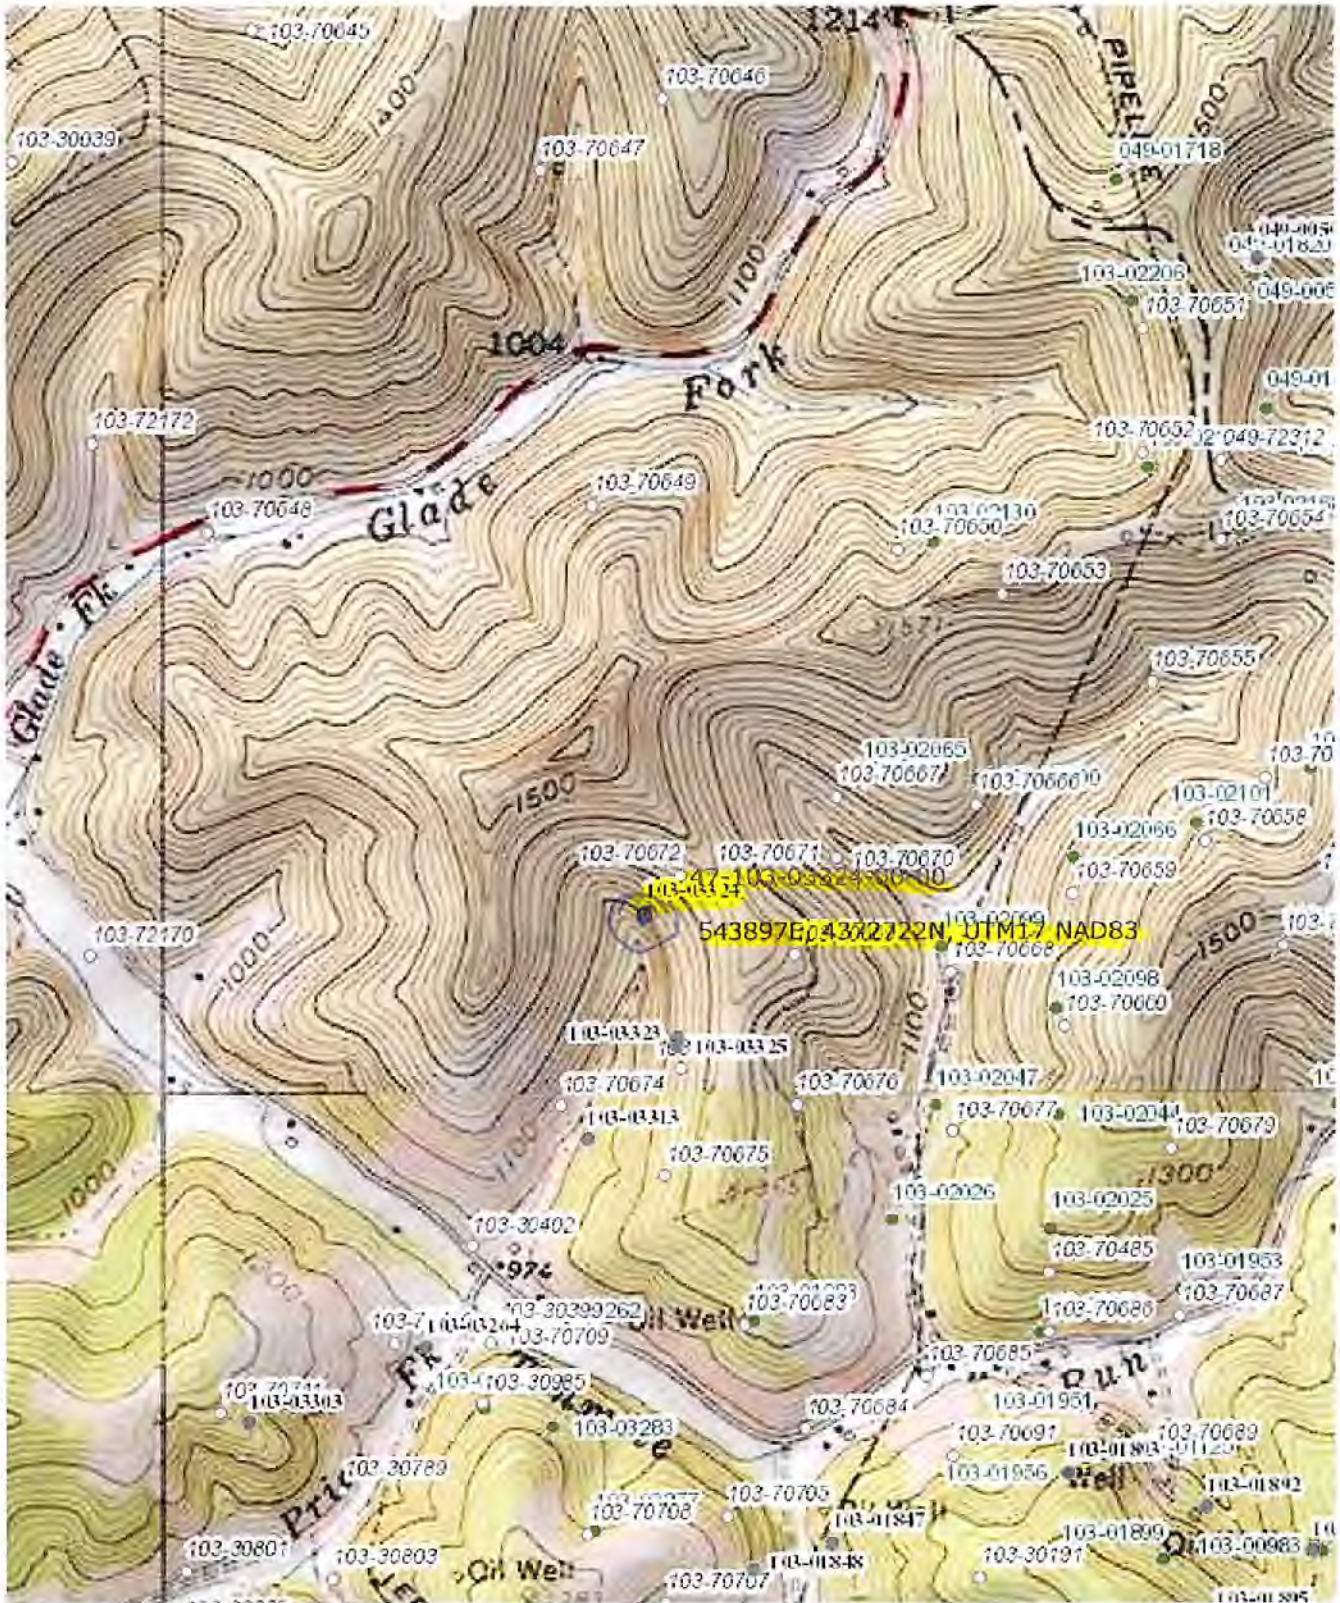

Well# 6390

GLOVER GAP WV 7.5' Quad
Scale: 1" = 2000'

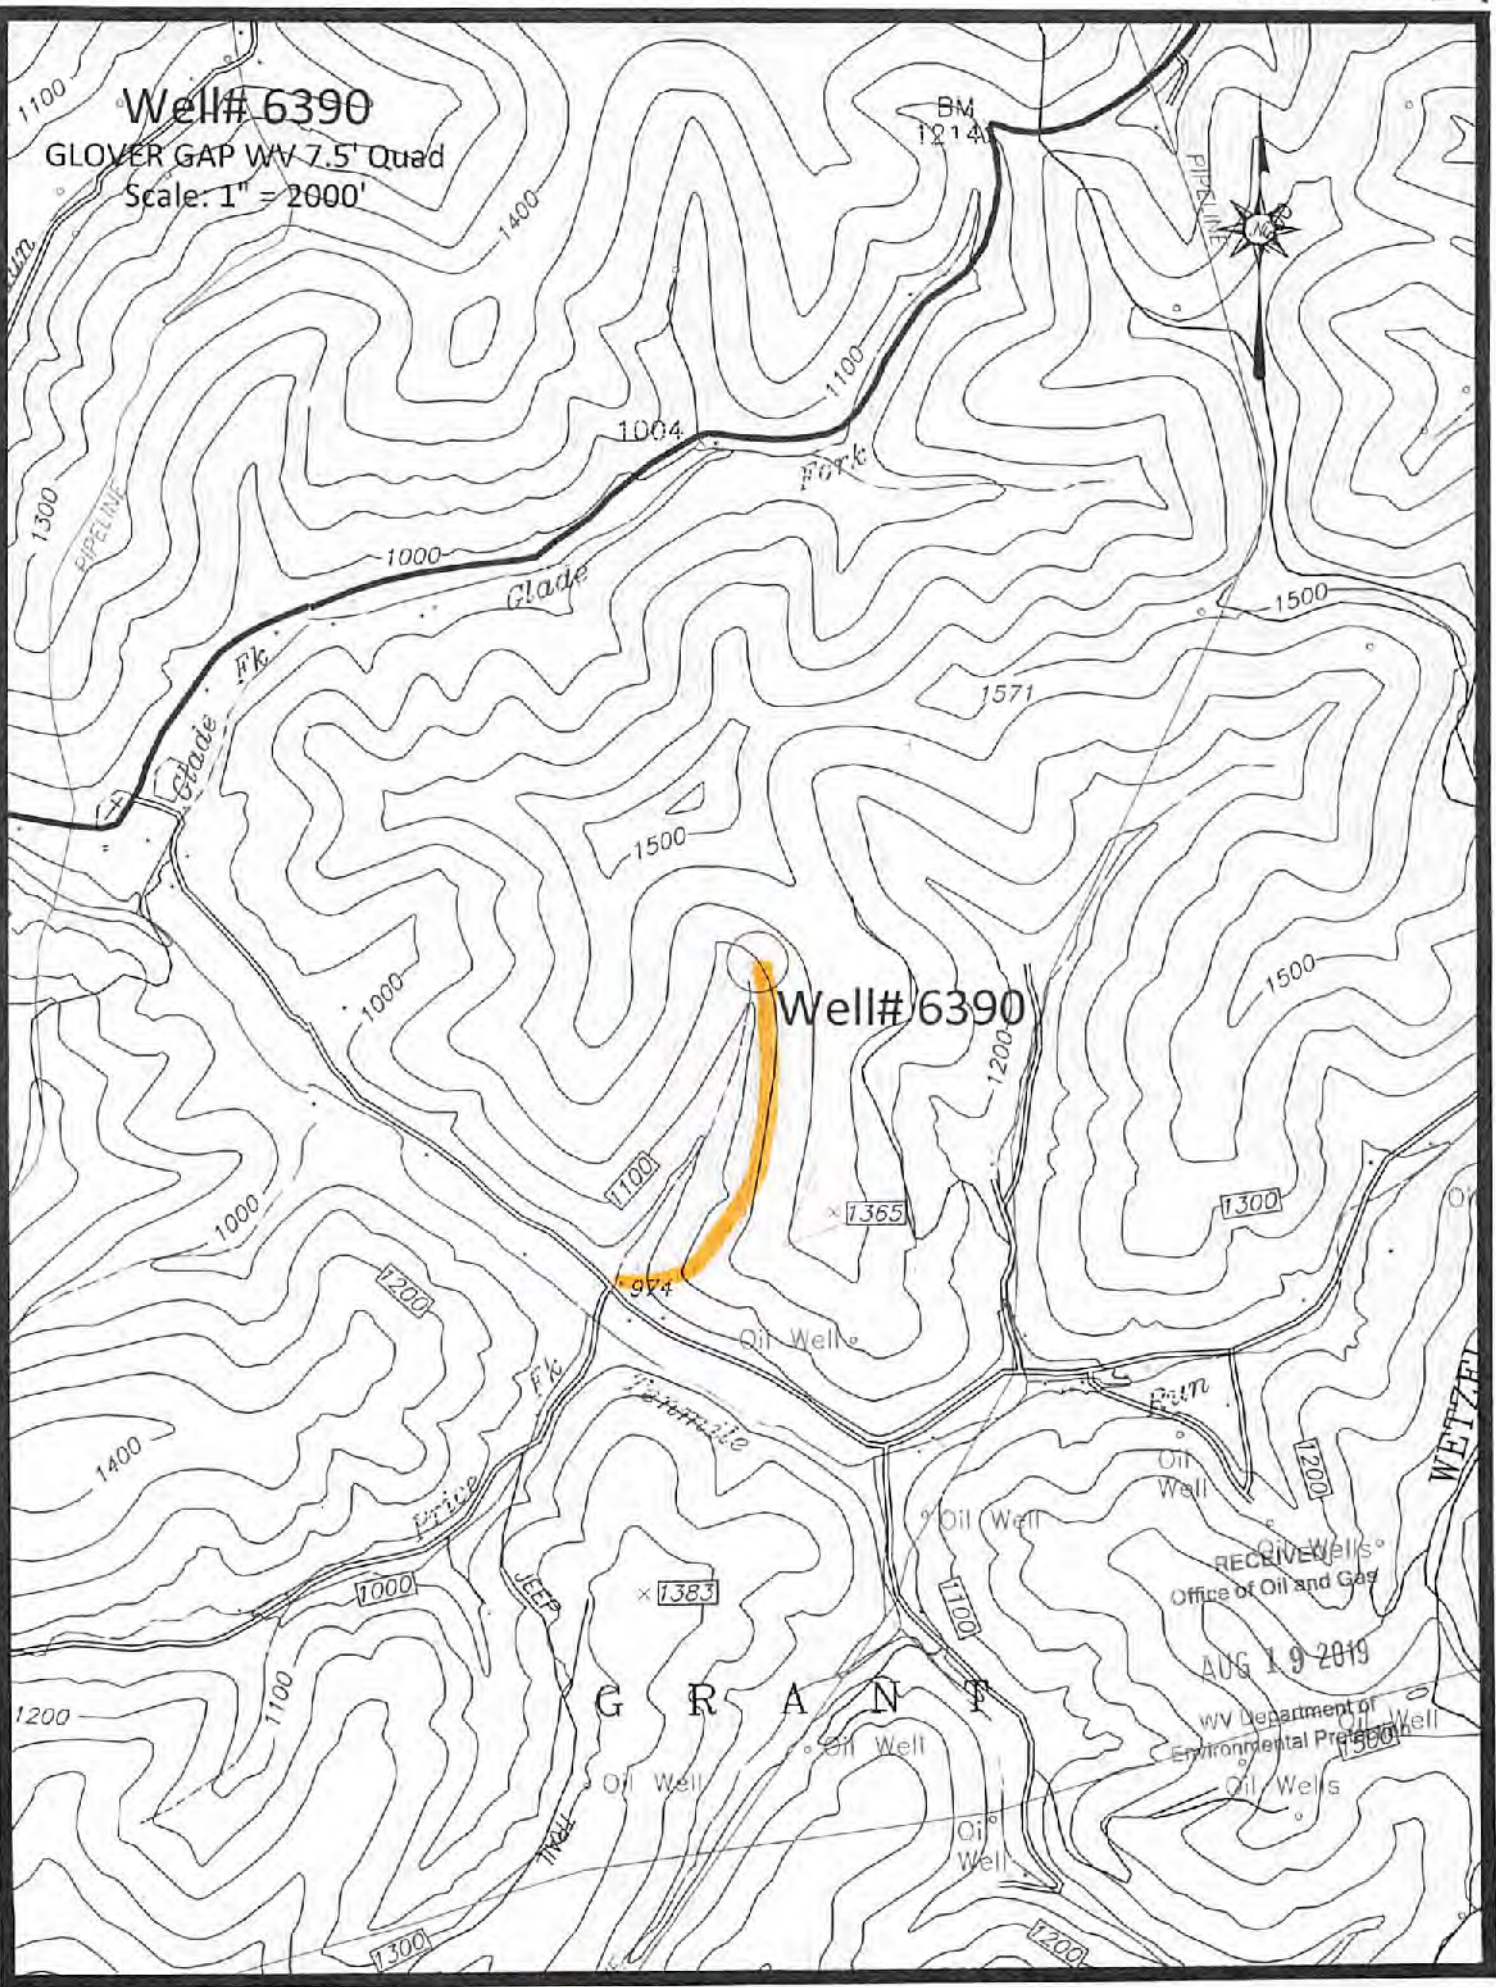

Well# 6390
GLOVER GAP WV 7.5' Quad
Scale: 1" = 500'



1500

Well# 6390

1200

1100

1365

RECEIVED
Office of Oil and Gas

AUG 19 2019

WV Department of
Environmental Protection

974

Oil Well



Area 2.1