


39°40'00"

Latitude

80°22'30"

Longitude

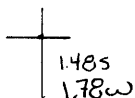

 1.485

 1.78w

Topo Location

7.5' Loc. _____ 15' Loc. _____
 _____ (calc.) _____

Company Funk & Noll

Farm AA Cunningham #1

15' Quad _____
(sec.)


7.5' Quad Hunched

District Church

WELL LOCATION PLAT

County 103 Permit 30204

30204
Church

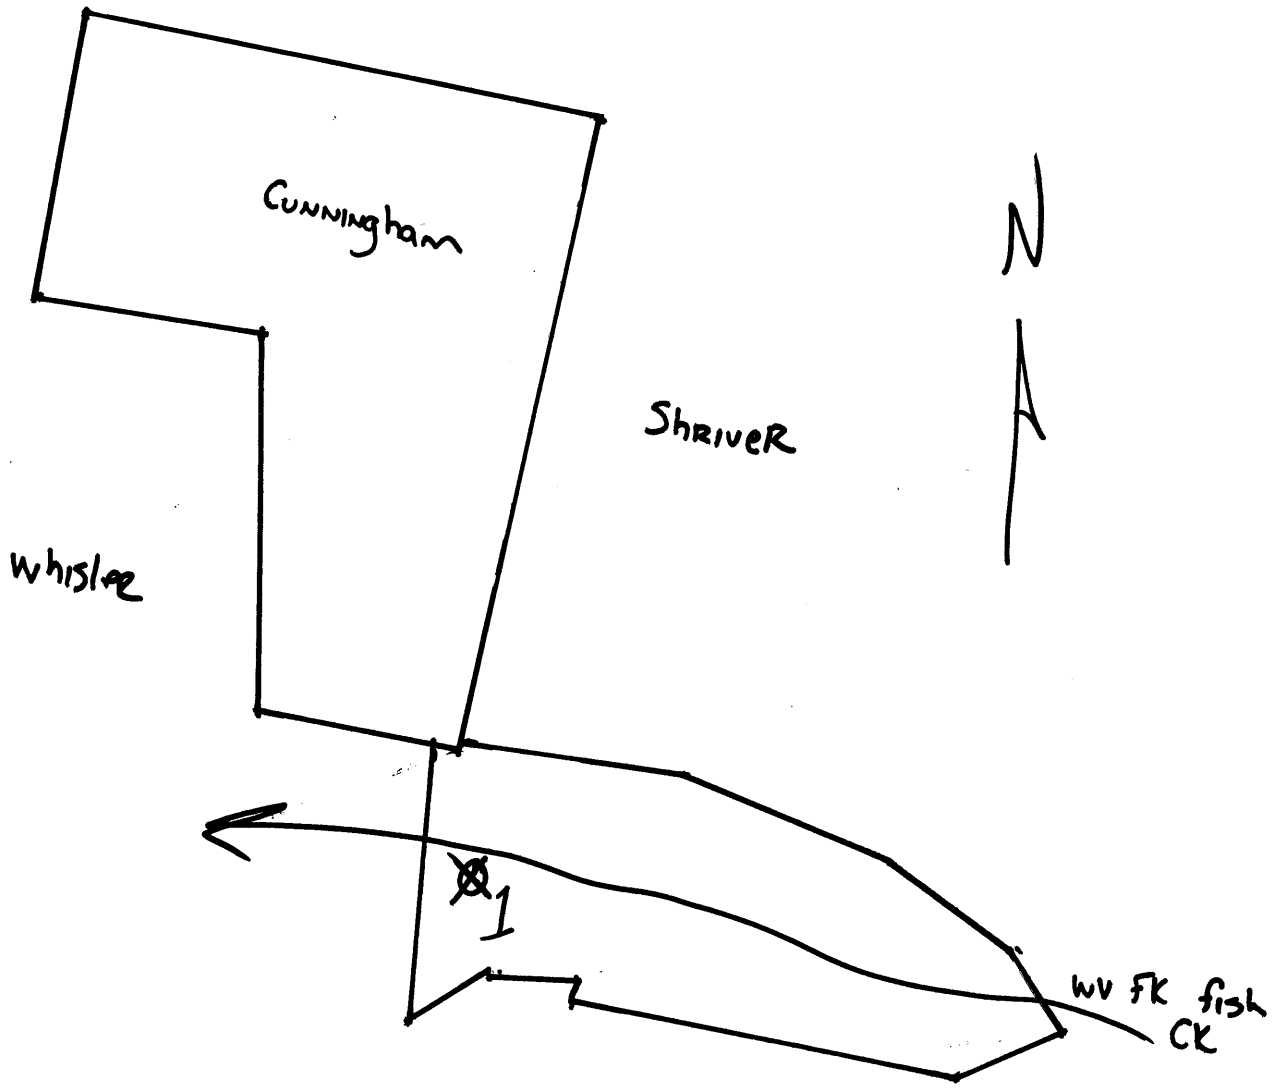

Church District, Wetzel County, W. Va.

By Tink & Null, Hundred, W. Va. (R. W. Bennett, Secy.)

Abandoned under permit Wet-204, issued 7-8-36. (July report).

On 63.64 acres, surface and minerals owned by A. A. Cunningham,
Burton, W. Va.

Drilled in 1921 before permit was required.

Elevation, 1175' L.

10" casing, 152'; 8 $\frac{1}{2}$ ", 1430'; 6 $\frac{3}{8}$ ", 2337'. No liners used.

Coal was encountered at 870-875 and 956-973'.

Abandonment reported to Dept. of Mines June 27, 1936.

Well was shot at 2993-3007'.

Producing hole.

Record to RCF from Mrs. Griffith Sept. 16, 1938.

	Top.	Bottom.	Thickness.
Bluff Sand	665	- 695	30
Mapletown (Sewickley) Coal	870	- 875	5
Pittsburgh Coal	965	- 973	8
Murphy Sand	1175	- 1210	35
Sand	1295	- 1310	15
Little Dunkard Sand	1360	- 1390	30
Big Dunkard Sand	1430	- 1553	123
Gas Sand	1575	- 1600	25
1st Salt Sand	1675	- 1690	15
2nd Salt Sand	1750	- 1833	83
Big Lime	2161	- 2215	54
Big Injun Sand (gas at 2216-18'; gas at 2325-29')	2215	- 2449	234
Slate	2449	- 2502	53
Lime	2502	- 2569	67
50-Ft. Sand	2900	- 2968	68
Slate	2968	- 2991	23
30-Ft. Sand (oil at 2993-05')	2991	- 3016	25
Gordon Stray Sand	3030	- 3060	30
Gordon Sand	3080	- 3130	50
4th Sand	3140	- 3160	20
5th Sand	3180	- 3200	20
Total depth		3216	