

WW-7
8-30-06



West Virginia Department of Environmental Protection
Office of Oil and Gas

WELL LOCATION FORM: GPS

API: 47-103- WELL NO.: 7274B
 FARM NAME: B. W. PETERSON
 RESPONSIBLE PARTY NAME: CONSOLIDATION COAL COMPANY
 COUNTY: WETZEL DISTRICT: GRANT
 QUADRANGLE: FOLSOM W.VA
 SURFACE OWNER: COASTAL FOREST RESOURCES COMPANY
 ROYALTY OWNER: _____
 UTM GPS NORTHING: 4,372,292 m (1086')
 UTM GPS EASTING: 540,839 m GPS ELEVATION: 331 m

The Responsible Party named above has chosen to submit GPS coordinates in lieu of preparing a new well location plat for a plugging permit or assigned API number on the above well. The Office of Oil and Gas will not accept GPS coordinates that do not meet the following requirements:

1. Datum: NAD 1983, Zone: 17 North, Coordinate Units: meters, Altitude: height above mean sea level (MSL) - meters.
2. Accuracy to Datum - 3.05 meters
3. Data Collection Method:

Survey grade GPS : Post Processed Differential _____
 Real-Time Differential

Mapping Grade GPS _____ : Post Processed Differential _____
 Real-Time Differential _____

4. **Letter size copy of the topography map showing the well location.**

I the undersigned, hereby certify this data is correct to the best of my knowledge and belief and shows all the information required by law and the regulations issued and prescribed by the Office of Oil and Gas.

Signature


Professional Surveyor

Title

OCTOBER 1, 2020

Date

Well# 7274B
FOLSOM WV 7.5' Quad
Scale: 1" = 2000'

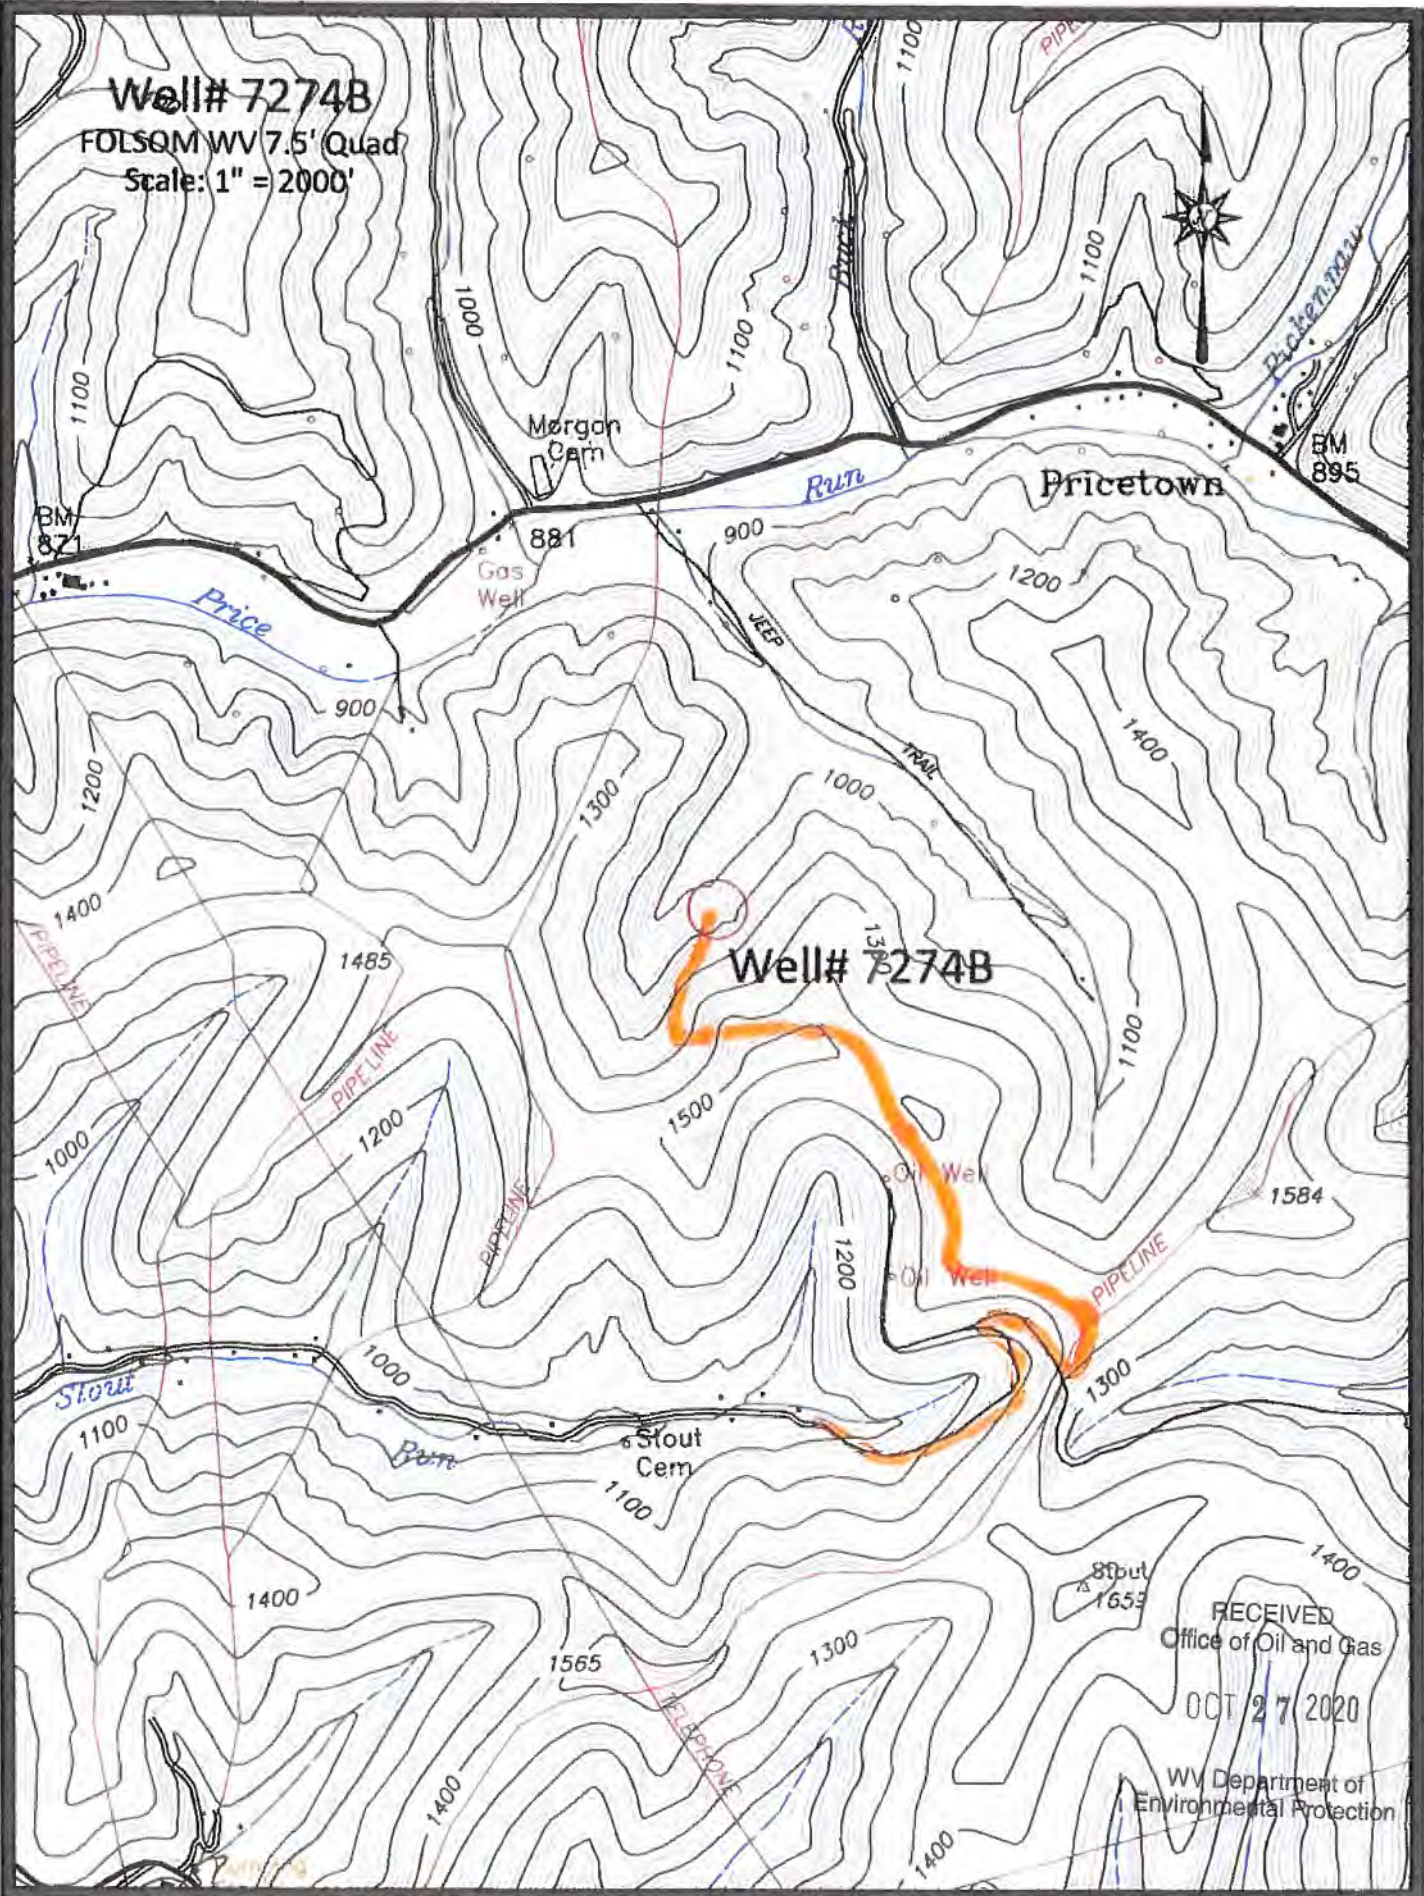

RECEIVED
Office of Oil and Gas

OCT 27 2020

WV Department of
Environmental Protection