



---

west virginia department of environmental protection

---

Office of Oil and Gas  
601 57<sup>th</sup> Street, S.E.  
Charleston, WV 25304  
(304) 926-0450  
fax: (304) 926-0452

Harold D. Ward, Cabinet Secretary  
[www.dep.wv.gov](http://www.dep.wv.gov)

Wednesday, October 11, 2023  
PERMIT MODIFICATION APPROVAL  
Horizontal 6A / New Drill

EQT PRODUCTION COMPANY  
400 WOODLIFF DR.

CANONSBURG, PA 15317

Re: Permit Modification Approval for HAGGARD 8H  
47-103-03430-00-00

**Adding an AST to the pad**

EQT PRODUCTION COMPANY

The Office of Oil and Gas has reviewed the attached permit modification for the above referenced permit. The attached modification has been approved and well work may begin. Please be reminded that the oil and gas inspector is to be notified twenty-four (24) hours before permitted well work is commenced.

If there are any questions, please feel free to contact me at (304) 926- 0450.


A blue ink signature of James A. Martin, Chief, is written over a white background.

James A. Martin  
Chief

Operator's Well Number: HAGGARD 4H  
Farm Name: AMIE LEE HENDERSON  
U.S. WELL NUMBER: 47-103-03430-00-00  
Horizontal 6A New Drill  
Date Modification Issued: 10/11/2023

Promoting a healthy environment.

10/13/2023

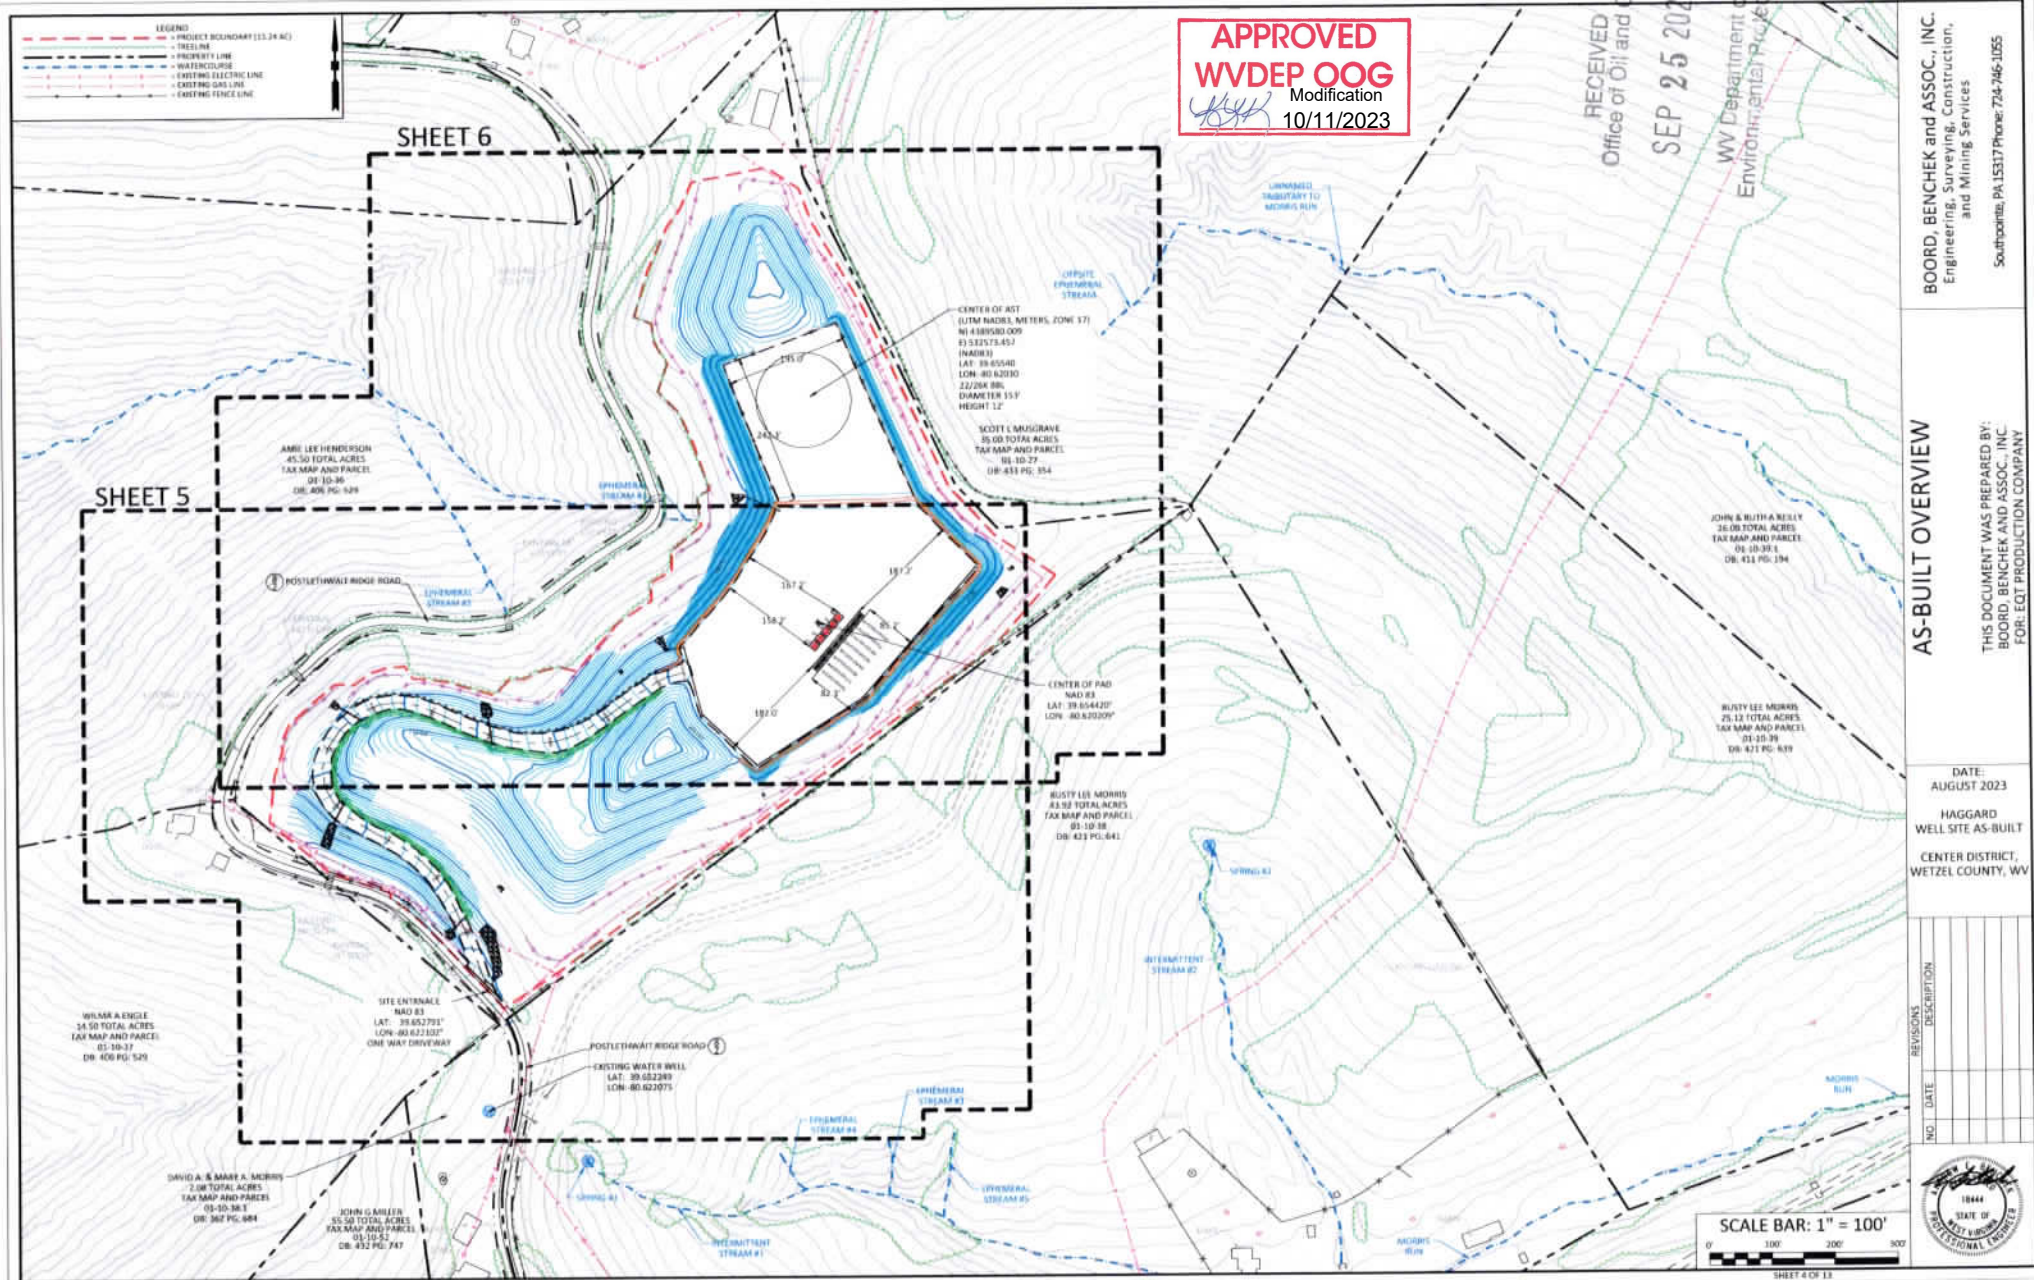


**BOORD, BENCHEK and ASSOC., INC.**  
 Engineering, Surveying, Construction,  
 and Mining Services  
 Southpointe, PA 15317 Phone: 724-746-1055

**AS-BUILT OVERVIEW**

THIS DOCUMENT WAS PREPARED BY:  
**BOORD, BENCHEK and ASSOC., INC.**  
 FOR: EQT PRODUCTION COMPANY

DATE:  
 AUGUST 2023  
 HAGGARD  
 WELL SITE AS-BUILT  
 CENTER DISTRICT,  
 WETZEL COUNTY, WV

REVISIONS	
NO.	DESCRIPTION

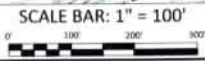

SHEET 4 OF 13  
 Stephen Mccoy Digitally signed by Stephen Mccoy  
 Date: 2023.08.11 14:15:47 -0400