

WW-7
8-30-06



West Virginia Department of Environmental Protection
Office of Oil and Gas

WELL LOCATION FORM: GPS

API: 47-103-70199 WELL NO.: 7253

FARM NAME: I. D. MORGAN

RESPONSIBLE PARTY NAME: WEST VIRGINIA LAND RESOURCES INC.

COUNTY: WETZEL DISTRICT: GRANT

QUADRANGLE: BIG RUN W.VA

SURFACE OWNER: JOHN H. & PAMELA J. MELVIN

ROYALTY OWNER: _____

UTM GPS NORTHING: 4,372,845 m

UTM GPS EASTING: 540,077 m GPS ELEVATION: 268 m ^{879'}

The Responsible Party named above has chosen to submit GPS coordinates in lieu of preparing a new well location plat for a plugging permit or assigned API number on the above well. The Office of Oil and Gas will not accept GPS coordinates that do not meet the following requirements:

1. Datum: NAD 1983, Zone: 17 North, Coordinate Units: meters, Altitude: height above mean sea level (MSL) – meters.
2. Accuracy to Datum – 3.05 meters
3. Data Collection Method:

Survey grade GPS _____: Post Processed Differential _____

Real-Time Differential _____

Mapping Grade GPS X: Post Processed Differential X

Real-Time Differential _____

4. Letter size copy of the topography map showing the well location.

I the undersigned, hereby certify this data is correct to the best of my knowledge and belief and shows all the information required by law and the regulations issued and prescribed by the Office of Oil and Gas.

[Signature]
Signature

Professional Surveyor
Title

FEBRUARY 5, 2022
Date

RECEIVED
Office of Oil and Gas

FEB 25 2022

WV Department of
Environmental Protection



47103034910

32° 30"

37° 30"

37° 45"

37° 30"

39° 30"

39° 30'


39

32° 30"

40

41

80° 30'

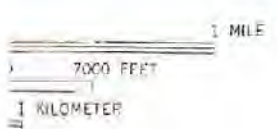

STATE LOCATION

ROAD CLASSIFICATION

- Heavy-duty Light-duty
- Medium-duty Unimproved dirt

Slate Route

WV Department of Environmental Protection

BIG RUN, W. VA.
SE 1/4 LITTLETON 15' 03/11/2022
N3930—W8030/7.5

RECEIVED
Office of Oil and Gas
FEB 25 2022

DS


Revised to show in purple compiled in cooperation with

4710803491
4710303491P

Well# 7253

BIG RUN WV 7.5' Quad

Scale: 1" = 2000'

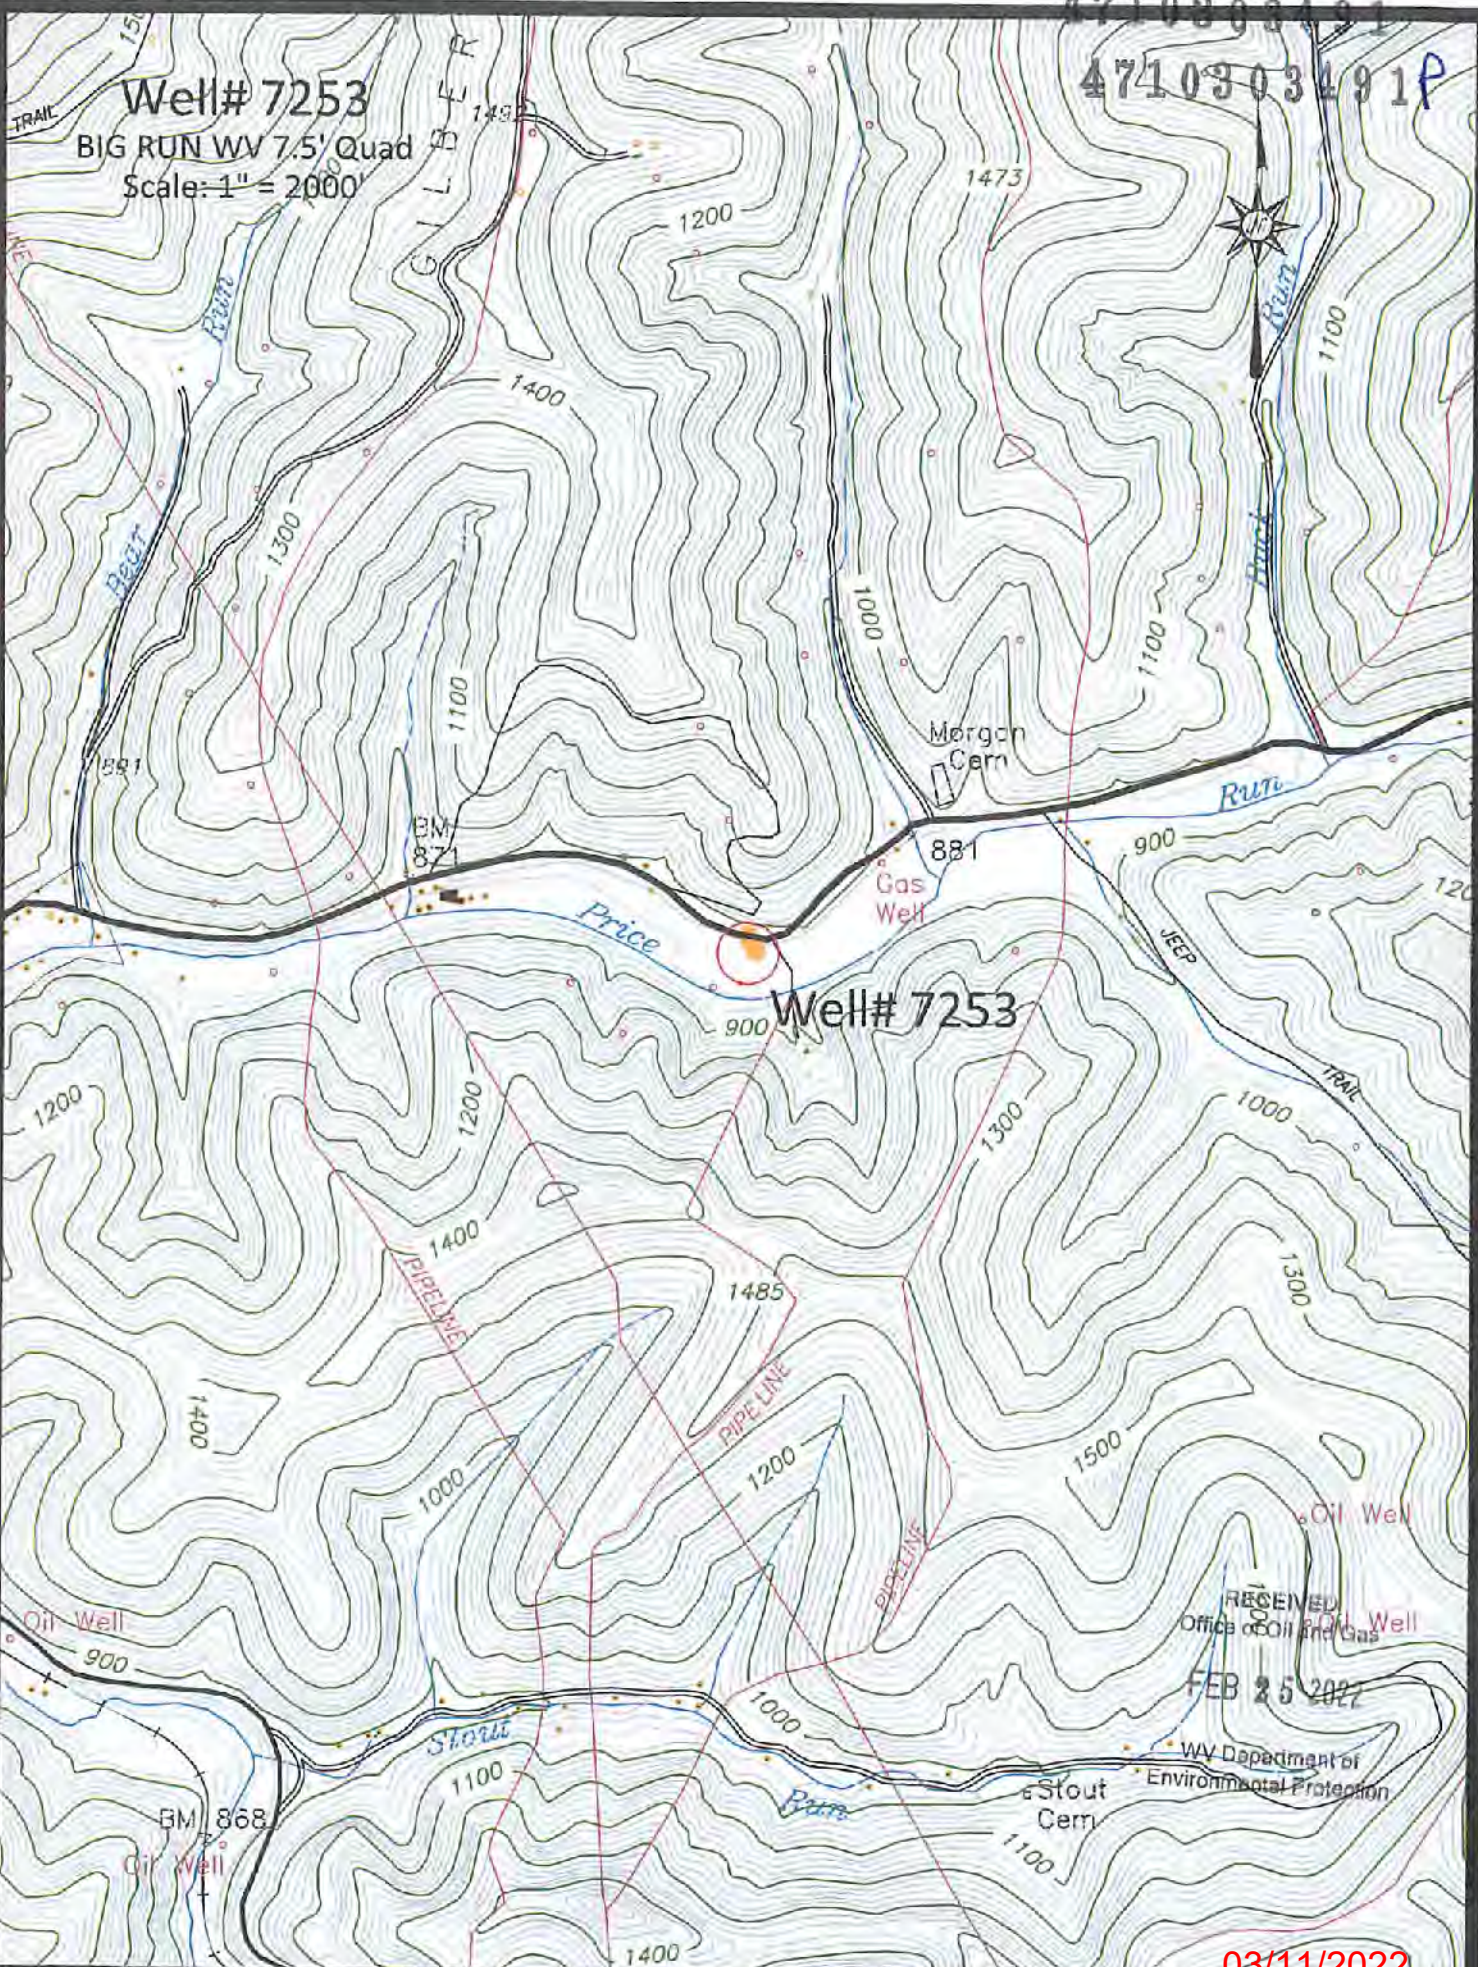

Well# 7253

RECEIVED
Office of Oil and Gas

FEB 25 2022

WV Department of
Environmental Protection

03/11/2022

Access Road

Well# 7253

BIG RUN WV 7.5' Quad

Scale: 1" = 500'



Morgan Cem

881

Gas Well

Price

Well# 7253

900

1200

1300

400

1485

RECEIVED
Office of Oil and Gas

FEB 25 2022

WV Department of
Environmental Protection

03/11/2022

 Access Road