

Antero Resources
Well No. Jiffy 1H
As-Drilled
Antero Resources Corporation

Page 1 of 2

As-Drilled
 Well No. Jiffy
 Unit 1H




Top Hole Coordinates, As-drilled data, and information was provided by Antero Resources Corporation. Allegheny Surveys Inc. (ASI) is not certifying the data and information provided. ASI is not responsible for any errors or inaccuracies with the data and information that has been provided.

I, the undersigned, hereby certify that this plat is correct to the best of my knowledge and belief and shows all the information required by law and the rules issued and prescribed by the Department of Environmental Protection.

Bradley D. Miller
 Bradley D. Miller, P.S. 2167



Note: 0 water wells were found within 2000' of proposed well. No occupied dwellings or buildings 2,500 square feet or larger used to house or shelter dairy cattle or poultry husbandry are located within 625' of the center of the well pad.

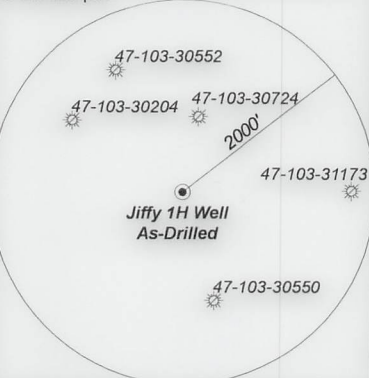

Bearing	Dist.
L1 N 83°23' E	1,609.5'
L2 N 46°06' W	2,725.1'
L3 N 08°02' W	2,509.2'
L4 N 16°48' E	2,439.2'

- Legend**
- Proposed gas well
 - ⊗ Monument, as noted
 - ☼ Existing Well, as noted
 - ☼ Digitized Well, as noted
 - Creek or Drain
 - Road
 - Railroad
 - Surface boundary (approx.)
 - Interior surface tracts (approx.)

7,343' to Bottom Hole


1,567' to Top Hole

TOP HOLE LATITUDE 39 - 35 - 00
 BTM HOLE LATITUDE 39 - 32 - 30

Notes
 West Virginia Coordinate System of 1927, North Zone based upon Differential GPS Measurements.
 Well No. Jiffy Unit 1H Top Hole coordinates are
 N: 391,161.66' Latitude: 39°34'03.43"
 E: 1,657,798.36' Longitude: 80°42'50.02"
 Bottom Hole coordinates are
 N: 376,047.50' Latitude: 39°31'34.82"
 E: 1,663,573.46' Longitude: 80°41'33.71"
 UTM Zone 17, NAD 1983
 Top Hole Coordinates Bottom Hole Coordinates
 N: 4,379,817.063m N: 4,375,241.814m
 E: 524,590.780m E: 526,426.916m
 Plat orientation and corner and well references are based upon the grid north meridian.
 Well location references are based upon the magnetic meridian.

TOP HOLE LONGITUDE 80 - 42 - 30
 BTM HOLE LONGITUDE 80 - 40 - 00
 5,724' to Top Hole
 5,583' to Bottom Hole

Notes:
 Well No. Jiffy Unit 1H As-Drilled POE Coordinates
 WV Coordinate System of 1927, North Zone
 N: 391,070.16'
 E: 1,658,664.43'
 Latitude: 39°34'02.64"
 Longitude: 80°42'38.94"
 UTM Zone 17, NAD 1983
 N: 4,379,793.598m
 E: 524,855.104m

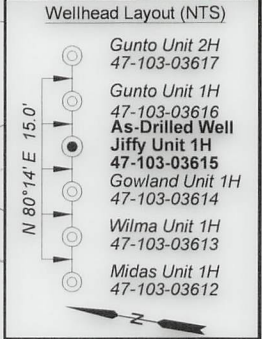

STATE OF WEST VIRGINIA
 DEPARTMENT OF ENVIRONMENTAL PROTECTION
OIL AND GAS DIVISION

DATE: September 9 20 24
 OPERATOR'S WELL NO. Jiffy 1H
 API WELL NO
47 - 103 - 03615
 STATE COUNTY PERMIT

FILE NO: 232-34-G-23
 DRAWING NO: Jiffy 1H As-Drilled Plat
 SCALE: 1" = 2000'
 MINIMUM DEGREE OF ACCURACY:
Submeter
 PROVEN SOURCE OF ELEVATION:
WVDOT, Harrisville, WV

WELL TYPE: OIL GAS LIQUID INJECTION WASTE DISPOSAL
 (IF GAS) PRODUCTION: STORAGE DEEP SHALLOW
 LOCATION: ELEVATION: As-Built: 1,248' WATERSHED: Fishing Creek QUADRANGLE: Pine Grove
 DISTRICT: Green Dallison Lumber COMPANY: Wetzel COUNTY: Wetzel DATE: 01/17/2025
 SURFACE OWNER: Company ACREAGE: 51.5
 ROYALTY OWNER: Jenkins Miller LEASE NO: _____ ACREAGE: 200
 PROPOSED WORK: DRILL CONVERT DRILL DEEPER FRACTURE OR STIMULATE PLUG OFF OLD FORMATION
 PERFORATE NEW FORMATION OTHER PHYSICAL CHANGE IN WELL (SPECIFY) As-Drilled
 PLUG AND ABANDON CLEAN OUT AND REPLUG TARGET FORMATION: Marcellus Shale ESTIMATED DEPTH: 7,193' TVD
23,207' MD

WELL OPERATOR: Antero Resources Corporation DESIGNATED AGENT: Kevin Ellis
 ADDRESS: 1615 Wynkoop Street ADDRESS: 535 White Oaks Blvd.
Denver, CO 80202 Bridgeport, WV 26330



Leases	
A	Jenkins Miller
B	Eddie D. Dallison
C	J.B. Holtzclaw
D	Albert J. Moore, et ux, et al
E	WVDNR
F	Coastal Forest Resources Co.
G	CSX Transportation, Inc.
H	Jeffrey T. Hayes
I	Tribune Resources Minerals, LLC
J	Thomas Cunningham, et ux
K	Shiben Estates Inc.
L	BRC Appalachian Minerals I, LLC
M	Shiben Estates Inc.
N	Antero Minerals, LLC
O	Tribune Resources Minerals, LLC
P	Clay D.C. Dallison, et al



ID	TM-Par	Owner	Bk/Pg	Acres
1	14-19	Dallison Lumber Company	357/267	51.50
2	13-40	Kenneth E. & Vicky A. VanDyne	357/204	42.33
3	14-20	Dallison Lumber Co.	357/270	109.91
4	14-34	Dearld T. Mason	292/646	41.00
5	14-20.1	David A. Burtrand, et al	435/879	2.00
6	14-44	Barbara Jo Leek, et al	360/141	0.25
7	14-42	Karen King, et al	WB96/811	2.87
8	14-43	Melvin G. Leek	397/499	0.60
9	14-63	Melvin G. Leek	397/499	0.50
10	14-41	Amy J. Byard	389/385	1.00
11	14-43.2	Ronald Leek	360/225	0.44
12	14-43.1	Ronald Leek	301/668	0.58
13	14-62	Brian Lowe	427/299	2.00
14	14-60	Amy J. Byard	389/385	21.25
15	17-10	Coastal Forest Resources	444/105	90.00
16	17-5	Coastal Forest Resources	444/105	90.00
17	17-21	Pauline E. Hayes	420/626	83.30
18	17-32	Pauline E. Hayes	420/626	79.25
19	17-40	Heartland Forest Land Fund VII LP	431/936	120.00
20	18-4	Barbara D. Cunningham	291/112	212.80
21	17-41	Heartland Forest Land Fund VII, LP	431/936	0.94
22	18-6	Barbara D. Cunningham	291/112	56.80
23	17-51	Linda K. Ice & Harry G. Witcherman Jr.	WB66/545	156.00
24	18-8	Linda K. Ice & Harry G. Wichterman Jr.	W66/545	23.40
25	21-24	Linda Ice Long	431/249	17.95
26	20-48	Charles R. Kuhn & William J. Shrum	411/688	30.00
27	21-4	Michael & Janet Miller	282/45	23.06
28	21-1	Lucile Olga Noland, et al	157/348	3.30
29	21-7	Francis & Patricia Fluharty	436/793	14.14
30	21-7.5	Kelly L. Fluharty	431/816	1.50
31	21-7.4	Charles L. & Joyce Fluharty	396/62	1.50
32	21-7.2	Francis L. & Patricia Fluharty	296/86	0.92
33	21-7.1	Robert D. & Gloria Fluharty	296/83	1.33
34	21-7.8	Robert & Gloria Fluharty	436/808	0.25
35	21-7.3	Roger D. & Janet Fluharty	296/89	1.53
36	21-7.6	Roger & Janet Fluharty	436/803	1.83
37	21-7.7	Robert & Gloria Fluharty	436/808	5.44
38	21-7.9	Charles Fluharty	439/535	1.97
39	21-9	Kyle R. & Lauren Fluharty	439/308	45.90
40	21-11	Unknown	---/---	6.8
41	21-10	Pine Church of Christ	200/111	0.87
42	21-3	State of WV	207/239	5228.5

FILE NO: 232-34-G-23
DRAWING NO: Jiffy 1H As-Drilled Plat
SCALE: 1" = 2000'
MINIMUM DEGREE OF ACCURACY:
Submeter
PROVEN SOURCE OF ELEVATION:
WVDOT, Harrisville, WV

STATE OF WEST VIRGINIA
DEPARTMENT OF ENVIRONMENTAL PROTECTION
OIL AND GAS DIVISION

DATE: September 9 20 24
OPERATOR'S WELL NO. Jiffy 1H
API WELL NO
47 - 103 - 03615
STATE COUNTY PERMIT

WELL TYPE: OIL GAS LIQUID INJECTION WASTE DISPOSAL
(IF GAS) PRODUCTION: STORAGE DEEP SHALLOW
LOCATION: ELEVATION: As-Built: 1,248' WATERSHED: Fishing Creek QUADRANGLE: Pine Grove
DISTRICT: Green Dallison Lumber COMPANY COUNTY: Wetzel 01/17/2025
SURFACE OWNER: Jenkins Miller ACREAGE: 51.5
ROYALTY OWNER: Jenkins Miller LEASE NO: ACREAGE: 200
PROPOSED WORK: DRILL CONVERT DRILL DEEPER FRACTURE OR STIMULATE PLUG OFF OLD FORMATION
 PERFORATE NEW FORMATION OTHER PHYSICAL CHANGE IN WELL (SPECIFY) As-Drilled
 PLUG AND ABANDON CLEAN OUT AND REPLUG TARGET FORMATION: Marcellus Shale ESTIMATED DEPTH: 7,193' TVD
23,207' MD

WELL OPERATOR: Antero Resources Corporation DESIGNATED AGENT: Kevin Ellis
ADDRESS: 1615 Wynkoop Street ADDRESS: 535 White Oaks Blvd.
Denver, CO 80202 Bridgeport, WV 26330