


47 1 0 3 0 3 7 3 1

Well# 7339

BIG RUN WV 7.5' Quad

Scale: 1" = 500'

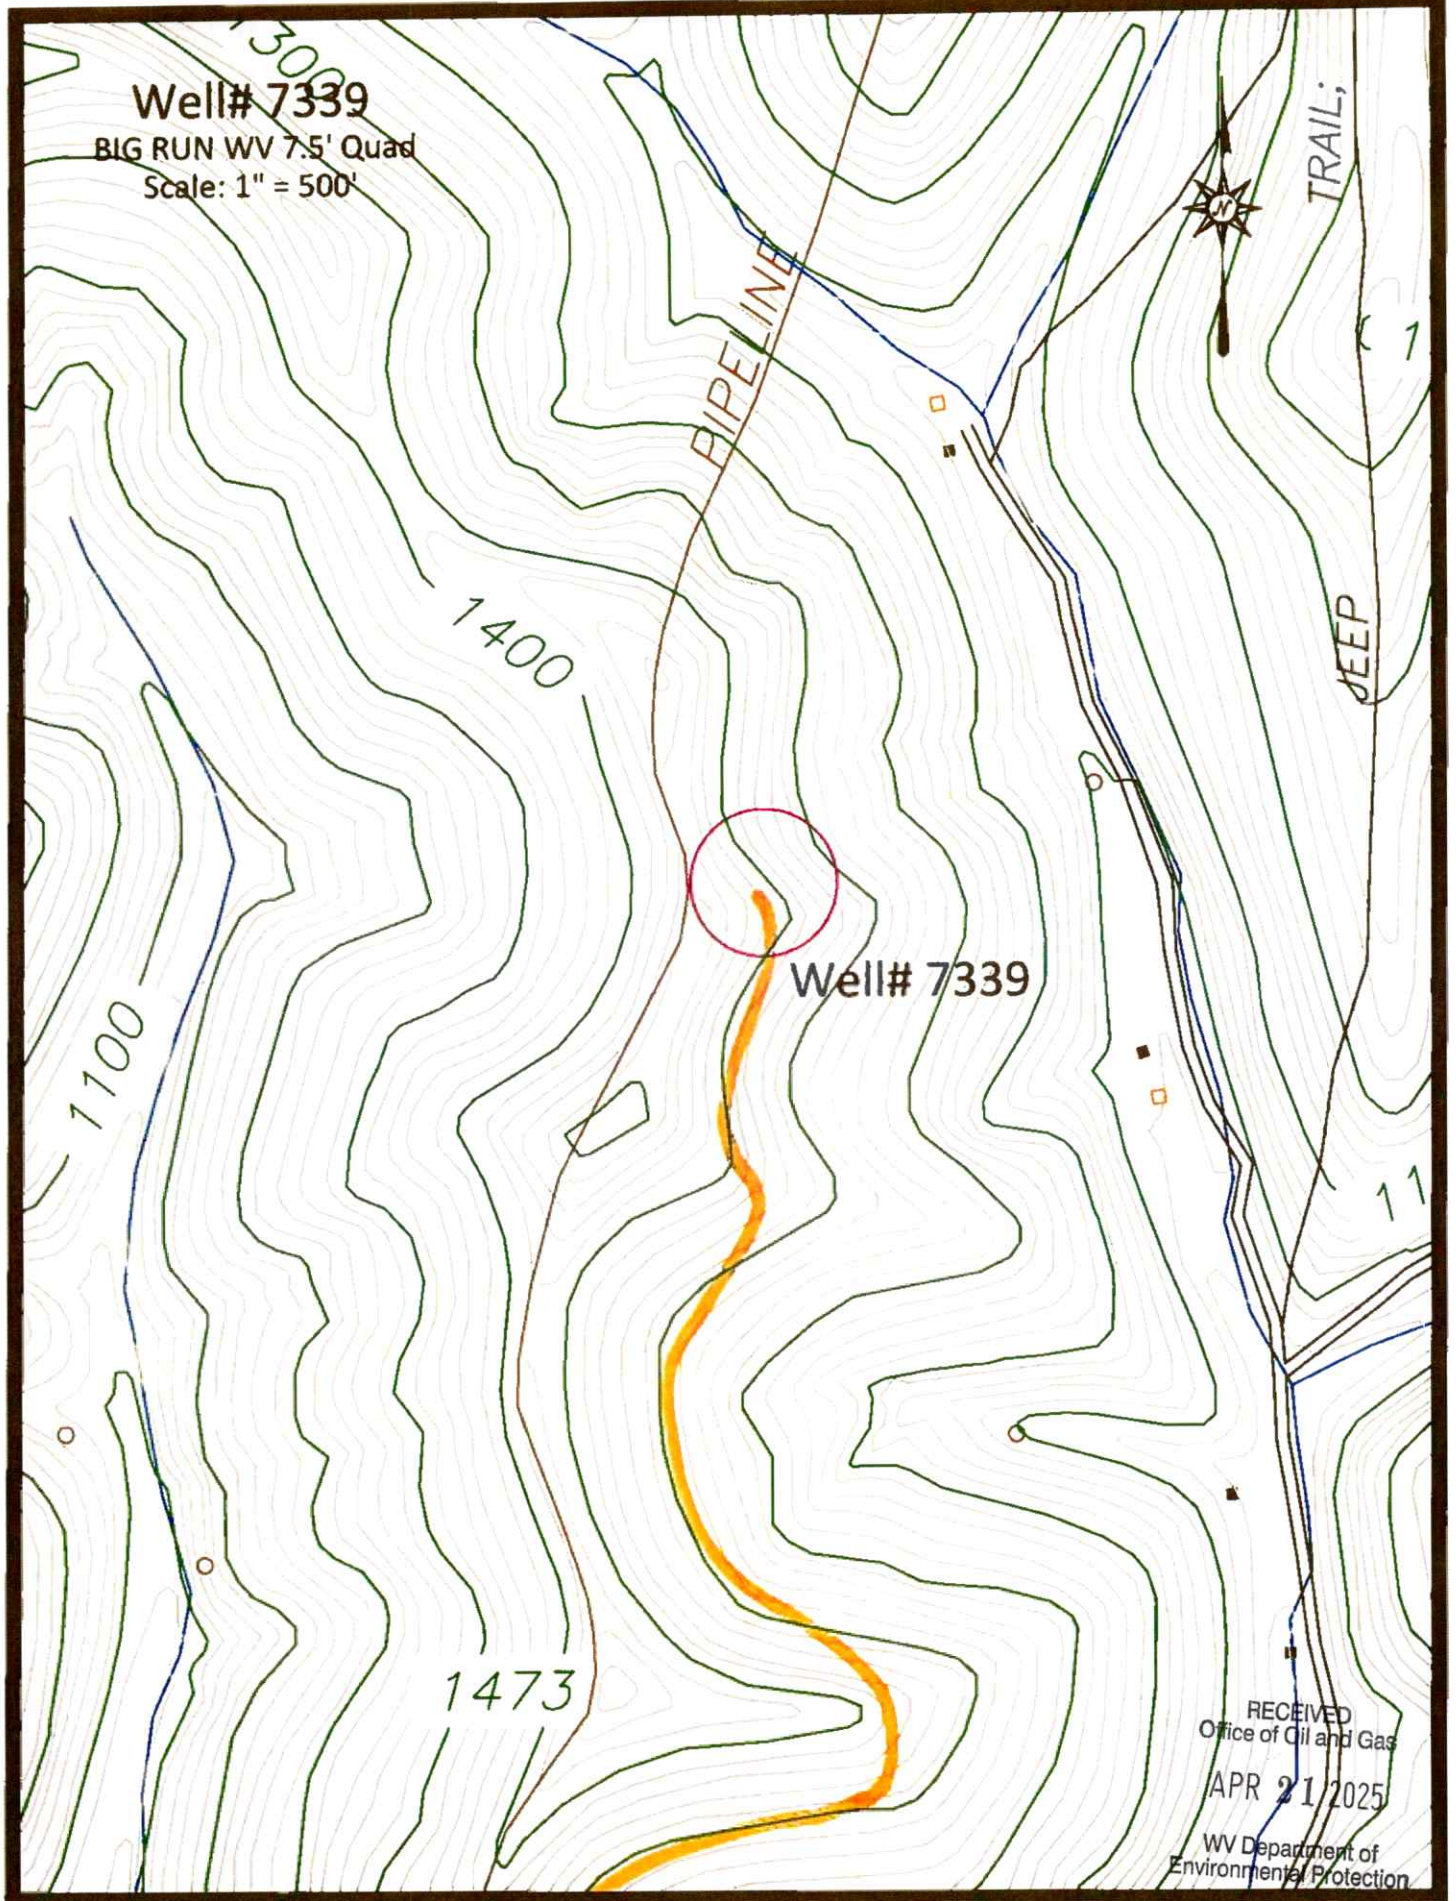

RECEIVED  
Office of Oil and Gas

APR 21 2025

WV Department of  
Environmental Protection

Access Road

05/02/2025



Well # 7339

BIG RUN WM 15' Quad

Scale: 1" = 2000'

Well # 7339


Pricetown

Big Run

RECEIVED  
Office of Oil and Gas  
APR 21 2005  
WV Department of  
Environmental Protection

05/02/2025



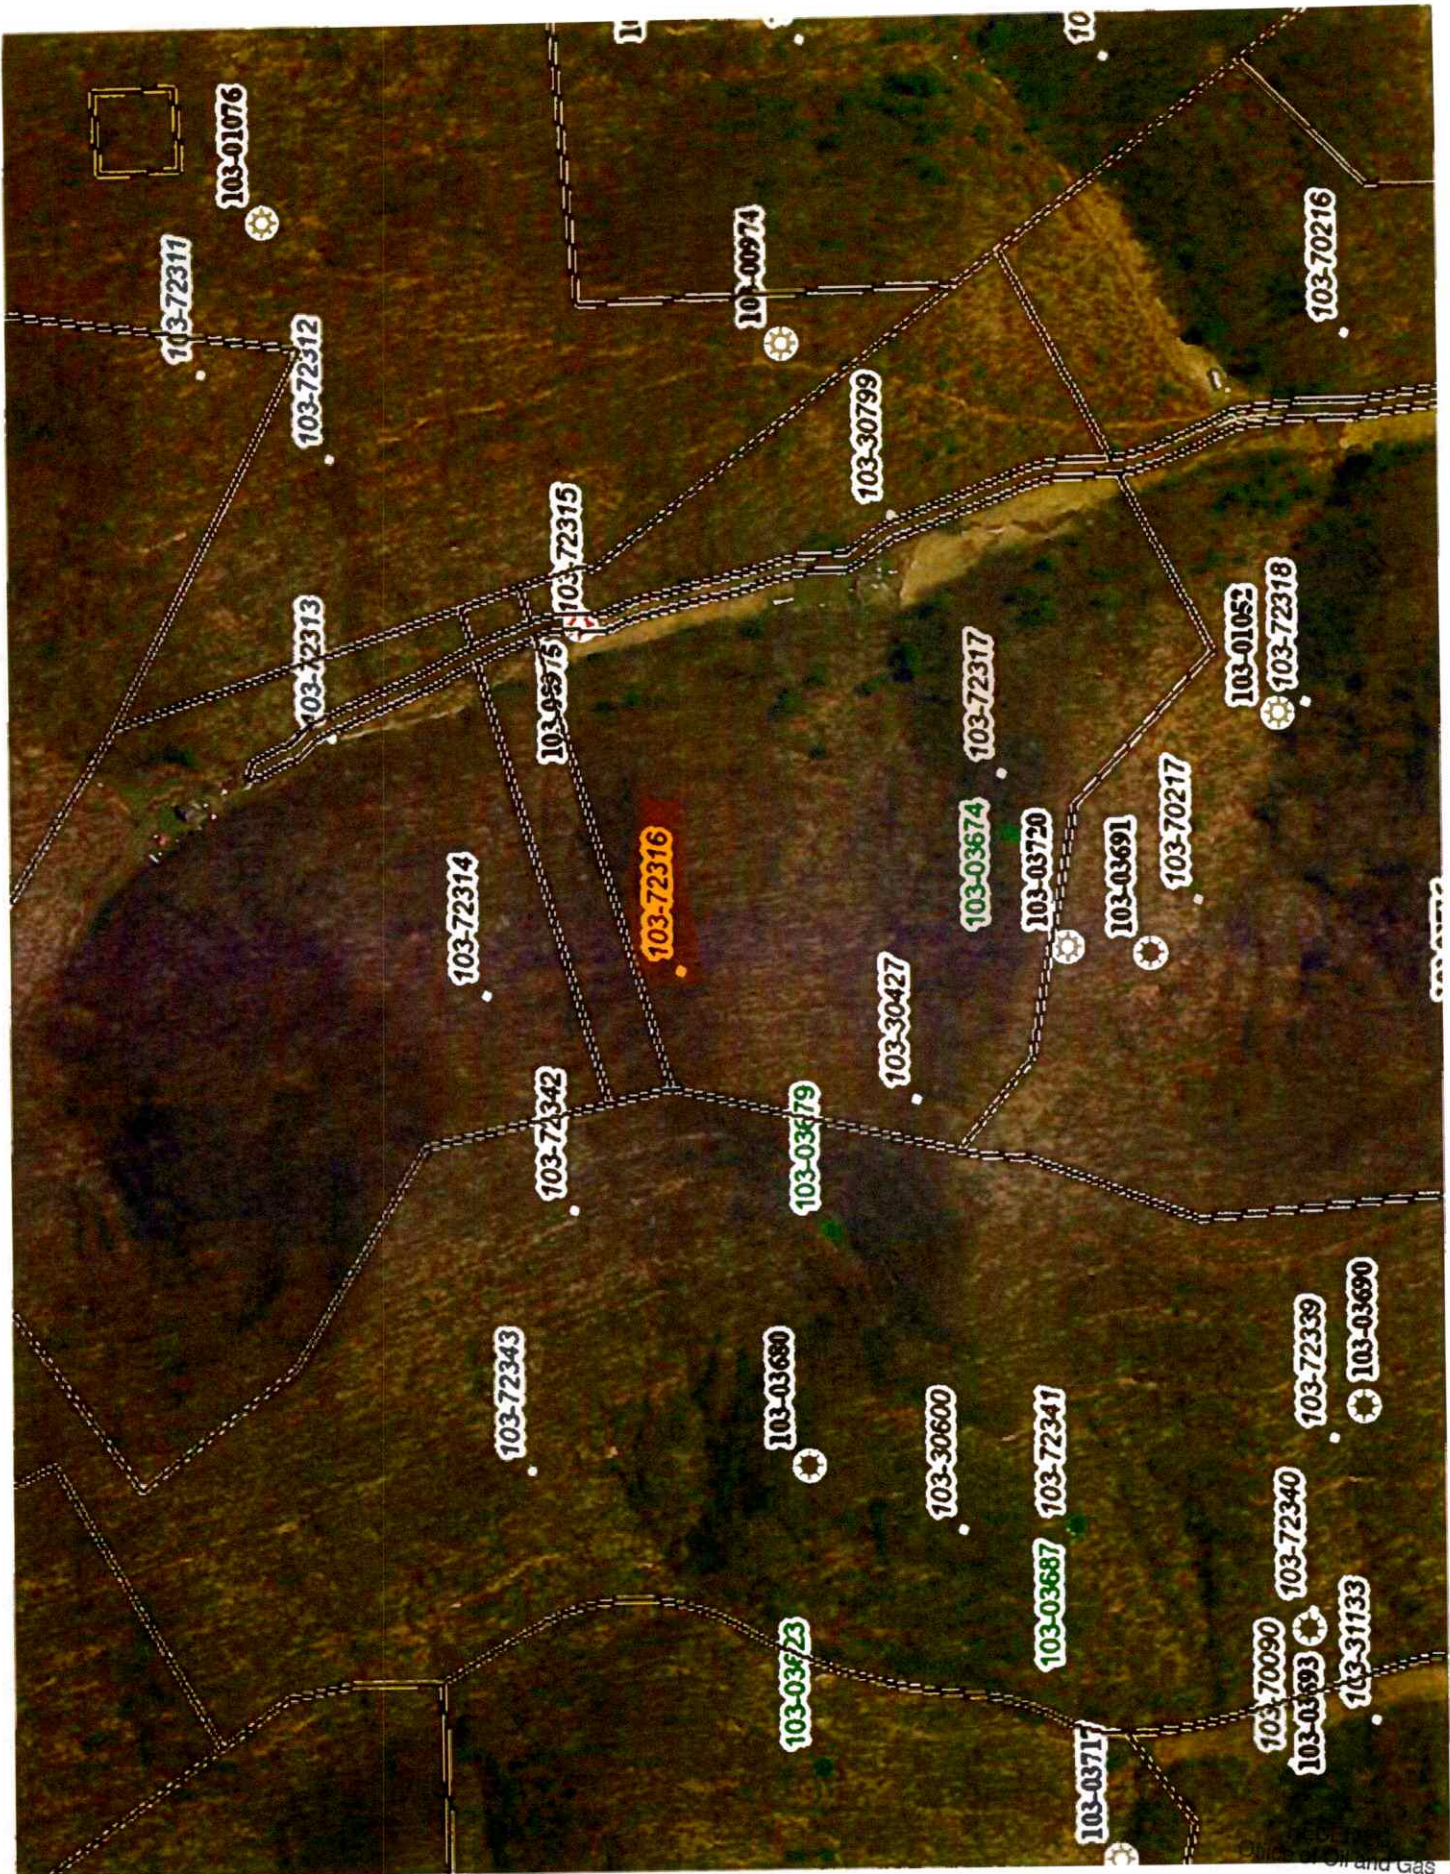

Division of Oil and Gas

APR 21 2025

05/02/2025

WV Department of Environmental Protection



[illegible]

(WALLACE)  
4952 N NW

BIG BLIN W 00A 05/02/2025



05/02/2025