

LATITUDE 39°35'00"

8,298'


LATITUDE 39°37'30" 5,205' TO BOTTOM HOLE

1,910'
2' TO BOTTOM HOLE
LONGITUDE 80°40'00"
LONGITUDE 80°42'30"Antero Resources
Corporation
Well No. Angelo #1H

Green District - Wetzel County
4-4 Brandon Day Revocable Trust
4-5 Rick & Cathy Doty
4-12 Debra Miller
4-13 Rick & Cathy Doty
4-14 Debra Miller
4-15 George & John Mason
4-20 School
4-21 Debra Miller
4-22 David Anderson Et Al
4-30 Debra Miller
4-31 Richard Hornbeck
4-44 Richard Hornbeck
4-45 Dean Fitzsimmons & Jodi Staffle
4-46 Debra Miller
9-1 Antero Resources Corp.
9-2 Richard Hornbeck
9-7 Richard Hornbeck
9-7.1 Francis Springer
9-8 Brady O Springer Revocable Living Trust
9-17 Donzel Hornbeck
9-20 Richard Hornbeck
9-21 Lawrence Mason
9-22 Karen Mason
9-22.2 Lawrence Mason
9-33 Thomas Rogers & Elliot Stearns
9-44 Karen Mason
9-52 WSD Properties LLC
9-53 Dallison Lumber Company Inc.
9-55 Antero Midstream LLC
9-58 Dallison Lumber Company Inc.
9-61 Jason & Tamara Vandyne
9-62 Jason & Tamara Vandyne
14-1 Kenneth & Vicki Vandyne
14-4 Harry & Sharon Burton
14-5 Donald & Myrna Mason
14-5.1 Antero Midstream LLC
14-6 Antero Midstream LLC
14-7 James C. Adams Et Al
14-8 James C. Adams Et Al
14-9 Dallison Lumber Company Inc.
14-10 Sandra Fortney
14-10.1 Sandra Fortney
14-12 Freda Brown
14-16 Antero Midstream LLC
14-17 James C. Adams Et Al
19-25 Ridgeway Capital II, LP
19-26 Donna Greathouse
19-35 James Howard Greathouse II, Et Al
19-36 Delmer & Shirley Greathouse

WELL 1H
BOTTOM HOLE

1H TOP HOLE



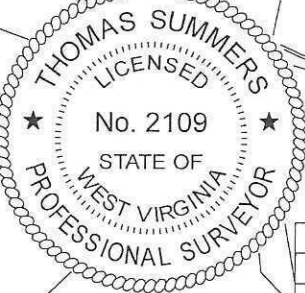


NOTES:
WELL 1H TOP HOLE INFORMATION:
N: 394,908ft E: 1,662,863ft
LAT: 39°34'41.13" LON: 80°41'45.98"
BOTTOM HOLE INFORMATION:
N: 412,108ft E: 1,654,442ft
LAT: 39°37'29.99" LON: 80°43'36.53"
WEST VIRGINIA COORDINATE
SYSTEM OF 1927 NORTH ZONE.
ZONE WAS DERIVED FROM
MEASUREMENTS TAKEN WITH
TRIMBLE GEOXT SUBMETER
MAPPING GRADE GPS UNIT.
PLAT ORIENTATION, CORNER,
AND WELL REFERENCE TIE LINES
ARE BASED ON GRID NORTH.

(NAD) 83 (UTM) ZONE 17 COORDS:
WELL 1H TOP HOLE INFORMATION:
N: 4,380,984m E: 526,115m
BOTTOM HOLE INFORMATION:
N: 4,386,182m E: 523,462m

(NAD) 27 (UTM) ZONE 17 COORDS:
WELL 1H TOP HOLE INFORMATION:
N: 14,372,564ft E: 1,726,046ft
POINT OF ENTRY INFORMATION:
N: 14,371,806ft E: 1,723,620ft
BOTTOM HOLE INFORMATION:
N: 14,389,615ft E: 1,717,342ft

LEASES
A GLENDA M. MASON AND WELLS JUNIOR MASON
B WILLIAM B. FRANCK AND PAMELA S. FRANCK JOINT REV. LIVING TRUST
C JAMES HOWARD GREATHOUSE II AND JESSICA NICOLE GREATHOUSE, JTROS
D LAWRENCE E. SHADE AND CHERYL L. SHADE
E SW2 MINERALS, LLC.
F RICK A. DOTY AND CATHY DOTY
G DEBRA CAROL MILLER
H DEBRA CAROL MILLER
I WETZEL COUNTY BOARD OF EDUCATION
J DEBRA CAROL MILLER
K RICHARD D. HORNBECK AND CLARISSA J. HORNBECK
L THE 5 K'S FUTURE, LLC.
M WESTLAKE ENERGY PARTNERS, LLC.
N VENABLE ROYALTY, LTD., ET AL
O THE DONELY O. SPRINGER REV. LIVING TRUST
P RICHARD D. HORNBECK AND CLARISSA J. HORNBECK
Q TERRY LEE CUMMINGS
R BOUNTY MINERALS, LLC.
S ANTERO MINERALS
T DRILLING APPALACHIAN CORPORATION
U STEPHEN H. STOCKER
V CLAY D.C. DALLISON AND CODY DUANE DALLISON
W SHIBEN ESTATES, INC.
X SHIBEN ESTATES, INC.
Y CHESAPEAKE APPALACHIA, LLC.
Z CLARICE ANN BROWN LEMASTERS
AA ROBERT BARRY MYERS, JR.
AB BOUNTY MINERALS
AC FREEDA MARIE BROWN
AD JAMES E. COEN, ET UX

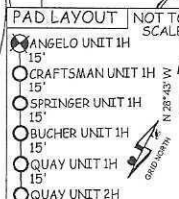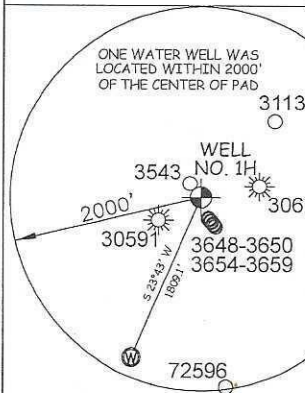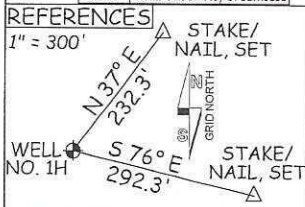

I THE UNDERSIGNED, HEREBY CERTIFY THAT THIS PLAT IS CORRECT
TO THE BEST OF MY KNOWLEDGE AND BELIEF AND SHOWS ALL THE
INFORMATION REQUIRED BY LAW AND THE RULES ISSUED AND
PERSCRIBED BY THE DEPARTMENT OF ENVIRONMENTAL PROTECTION.



STATE OF WEST VIRGINIA, DIVISION
OF ENVIRONMENTAL PROTECTION,
OFFICE OF OIL AND GAS

WILLOW LAND SURVEYING PLLC
220 MASONIC AVE. PENNSBORO
WEST VIRGINIA 26415

JOB # 25-006WA
DRAWING # ANGELO1HR
SCALE 1" = 2000'
MINIMUM DEGREE OF
ACCURACY SUBMETER
PROVEN SOURCE OF ELEV.
SUBMETER MAPPING GRADE GPS

STATE OF WEST VIRGINIA
DEPARTMENT OF ENERGY
DIVISION OF OIL AND GAS

LEGEND

Surface Owner Boundary Lines +/-
Adjoining Surface Tracts +/-
Found monument, as noted

THOMAS SUMMERS P.S. 2109

DATE 6/02/25
OPERATOR'S WELL# ANGELO UNIT #1H47 - 103 - 03734
STATE COUNTY PERMIT

WELL TYPE: OIL ☐ GAS ☒ LIQUID INJECTION ☐ WASTE DISPOSAL ☐
(IF "GAS") PRODUCTION ☒ STORAGE ☐ DEEP ☐ SHALLOW ☒

LOCATION: ELEVATION AS BUILT - 1,160.0' WATERSHED FISHING CREEK

QUADRANGLE PINE GROVE 7.5' DISTRICT GREEN COUNTY WETZEL

SURFACE OWNER DALLISON LUMBER COMPANY INC.

ACREAGE 25 ACRES +/-

OIL & GAS ROYALTY OWNER ROBERT BARRY MYERS, JR.

LEASE ACREAGE 25 ACRES +/-

PROPOSED WORK: DRILL ☐ CONVERT ☐ DRILL DEEPER ☒ REDRILL ☐ FRACTURE OR STIMULATE ☒PLUG OFF OLD FORMATION ☐ PERFORATE NEW FORMATION ☒ OTHER PHYSICAL CHANGE IN WELL

(SPECIFY) MOD-BHL PLUG & ABANDON CLEAN OUT & REPLUG

TARGET FORMATION MARCELLUS ESTIMATED DEPTH 7,600' TVD 29,900' MD

WELL OPERATOR ANTERO RESOURCES CORP. DESIGNATED AGENT CONRAD BASTON

ADDRESS 1615 WYNKOOP ST. ADDRESS 535 WHITE OAK BLVD.

FORM WW-6 DENVER, CO 80202 BRIDGEPORT, WV 26330

08/08/2025

COUNTY NAME PERMIT