
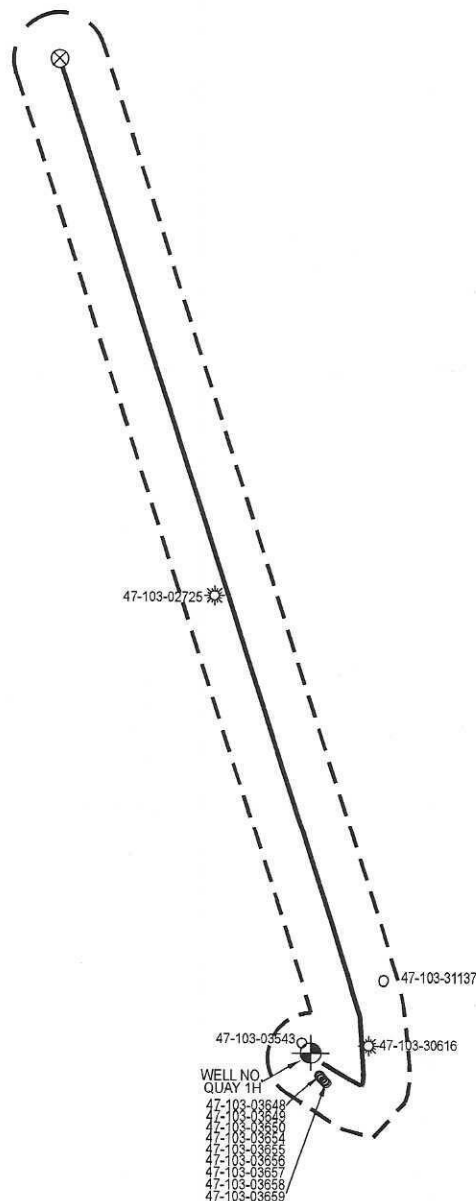


GALMISH PAD ANTERO RESOURCES CORPORATION

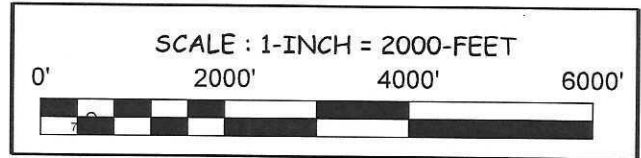

RECEIVED
Office of Oil and Gas
AUG 25 2025
WV Department of
Environmental Protection

JOB #: 25-013WA

FILE: QUAY1HAOR.DWG

WILLOW LAND SURVEYING, PLLC
P.O. BOX 17, PENNSBORO, WV 26415
(304) 659-1717

DATE: 06/12/25

DRAWN BY: T.B.S.

08/29/2025

$-8.268'$

-11,233' TO BOTTOM HOLE

NOTES:
WELL 1H TOP HOLE INFORMATION:
N: 394,856ft E: 1,662,893ft
LAT: 39°34'40.61" LON: 80°41'45.60"
BOTTOM HOLE INFORMATION:
N: 405,662ft E: 1,660,068ft
LAT: 39°36'27.04" LON: 80°42'23.53"
WEST VIRGINIA COORDINATE
SYSTEM OF 1927 NORTH ZONE.
ZONE WAS DERIVED FROM
MEASUREMENTS TAKEN WITH
TRIMBLE GEOXT SUBMETER
MAPPING GRADE GPS UNIT.
PLAT ORIENTATION, CORNER,
AND WELL REFERENCE TIE LINES
ARE BASED ON GRID NORTH.

(NAD) 83 (UTM) ZONE 17 COORDS:
WELL 1H TOP HOLE INFORMATION:
N: 4,380,968m E: 526,124m
BOTTOM HOLE INFORMATION:
N: 4,384,246m E: 525,209m

(NAD) 27 (UTM) ZONE 17 COORDS:
WELL 1H TOP HOLE INFORMATION:
N: 14,372,511ft E: 1,726,076ft
POINT OF ENTRY INFORMATION:
N: 14,372,748ft E: 1,726,584ft
BOTTOM HOLE INFORMATION:
N: 14,383,265ft E: 1,723,073ft

WV NORTH ZONE
GRID NORTH

	LESSOR	
A	NELDA JEAN KOCHER GLOVER	
B	WILLIAM W. FLETCHER, SR.	
C	WILLIAM W. FLETCHER, SR.	
D	WILLIAM W. FLETCHER, SR.	
E	JOHN PHILLIP SPRINGER AND EVA J. SPRINGER	
F	FRANCIS DAVID SPRINGER	
G	DEAN H. BUCHER	
J	JEFFREY L. MASON	
K	JUNIOR L. ROBINSON	
L	JUNIOR L. ROBINSON	
M	SHIBEN ESTATES, INC.	
N	EDDIE D. DALLISON	
O	SHARON S. FRANCIS	
P	RONALD L. HALL AND R. KEVIN HALL	
Q	BOUNTY MINERALS, LLC.	
R	BOUNTY MINERALS, LLC.	
S	BRC APPALACHIAN MINERALS I, LLC.	
T	ROBERT BARRY MYERS, JR.	
U	ROBERT BARRY MYERS, JR.	
V	FREEDA MARIE BROWN	
W	AUNIX ENERGY, LLC	

Green District - Wetzel County	
4-24	George Mason, Et Al
4-36	George Mason, Et Al
4-37	Harrison Cemetery
4-38	William Fletcher
4-49	William Fletcher
4-56	William Fletcher
4-47	William Fletcher
9-9	James Welch, Et Al
9-10	Howard & Clara Bucher
9-21	Wilma Morris
9-23	Karen Landon
9-24	Wilma Adams
9-35	Trixie Robinson
9-36	Trixie Robinson
9-46	John Hought
9-47	Dallison Lumber Company Inc
9-48	Dallison Lumber Company Inc
9-49	Ronald & Kevin Hall
9-58	Dallison Lumber Company Inc
14-4	Harry & Sharon Burton
14-8	James C. Adams Et Al
14-9	Dallison Lumber Company Inc
14-10	Edna Fortney
14-10.1	Sandra Fortney
14-12	Brenda Brown

REFERENCES

1" = 300'

N 25° E 262.8'

STAKE/ NAIL, SET

GRID NORTH

S 86° E 255.3'

STAKE/ NAIL, SET

WELL NO. 14

A circular professional seal for Thomas Summers, a Licensed Professional Surveyor in the State of West Virginia. The seal features a double-lined circular border. Inside the border, the text "THOMAS SUMMERS" is at the top, "LICENSED" is below it, "No. 2109" is in the center, "STATE OF" is below the number, "WEST VIRGINIA" is at the bottom, and "PROFESSIONAL SURVEYOR" is at the very bottom. Two five-pointed stars are positioned on either side of the central "No. 2109".

PAD LAYOUT NOT TO SCALE

ANGELO UNIT 1H
15'

CRAFTSMAN UNIT 1H
15'

SPRINGER UNIT 1H
15'

BUCHER UNIT 1H
15'

QUAY UNIT 1H
15'

QUAY UNIT 2H
15'

N 28° 43' W

GRID NORTH

I THE UNDERSIGNED, HEREBY CERTIFY THAT THIS PLAT IS CORRECT TO THE BEST OF MY KNOWLEDGE AND BELIEF AND SHOWS ALL THE INFORMATION REQUIRED BY LAW AND THE RULES ISSUED AND PERSCRIPTION BY THE DEPARTMENT OF ENVIRONMENTAL PROTECTION.



STATE OF WEST VIRGINIA, DIVISION
OF ENVIRONMENTAL PROTECTION,
OFFICE OF OIL AND GAS

WILLOW LAND SURVEYING PLLC
220 MASONIC AVE. PENNSBORO
WEST VIRGINIA 26415

JOB # 25-013WA
DRAWING # QUAY1H
SCALE 1" = 2000'
MINIMUM DEGREE OF
ACCURACY SUBMETER
PROVEN SOURCE OF ELEV.
SUBMETER MAPPING GRADE GPS

LEGEND

 Surface Owner Boundary Lines +/-
 Adjoining Surface Tracts +/-
  Found monument, as noted

DATE 6/12/25

OPERATOR'S WELL# QUAY UNIT #1H

47 - 103 - 03737
STATE COUNTY PERMIT

WELL TYPE: OIL _____ GAS X LIQUID INJECTION _____ WASTE DISPOSAL _____
(IF "GAS") PRODUCTION X STORAGE _____ DEEP _____ SHALLOW X

LOCATION: ELEVATION AS BUILT - 1,160.0'

WATERSHED FISHING CREEK

08/29/2025

SURFACE OWNER DALLISON LUMBER COMPANY INC.

ACRFAGE 25 ACRES +/-

OIL & GAS ROYALTY OWNER ROBERT BARRY MYERS, JR.

LEASE ACREAGE 25 ACRES±

PROPOSED WORK: DRILL ☐ CONVERT ☐ DRILL DEEPER ☒ REDRILL ☐ FRACTURE OR STIMULATE ☒

PLUG OFF OLD FORMATION ☐ PERFORATE NEW FORMATION ☒ OTHER PHYSICAL CHANGE IN WELL _____

(SPECIFY) MOD-BHL PLUG & ABANDON CLEAN OUT & REPLUG

TARGET FORMATION	MARCELLUS	ESTIMATED DEPTH	7,600' IVD 20,400'
		DESIGNATED AGENT	CONRAD BASTON

WELL OPERATOR ANTERO RESOURCES CORP. DESIGNATED AGENT CONRAD BASTON
ADDRESS 525 WHITE OAK BL

ADDRESS 1615 WYNKOOP ST. ADDRESS 535 WHITE OAK BLVD.
BRIDGEPORT WA 98622

FORM WW-6

DENVER, CO 80202

BRIDGEPORT, WV 26330

LONGITUDE 80°40'00"

LONGITUDE 80°40'00"

COUNTRY NAME

PERMII