

47 1 03 03 7 4 6



32'30"

4376

4375

4374

RECEIVED
Office of Oil and Gas

JUL 21 2025

WV Department of
Environmental Protection

39°30'

(WALLACE)
4882 N. NW

39 32'30" 40 41 42000mE 80°30'

1 MILE
2 FEET
1:62,500

ROAD CLASSIFICATION


Heavy-duty ——— Light duty ———
Medium-duty ——— Un-improved dirt ———
State Route



BIG RUN, W. VA. 08/01/2025

"Big Run" WV Scale: 1" = 0.370Mi 610M 2 000Ft 1 Mi = 2 640' 1 cm = 240M

SE/4 LITTLETON 15' QUADRANGLE

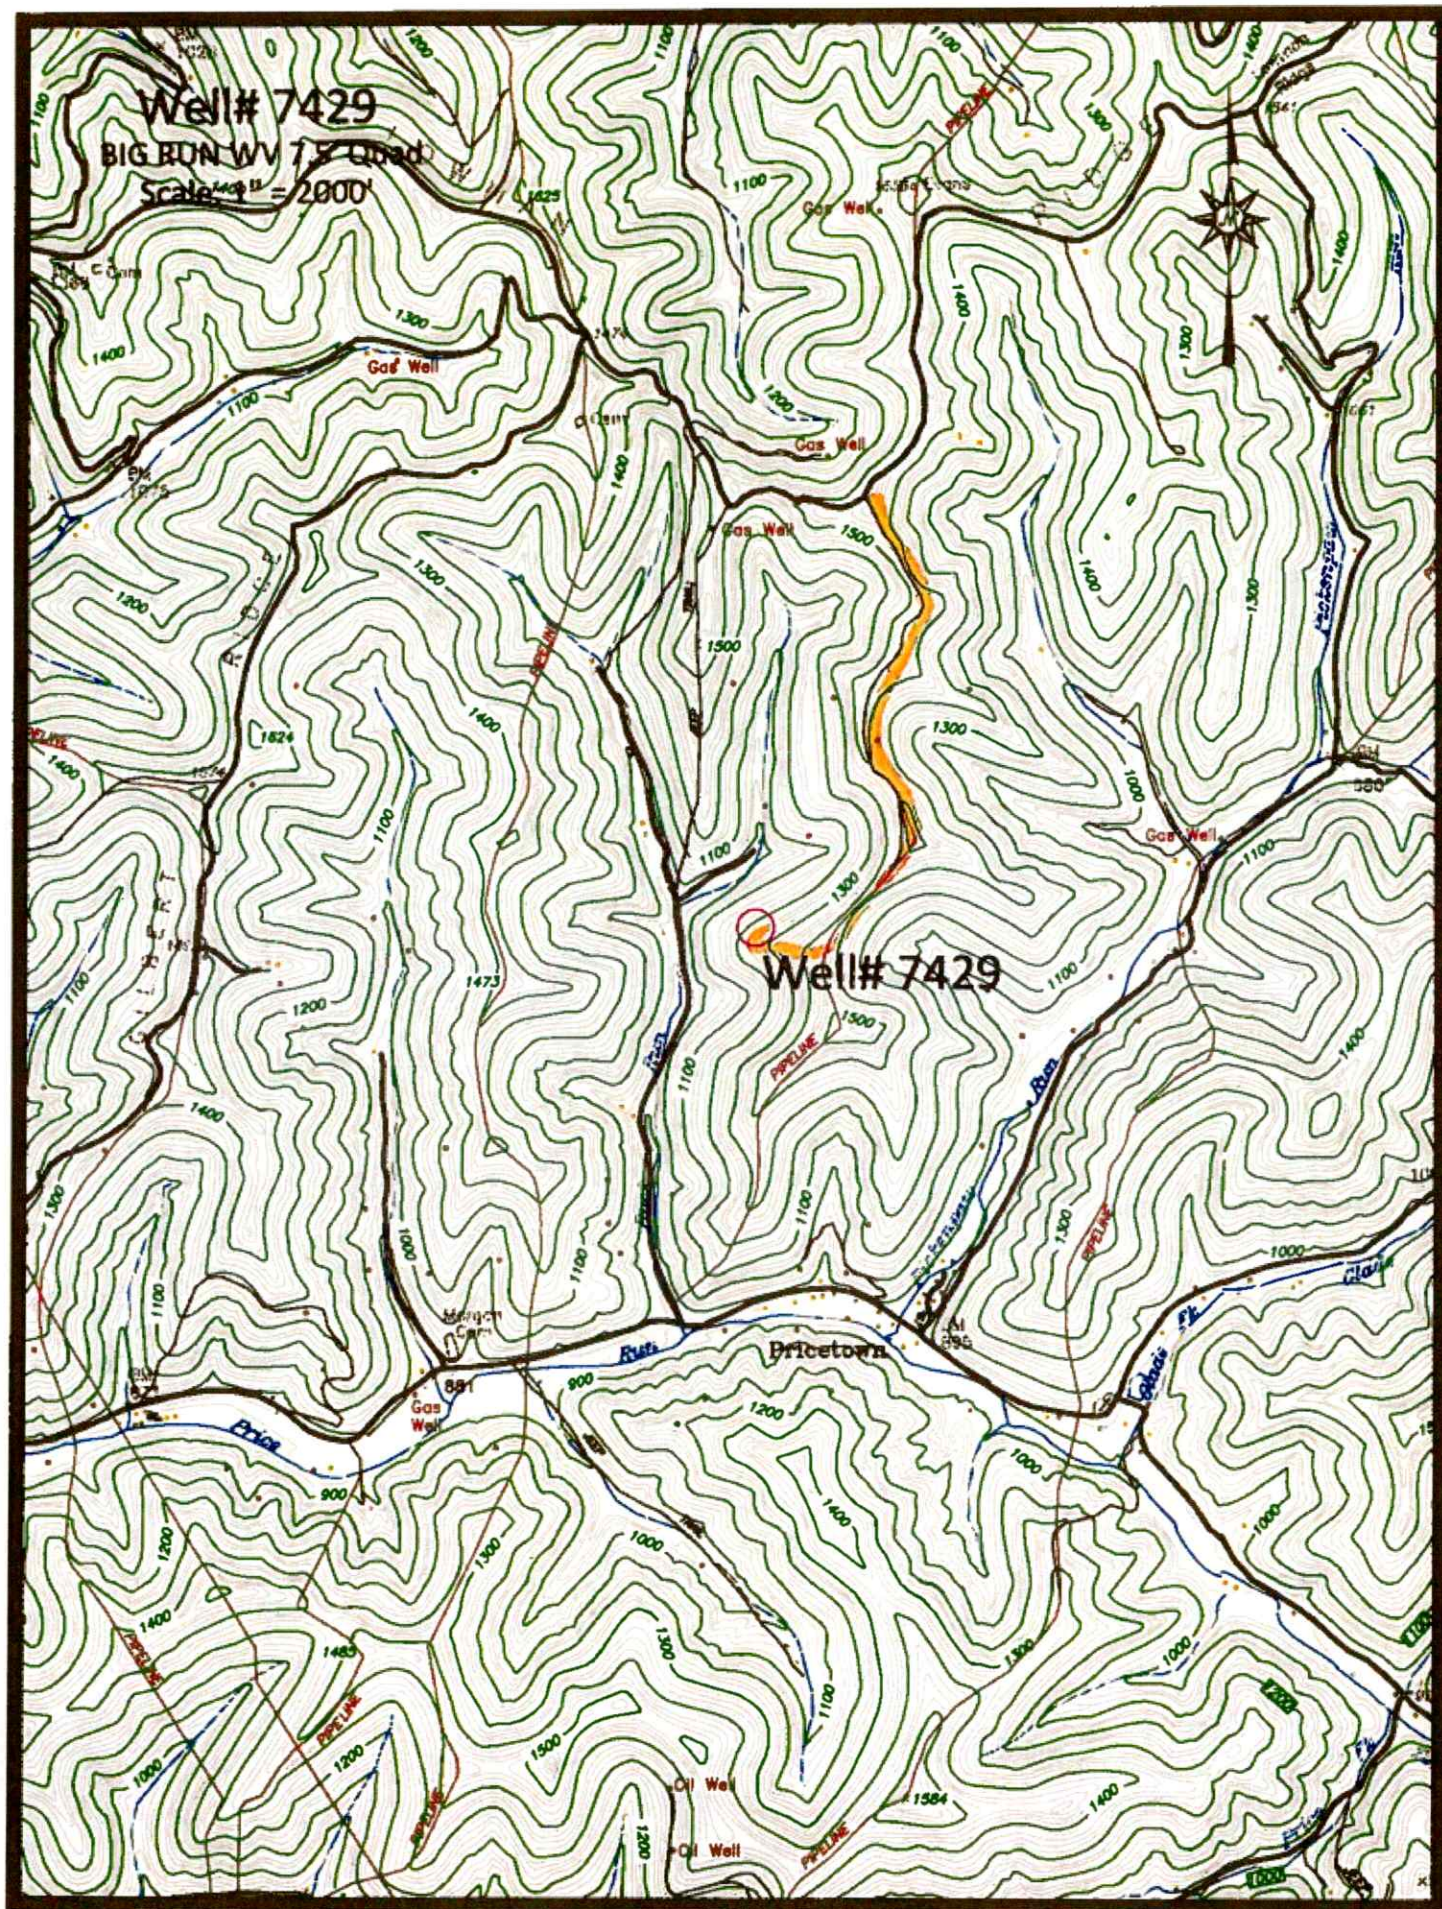


Access Road

08/01/2025

47 1 0 3 0 3 7 4 6

Well# 7429
BIG RUN WV 7.5' Quad
Scale: 1" = 500'

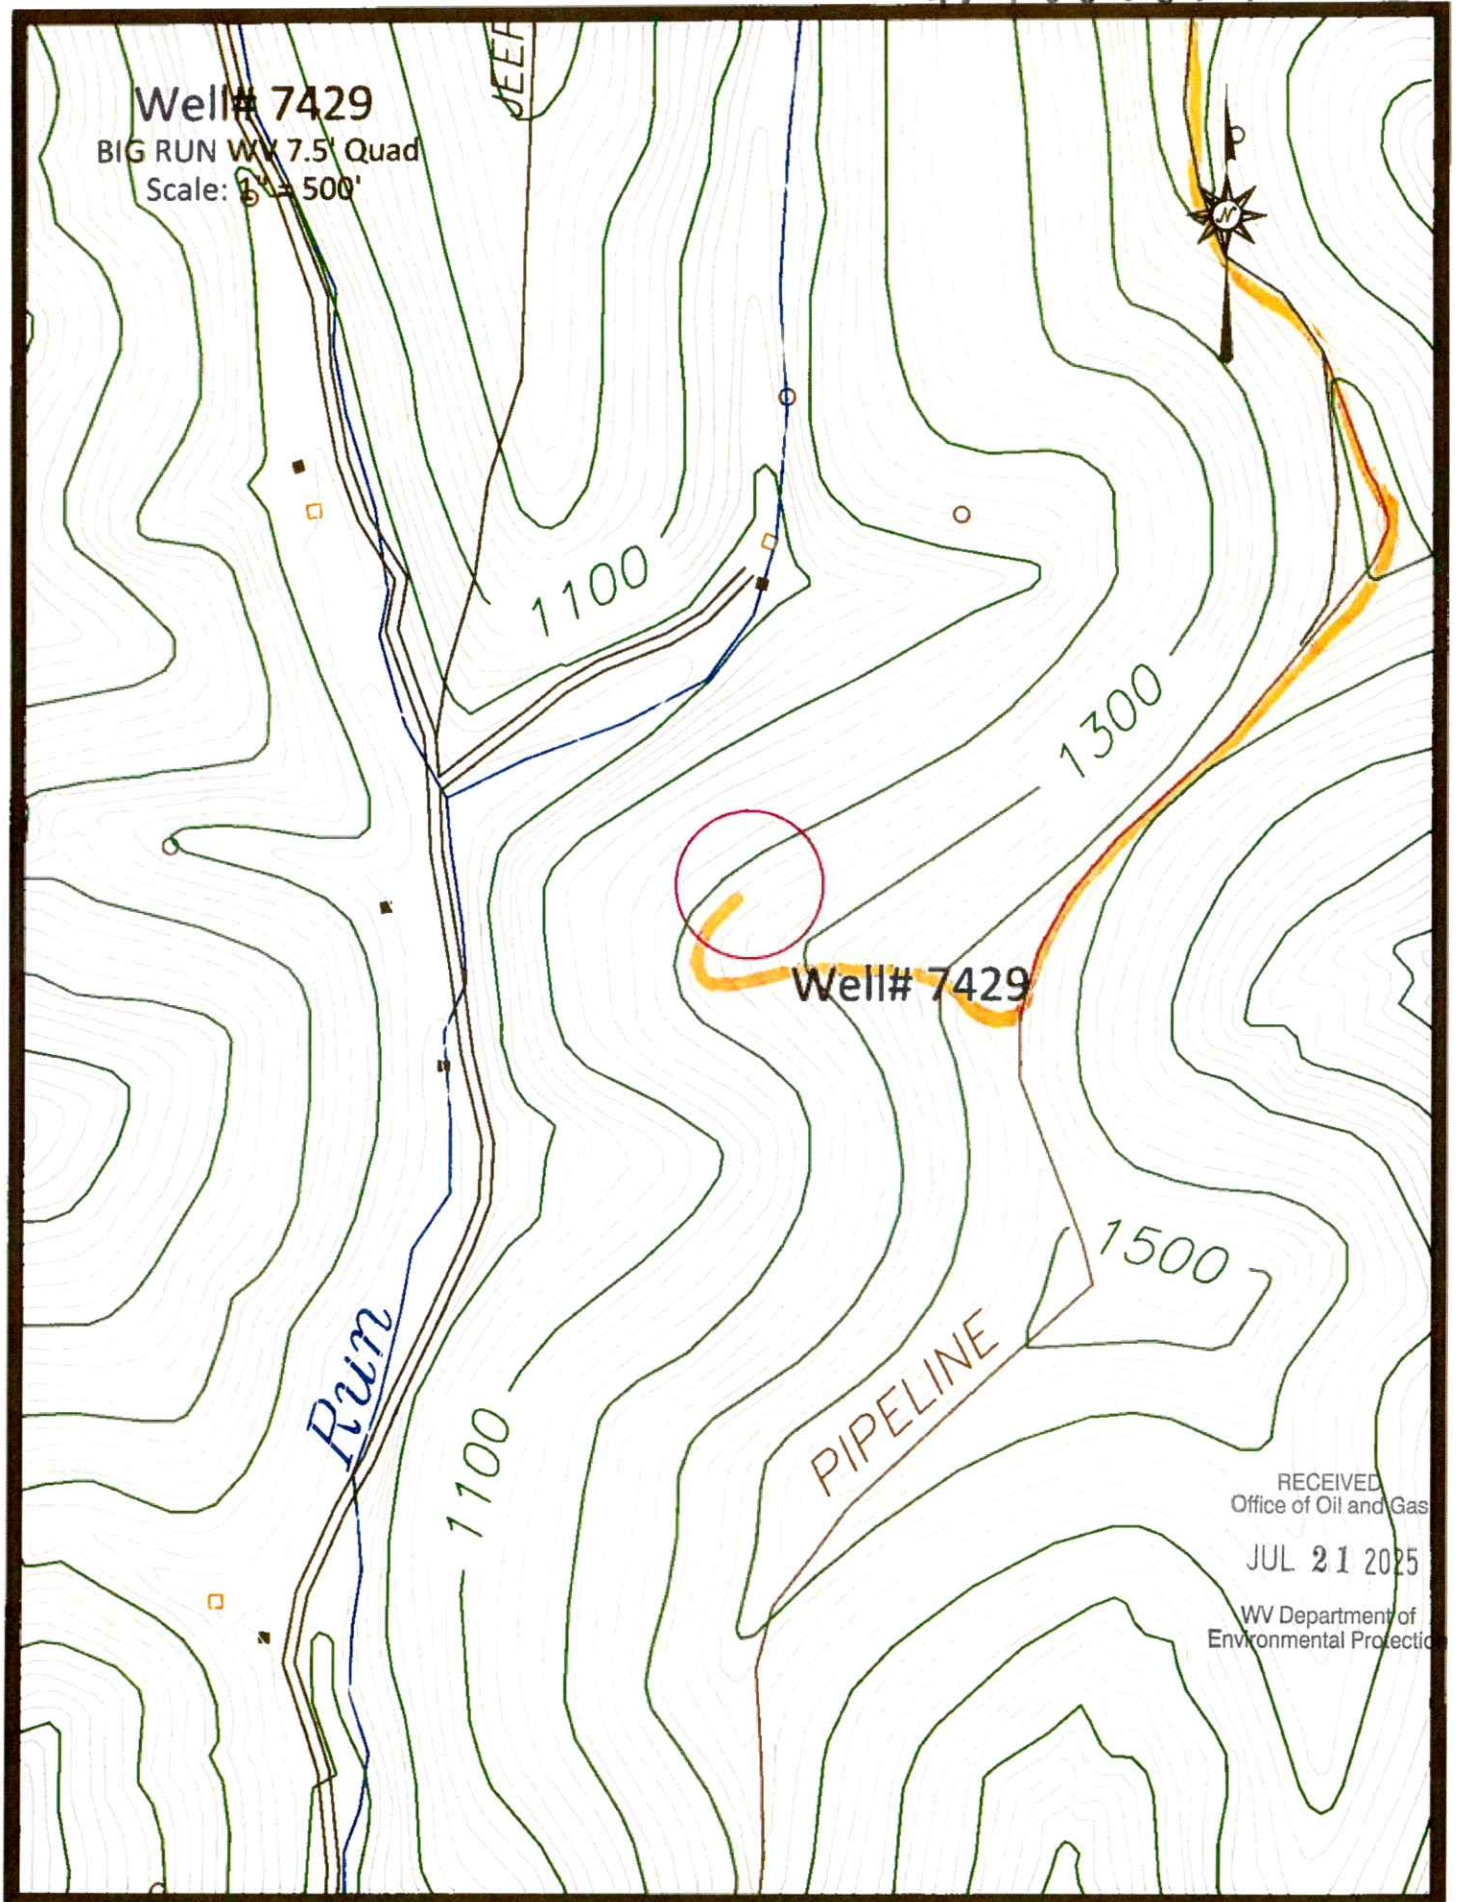


RECEIVED
Office of Oil and Gas

JUL 21 2025

WV Department of
Environmental Protection

— Access Road

08/01/2025

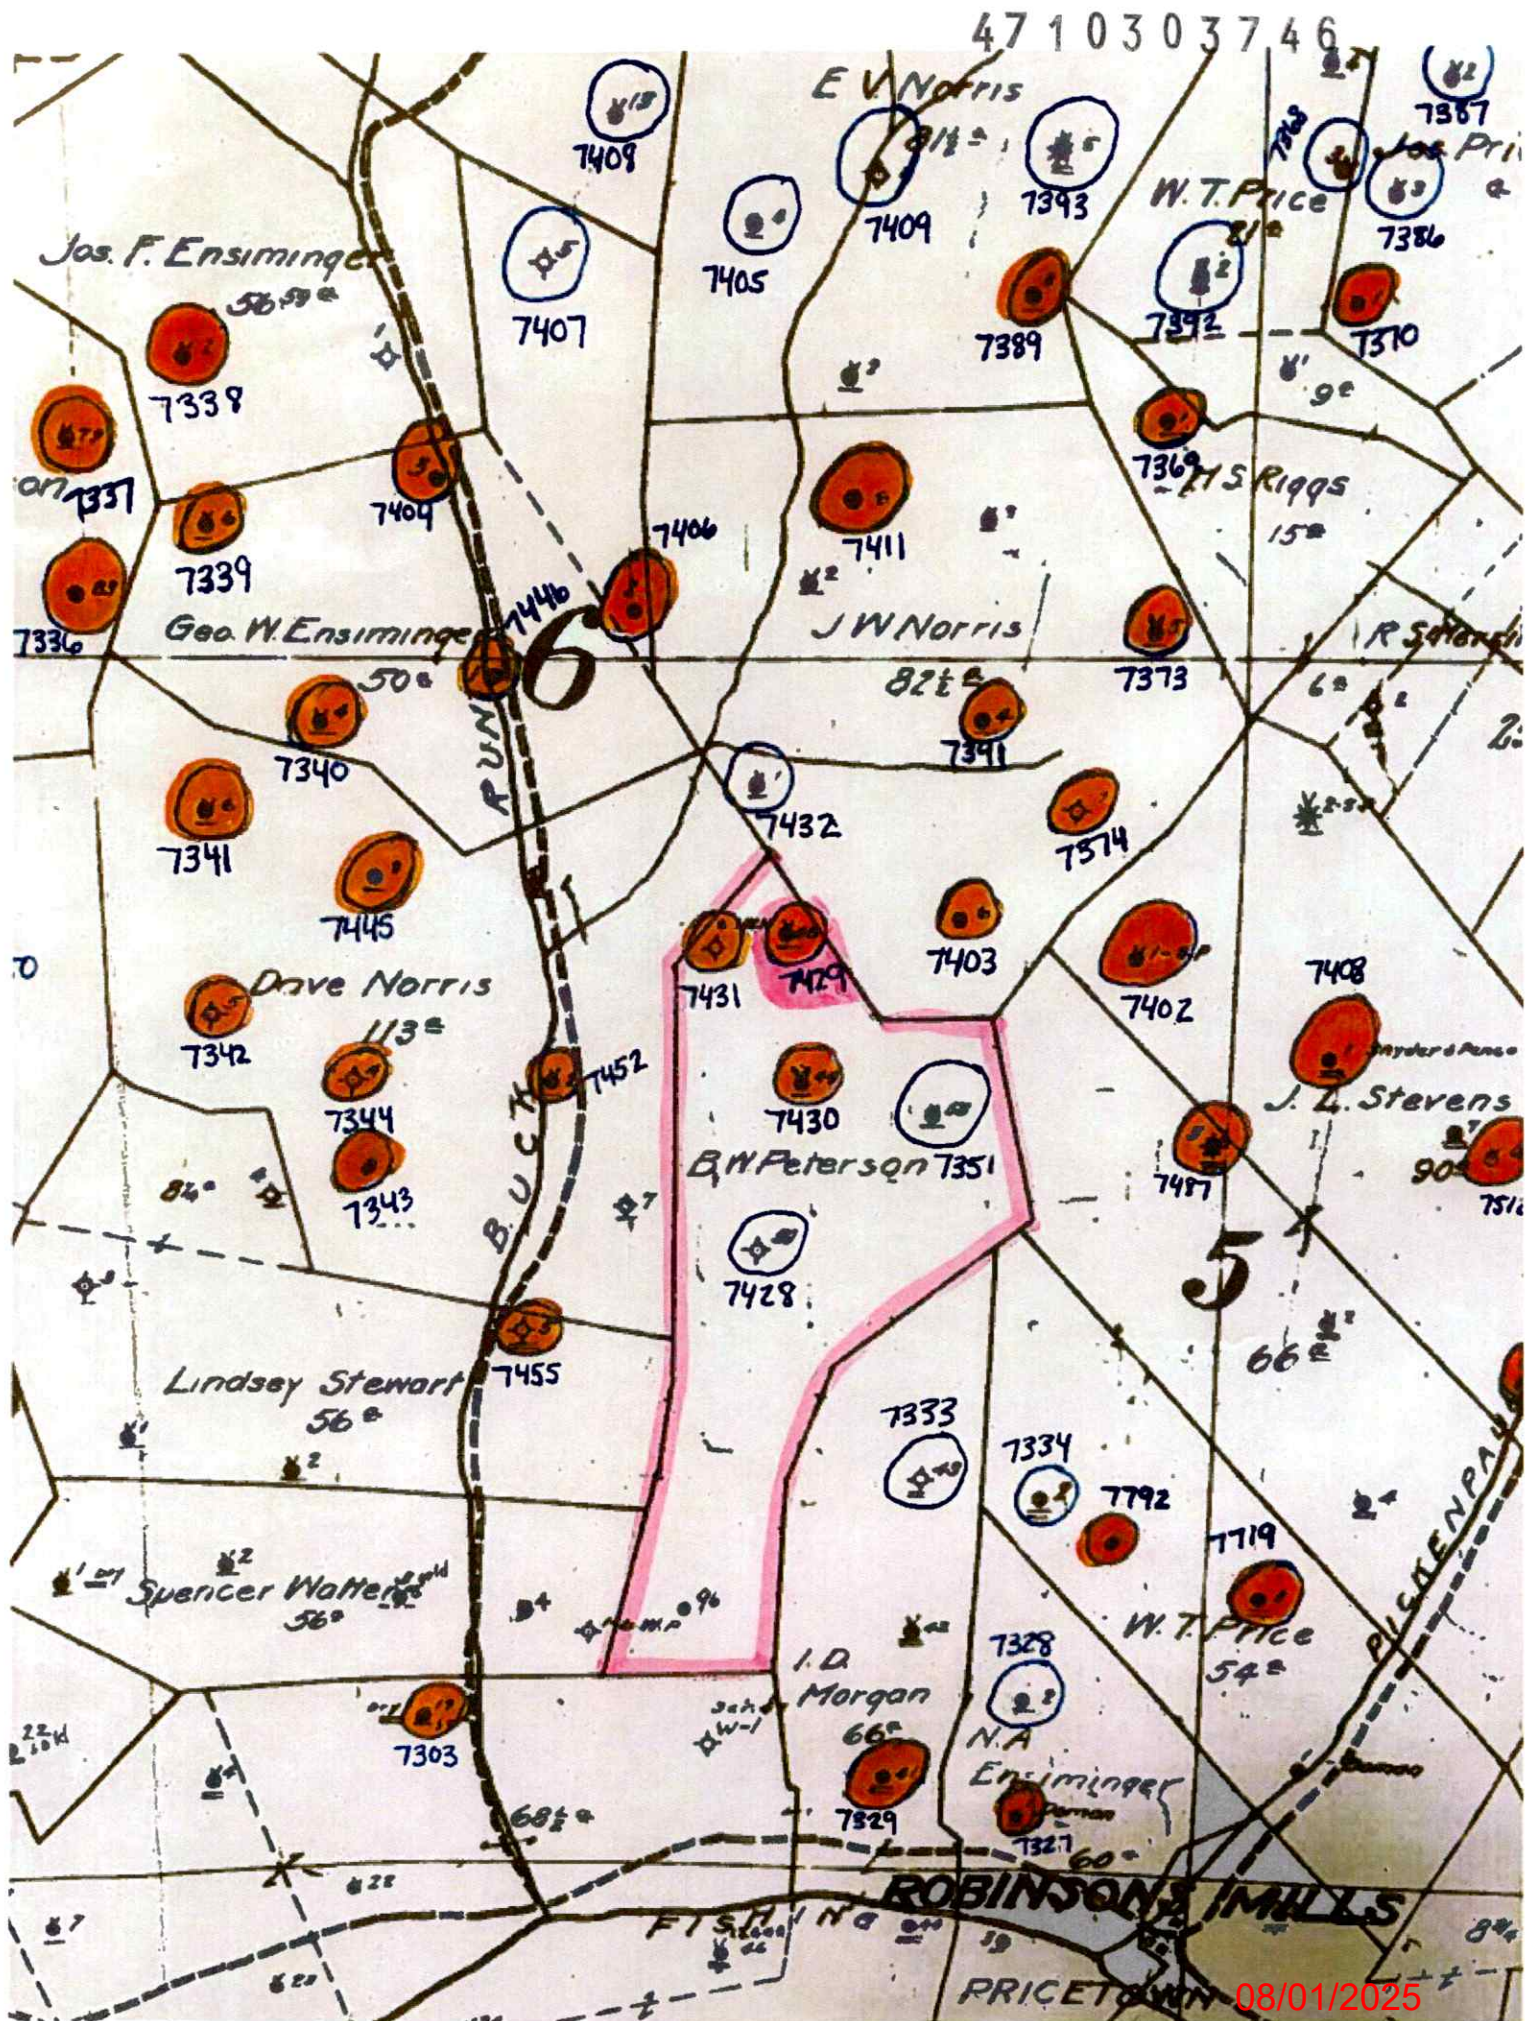

4 / 1 0 3 0 3 7 4 6



WYOMING DEPARTMENT OF LAND & NATURAL RESOURCES

Find address or place



RECEIVED
Department of Oil and Gas

JUL 21 2025

WYOMING DEPARTMENT OF
Environmental Protection

08/01/2025

4710303746

WW-7
8-30-06

West Virginia Department of Environmental Protection
Office of Oil and Gas

WELL LOCATION FORM: GPS

API: 47-103-72323 WELL NO.: 7429
 FARM NAME: B.W. PETERSON
 RESPONSIBLE PARTY NAME: WEST VIRGINIA LAND RESOURCES INC.
 COUNTY: WETZEL DISTRICT: GRANT
 QUADRANGLE: BIG RUN W.VA
 SURFACE OWNER: JOHN DALE COEN
 ROYALTY OWNER: _____
 UTM GPS NORTHING: 4,374,576 m
 UTM GPS EASTING: 541,440 m GPS ELEVATION: 377 m

The Responsible Party named above has chosen to submit GPS coordinates in lieu of preparing a new well location plat for a plugging permit or assigned API number on the above well. The Office of Oil and Gas will not accept GPS coordinates that do not meet the following requirements:

1. Datum: NAD 1983, Zone: 17 North, Coordinate Units: meters, Altitude: height above mean sea level (MSL) – meters.
2. Accuracy to Datum – 3.05 meters
3. Data Collection Method:

Survey grade GPS ☒ : Post Processed Differential _____
 Real-Time Differential ☒

Mapping Grade GPS _____ : Post Processed Differential _____
 Real-Time Differential _____

4. **Letter size copy of the topography map showing the well location.**

I the undersigned, hereby certify this data is correct to the best of my knowledge and belief and shows all the information required by law and the regulations issued and prescribed by the Office of Oil and Gas.

Signature

Title

JULY 11, 2025

Date

RECEIVED
Office of Oil and Gas

JUL 21 2025

WV Department of
Environmental Protection

08/01/2025