


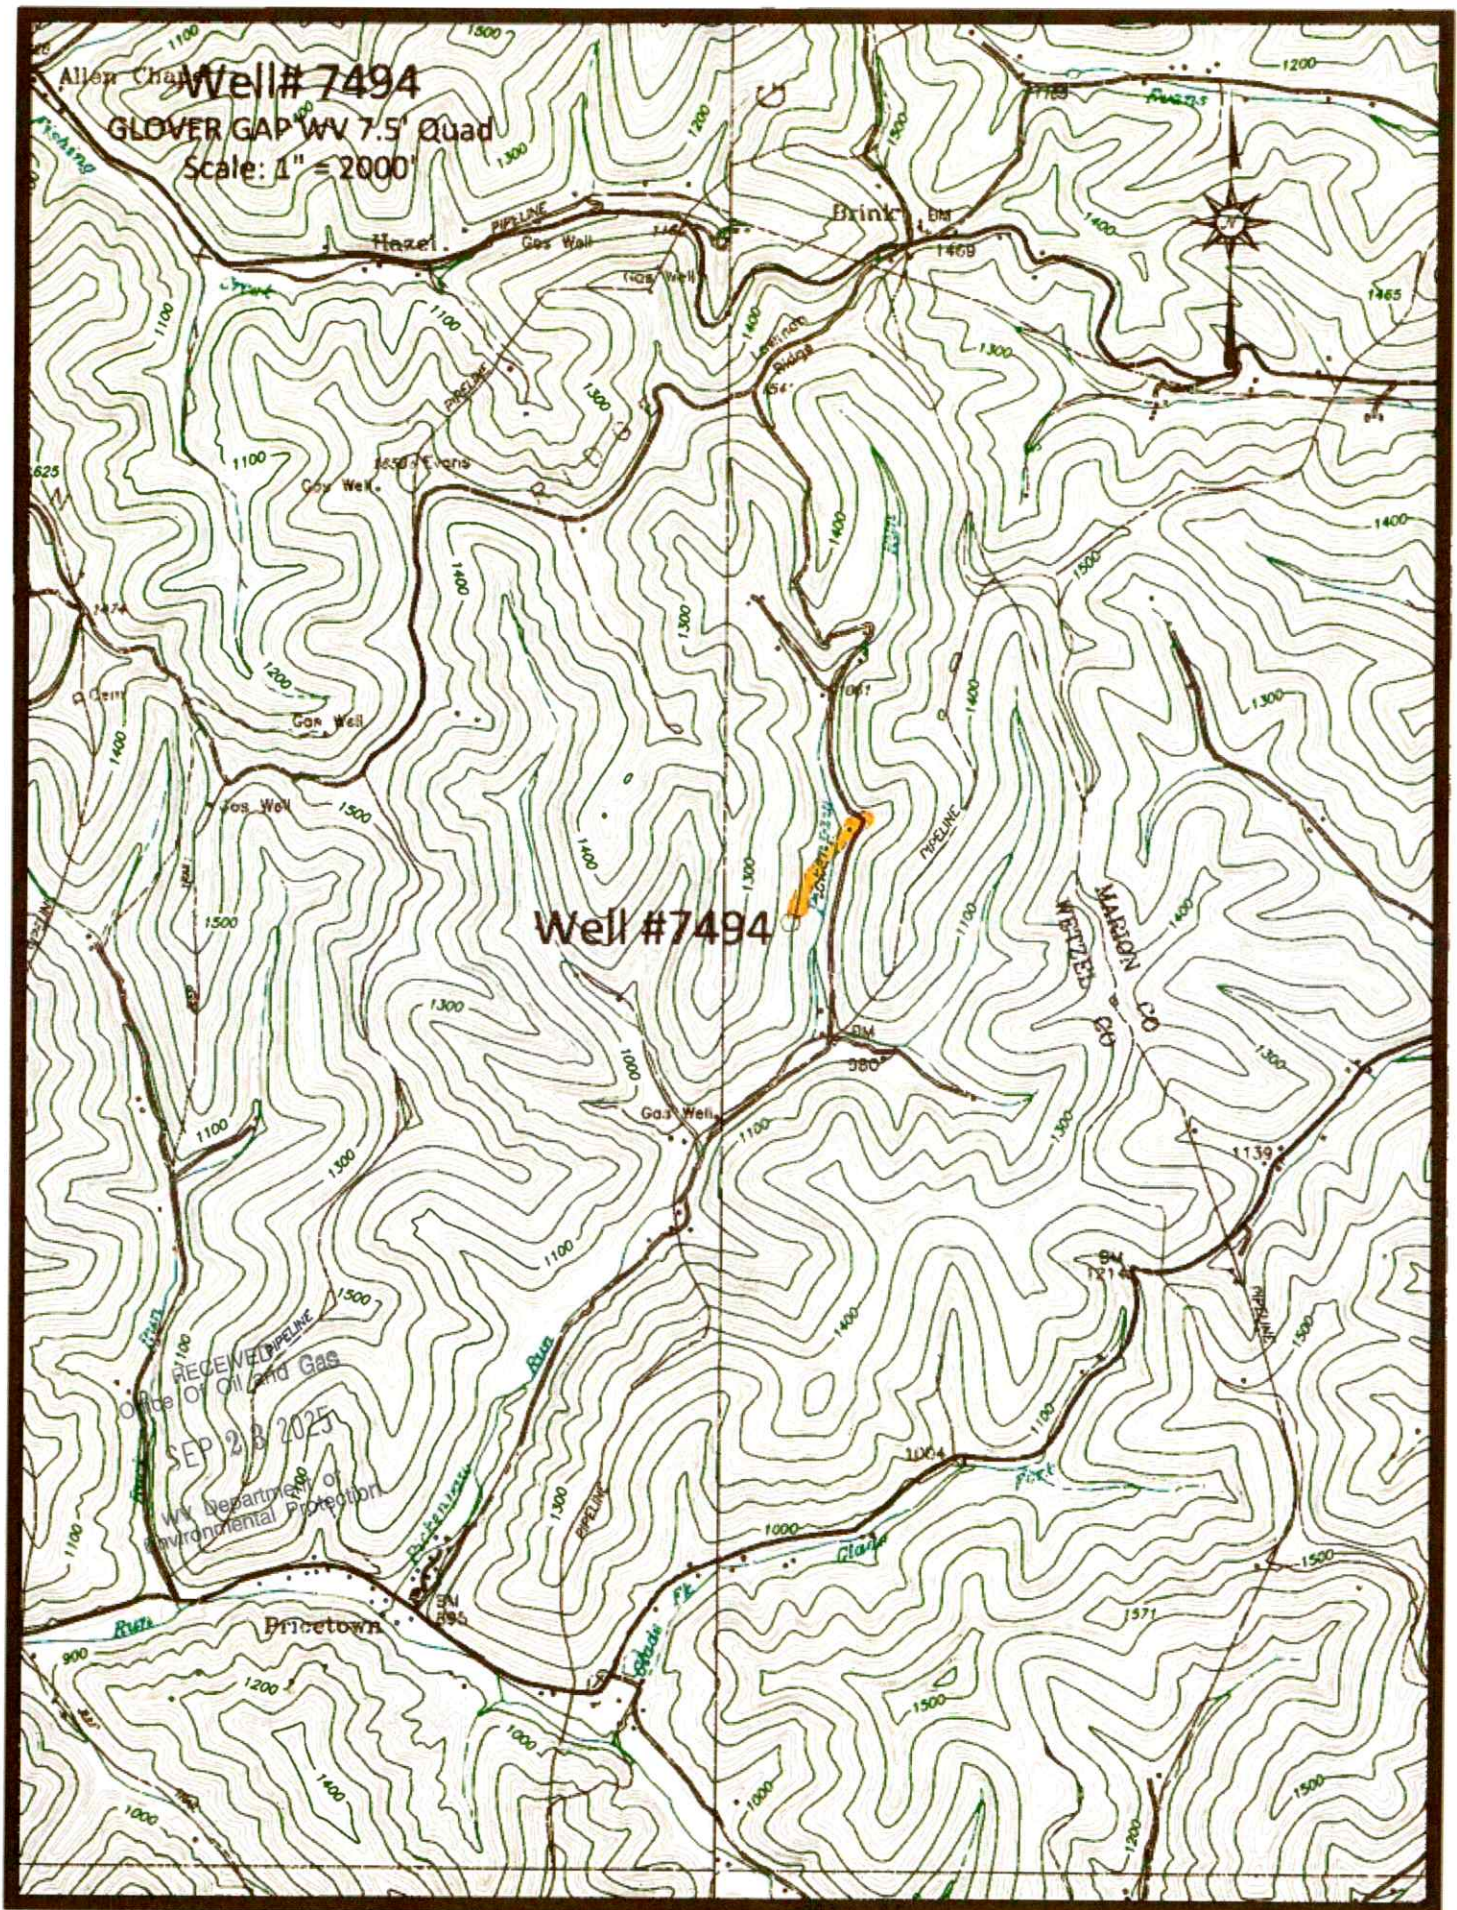

Access Road

10/03/2025

47 10303767

Well# 7494
GLOVER GAP WV 7.5' Quad
Scale: 1" = 500'



Well# 7494

PIPELINE

RECEIVED
Office Of Oil and Gas
SEP 23 2025
WV Department of
Environmental Protection

Gas Well.

BM

980

1300

1000


1100

1100

 Access Road

10/03/2025

4710303707

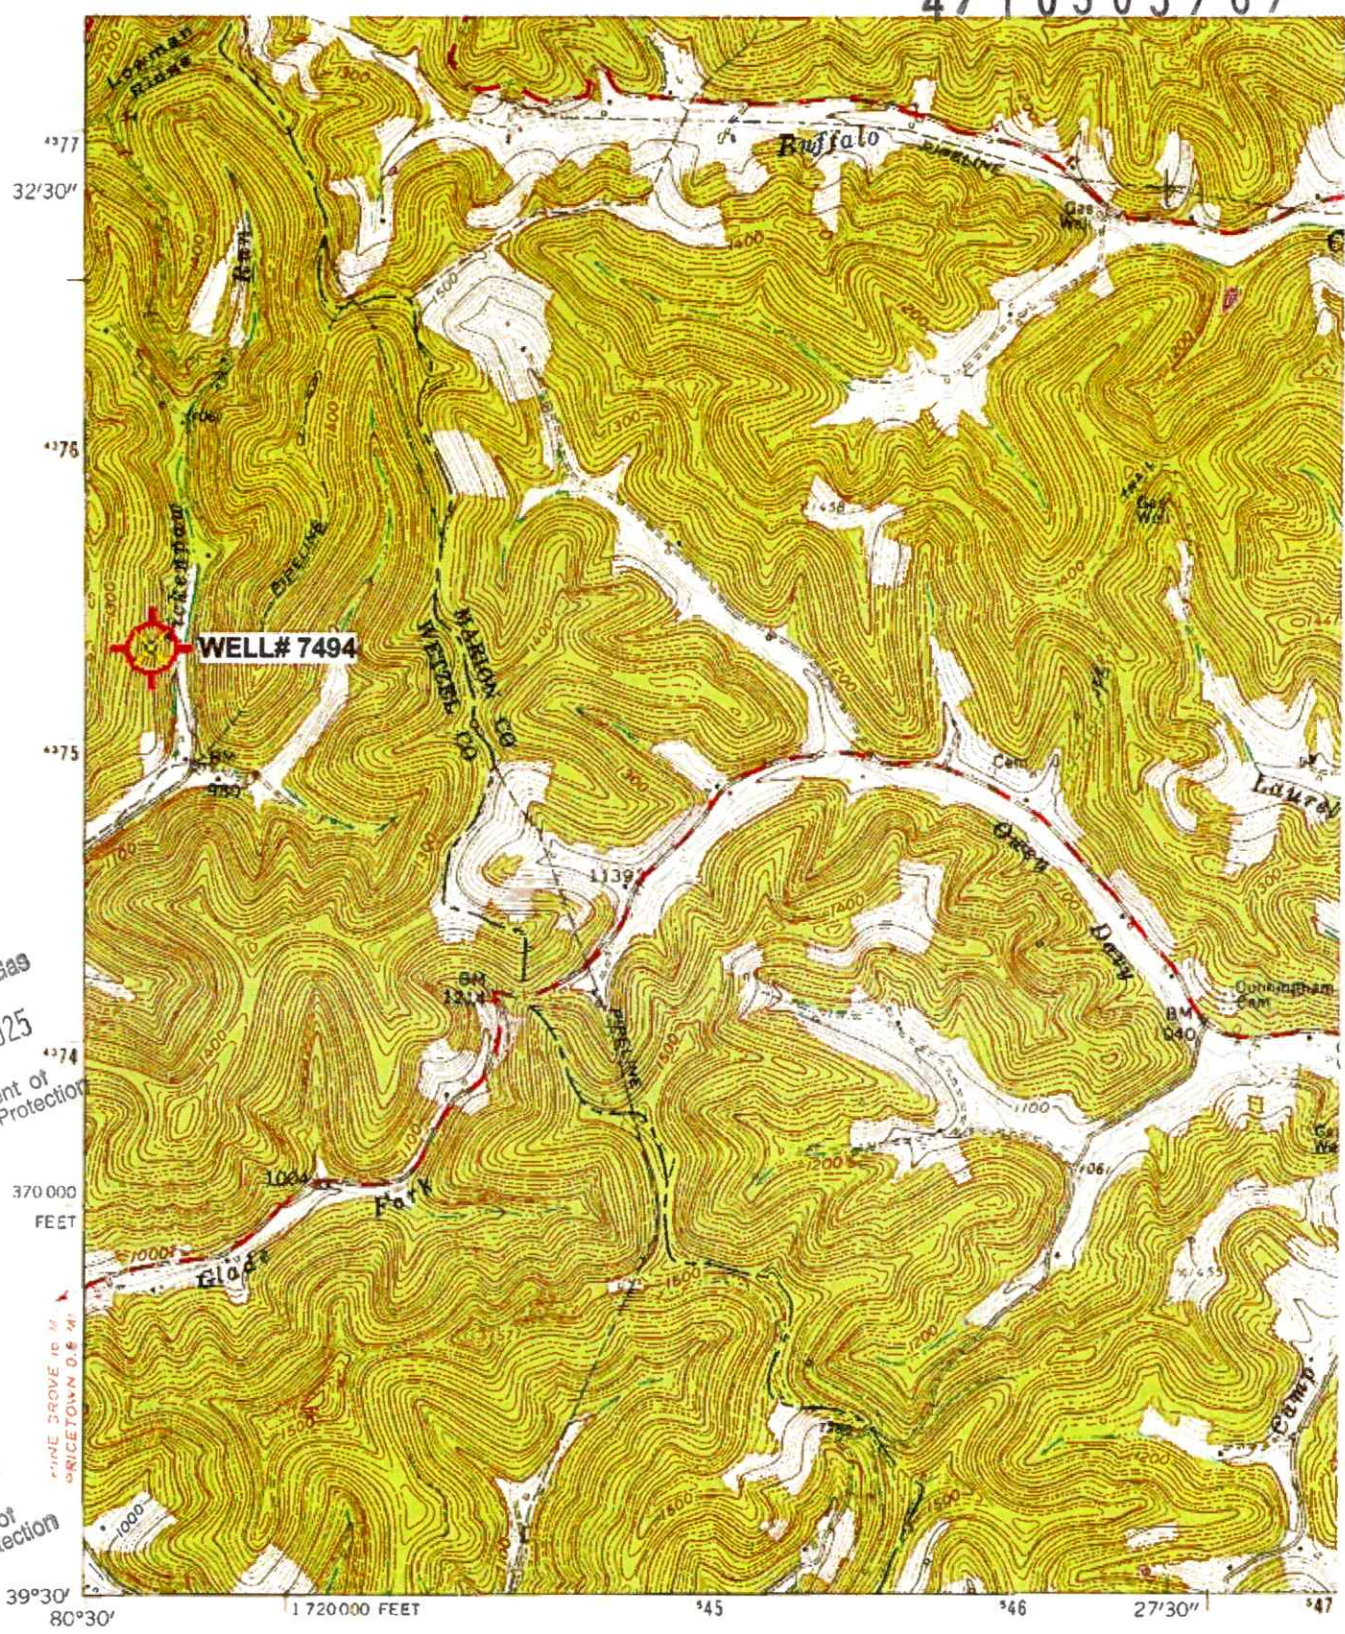

RECEIVED
Office Of Oil and Gas
SEP 23 2025
WV Department of
Environmental Protection


RECEIVED
Office Of Oil and Gas
SEP 23 2025
WV Department of
Environmental Protection

(FOLSON)
48821 NE

Mapped, edited, and published by the Geological Survey
Control by USGS and USC&GS
Topography from aerial photographs by photogrammetric methods
Aerial photographs taken 1957. Field check 1960
Polyconic projection. 1927 North American datum
10,000-foot grid based on West Virginia coordinate system,
north zone
1000-meter Universal Transverse Mercator grid ticks,
zone 17, shown in blue

Fine red dashed lines indicate selected fence and field lines where
generally visible on aerial photographs. This information is unchecked

'Glover Gap; WV' Scale: 1" = 0.379Mi 610M 2,000Ft, 1 Mi = 2.640", 1 cm = 240M

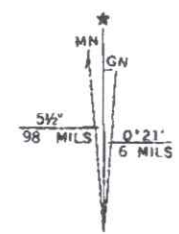

UTM GRID AND 1976 MAGNETIC NORTH
DECLINATION AT CENTER OF SHEET

10/03/2025

4 7 1 0 5 0 5 7 0 7



Grant

103-30712

103-31055

103-70811

103-30808

103-72330

103-72289

103-02441

103-72249

103-02443

103-70232

103-30149

103-71287

103-72200

Pickenpaw Rd

103-70842

Grub Hollow Rd

103-00597

103-00598

103-31249

103-70843

103-01842

103-70844

103-00

103-01228

103-00598

103-01203

103-01205

103-01207

103-00634

103-00635

103-00636

103-00637

10/03/2025

4710303767

WW-7
8-30-06

West Virginia Department of Environmental Protection
Office of Oil and Gas

WELL LOCATION FORM: GPS

API: 47-103-30712 WELL NO.: 7494
 FARM NAME: J T SNODGRASS 2
 RESPONSIBLE PARTY NAME: WEST VIRGINIA LAND RESOURCES INC.
 COUNTY: WETZEL DISTRICT: GRANT
 QUADRANGLE: GLOVER GAP WV
 SURFACE OWNER: GEORGE P. ANDERSON
 ROYALTY OWNER: _____
 UTM GPS NORTHING: 4,373,568 m
 UTM GPS EASTING: 552,373 m GPS ELEVATION: 334 m

The Responsible Party named above has chosen to submit GPS coordinates in lieu of preparing a new well location plat for a plugging permit or assigned API number on the above well. The Office of Oil and Gas will not accept GPS coordinates that do not meet the following requirements:

1. Datum: NAD 1983, Zone: 17 North, Coordinate Units: meters, Altitude: height above mean sea level (MSL) meters.

2. Accuracy to Datum - 3.05 meters

3. Data Collection Method:

Survey grade GPS x : Post Processed Differential X

Real-Time Differential _____

Mapping Grade GPS _____ : Post Processed Differential

Real-Time Differential _____

RECEIVED
Office Of Oil and Gas

SEP 23 2025

WV Department of
Environmental Protection

4. Letter size copy of the topography map showing the well location.

I the undersigned, hereby certify this data is correct to the best of my knowledge and belief and shows all the information required by law and the regulations issued and prescribed by the Office of Oil and Gas.

Signature

PS 2002

Title

SEPTEMBER 10, 2025

Date

10/03/2025