

39° 42' 30"

Latitude

80° 27' 30"

Longitude

2.78s
1.45w

Topo Location


7.5' Loc. _____ 15' Loc. _____
(calc.) _____

Company Pitts + WV Gas Co
Farm HENRY Van Horn # 5214
15' Quad _____
(sec.)
7.5' Quad Hundred
District Church

WELL LOCATION PLAT

County 103 Permit 30006

30006

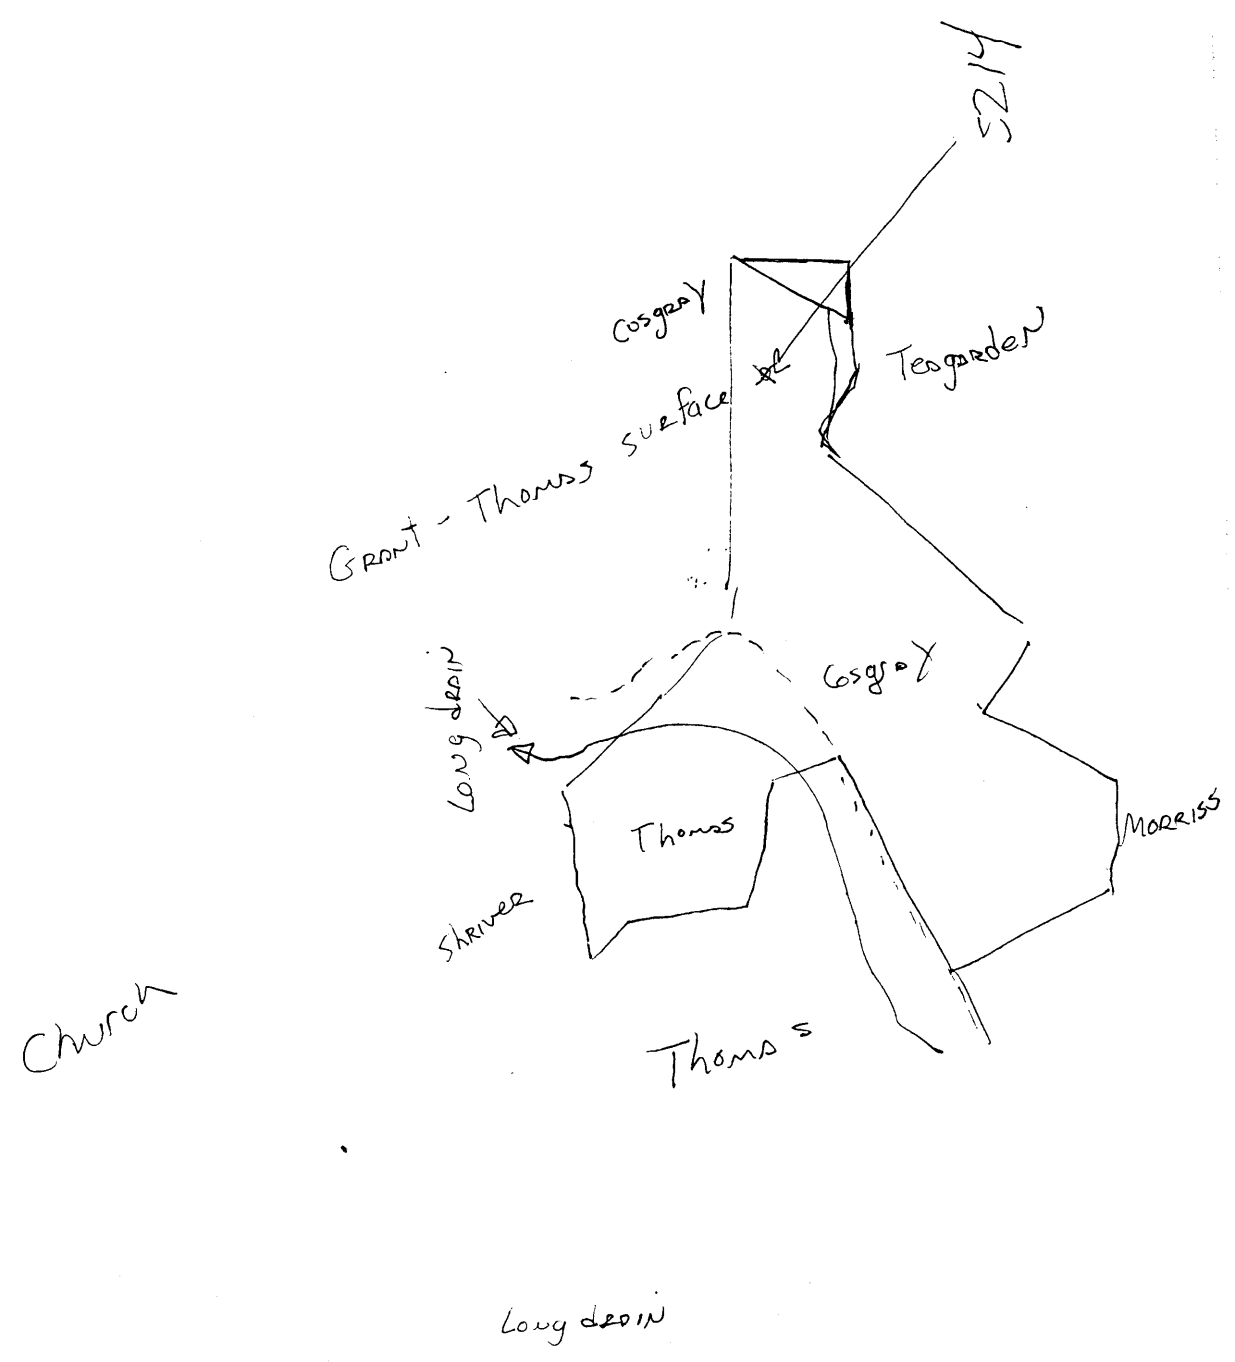

Church District, Wetzal County, W. Va.

By Pittsburgh & W. Va. Gas Co., 435 Sixth Ave., Pittsburgh, Pa.

Abandoned under permit Wet-6.

On 96 acres, surface owned by I. C. Cosgray, R. R., Hundred, W. Va.,
and minerals by Henry Van Horn Heirs, Hundred, W. Va.

Well completed Jan. 31, 1917.

Elevation, 1295' L.

10" casing, 304'; 8 $\frac{1}{2}$ " 1311'; 6 $\frac{5}{8}$ " 2172'.

No packer.

Coal was encountered at 904-909 and 1011-1019'.

Abandonment reported to Dept. of Mines Sept. 5, 1929.

Well was not shot.

Fresh water at 1011'.

Gas well. Record to RCT from Mrs. Griffith Sept. 10, 1938.

	Top.	Bottom.	Thickness.
Clay, yellow, soft	0	12	12
Lime, white, hard	12	25	13
Slate, white, soft	25	100	75
Lime, white, hard	100	115	15
Slate, dark, soft	115	285	170
Red rock, soft	285	315	30
Slate, white, soft	315	514	199
Coal, black, soft	514	516	2
Slate, white, soft	516	623	109
Lime, white, hard	623	681	58
Slate, dark, soft	681	690	9
Coal, black, soft	690	693	3
Slate, dark, soft	693	698	5
Lime, white, hard	698	893	195
Slate, black, soft	893	911	18
(Mapletown--Sewickley Coal, 904-909')			
Lime, white, hard	911	965	54
Slate, dark, soft	965	975	10
Lime, white, hard	975	1000	25
Slate, black, soft	1000	1011	11
Coal, black, soft, Pittsburgh ($\frac{1}{2}$ bailer water per hour)	1011	1019	8
Slate, black, soft	1019	1022	3
Lime, white, hard	1022	1070	48
Slate, white, soft	1070	1098	28
Lime, white, hard	1098	1138	40
Red rock, soft	1138	1156	18
Slate, white, soft	1156	1194	38
Red rock, soft	1194	1208	14
Slate, white, soft	1208	1299	91
Murphy Sand, white, hard (gas, 1305- 1315')	1299
Total depth		1317	