




30040

Grant dist

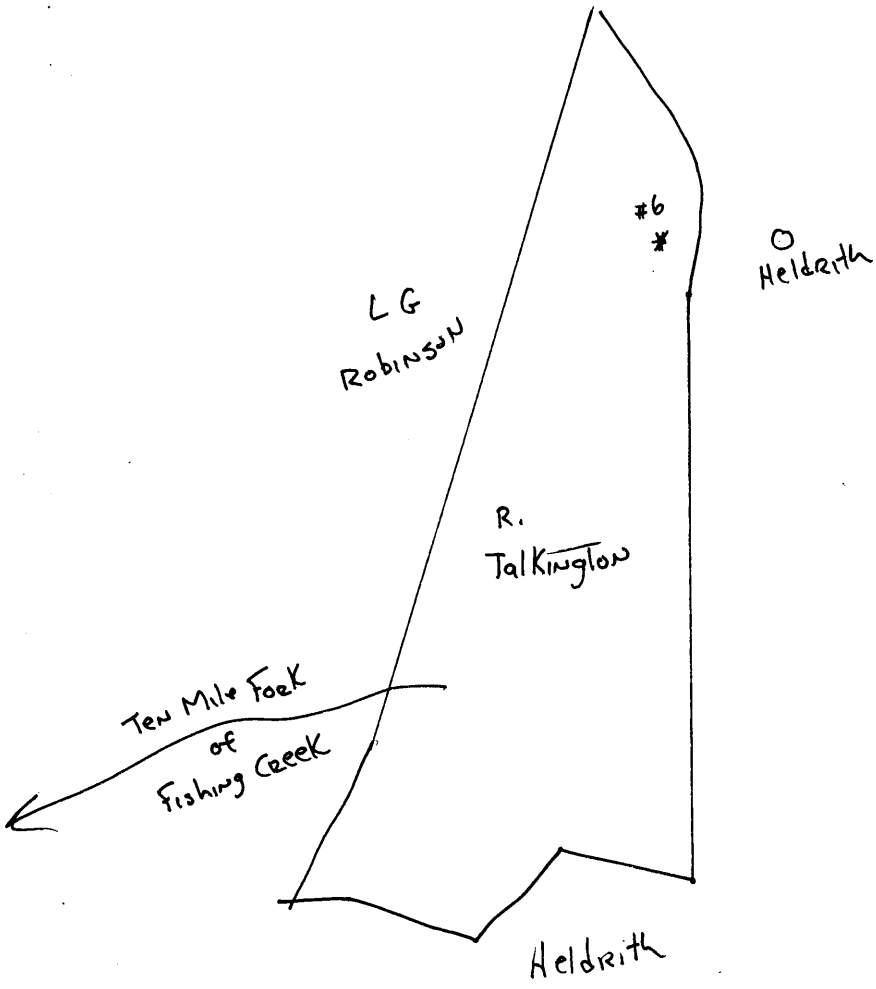

WET - 40 - A

~~AS PER WET-344-A~~

Grant District, Wetzel County, W. Va.  
 By South Penn Oil Co., P. O. Drawer 1255, Pittsburgh, Pa.  
 On.....acres, surface owned by George K. Brown, Lumberport, W. Va.,  
 and mineral rights by Will E. Morris, Clarksburg, W. Va.  
 Elevation, 1458' L.  
 10" casing, 554'; 8", 1867'; 6-5/8", 2743'.  
 Coal was encountered at 1330-1336'.  
 Abandonment reported to Dept. of Mines Jan. 16, 1931.  
 Well was shot in Stray Sand.  
 Salt water at 2640'.  
 Producing hole.

	Top.	Bottom.
Conductor	0	16
Pittsburgh Coal	1330	1336
Dunkard Sand	1878	1895
Salt Sand	2200	2290
Pencil Cave	2540	2550
Big Lime	2550	2619
Big Injun Sand (water, 2640'; gas, 2680')	2619	2716
Stray Sand	3405	
Slate	3418	3430
Gordon Sand, to bottom	3430	3449