

Latitude

Longitude

+
1.60s
1.53w

Topo Location

7.5' Loc. _____ 15' Loc. _____
_____ (calc.) _____

Company Hope Nat Gas

Farm Mary J Haught # 2539

15' Quad _____
(sec.)

7.5' Quad Glover Gap


District GRANT

WELL LOCATION PLAT

County 103 **Permit** 30044

30044

Grant

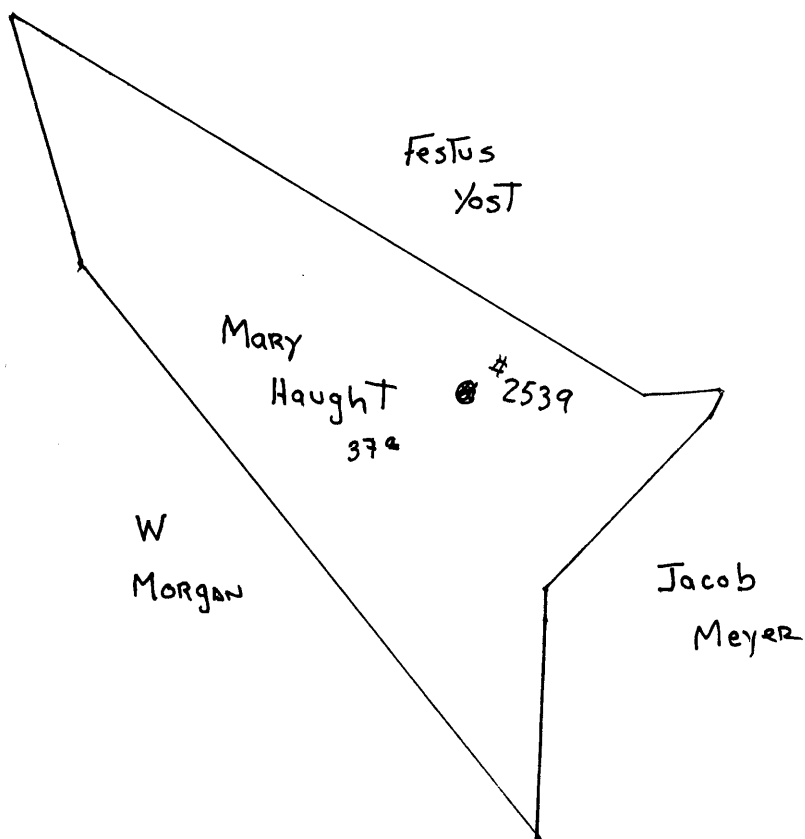

WET-44-A

Grant District, Wetzel County, W. Va.
 By Hope Natural Gas Co., 445 W. Main St., Clarksburg, W. Va.
 On 37 acres, surface and mineral rights owned by Wesley Haught
 and Leona Hinerman, Coburn, W. Va.
 Drilled prior to June 1, 1929.
 Elevation, 1285' L.
 13" casing, 186'; 6-5/8", 2076'; 5-3/16", 2819'.
 Coal was encountered at 756-762 and 855-860'.
 There was originally 1148 feet of 10" casing in well, 524 feet
 pulled out, leaving 624 feet in.
 Abandonment reported to Dept. of Mines April 21, 1931.
 Well was shot at 3217-3223 and 3030-3035'.
 No record of water.
 Gas well. Now exhausted to extent of not being commercially
 productive.

	Top.	Bottom.	Thickness.
Native coal	756	- 762	6
Pittsburgh Coal	855	- 860	5
Big Dunkard Sand	1325	- 1350	25
First Salt Sand (gas, 1603')	1595	- 1675	80
Second Salt Sand	1795	- 1865	70
Maxton Sand	1970	- 1975	5
Little Lime	2003	- 2020	17
Pencil Cave	2020	- 2035	15
Big Lime	2035	- 2120	85
Big Injun Sand	2120	- 2315	190
Berea Sand	2551	- 2561	10
50-Ft. Sand	2789	- 2813	24
30-Ft. Sand	2840	- 2843	3
Gordon Stray Sand	2900	- 2916	16
Gordon Sand	2936	- 2991	55
Fourth Sand (gas, 3031-3034')	3014	- 3039	25
Fifth Sand	3078	- 3089	11
Bayard Sand (gas, 3219-3221')	3218	- 3222	4
Total depth		3258	