

Latitude

39°40'00"

Longitude

80°37'30"

2.85s
.05w

Topo Location

7.5' Loc. _____ 15' Loc. _____
_____ (calc.) _____

Company South Penn Oil Co

Farm Mary Greathouse #4


15' Quad _____
(sec.)

7.5' Quad Wileyville

District Center

WELL LOCATION PLAT

County 103 Permit 30054

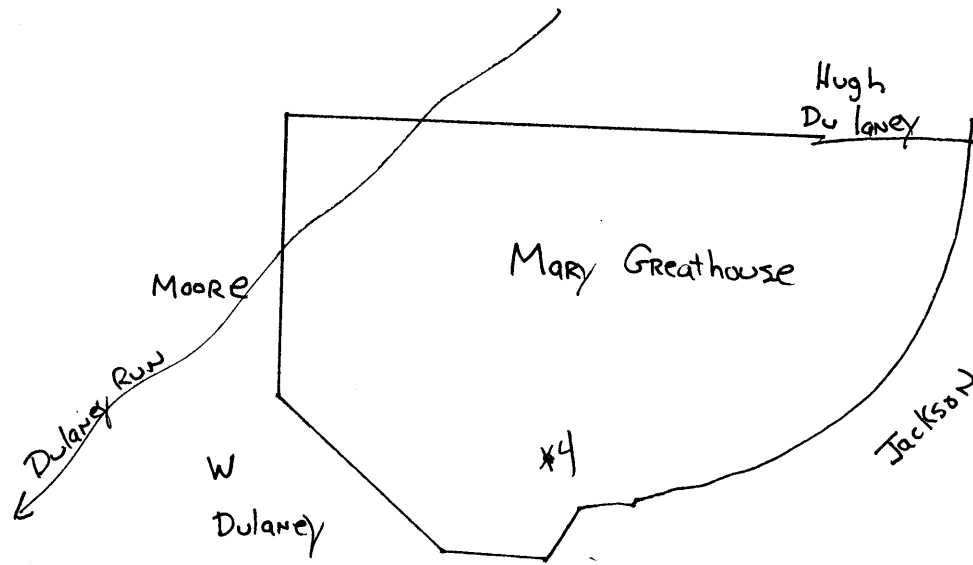

Center District, Wetzel County, W. Va.

By South Penn Oil Co., Drawer 1255, Pittsburgh, Pa.

On 25 acres, surface owned by Lewis Greathouse, Wileyville, W. Va.,
and mineral rights by E. Van Teagarden, 4743 Reisterstown Road,
Baltimore, Md.

Elevation, 1219' L.

16' conductor; 10" casing, 410'; 8 $\frac{1}{4}$ " , 1600'; 6-5/8" , 2300';
5-3/16" , 2340'.

Coal was encountered at 670-677 and 1115-1122'.

Abandonment reported to Dept. of Mines June 23, 1931.

Well was shot (depth unknown).

Oil well.

	Top.	Bottom.
Conductor	0	16
Native coal	670	677
Pittsburgh Coal	1115	1122
Dunkard Sand	1600	1650
Salt Sand	1900	2175
Little Lime	2235	2265
Pencil Cave	2265	2275
Big Lime	2275	2335
Big Injun Sand	2335	2575
Stray Sand	3143	3164
Gordon Sand (oil, 3168')	3164	3182
Total depth		3230