

39° 32' 30"

Latitude

80° 35' 00"

Longitude

1.83 s
1.51 w

Topo Location

7.5' Loc. _____ 15' Loc. _____
(calc.) _____

Company Standard Pipe & Supply Co

Farm DORA Wyatt #1


15' Quad _____
(sec.)

7.5' Quad Big Run

District GRANT

WELL LOCATION PLAT

County 103 **Permit** 30064

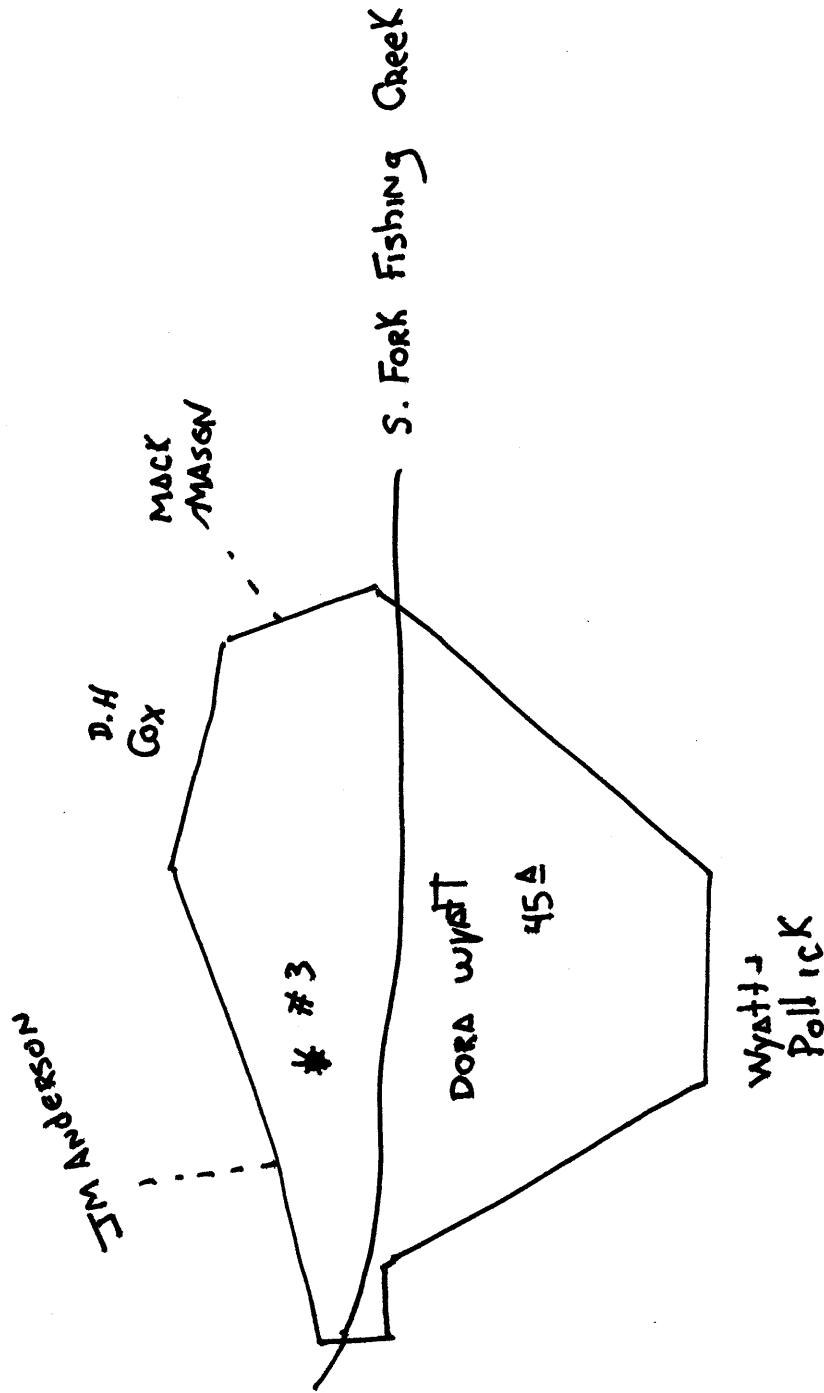

DORA WYATT NO. 6a.1...WELL.

No. 676 O.F.-Watsel.
(AB. PERMIT WAT-64).

Grant District, Watsel County, W. Va.

By Standard Pipe & Supply Co., Marietta, Ohio. (H.H.Beren).

Abandoned under permit Wat-64.

On 80 acres, on South Fork of Big Fishing Creek; surface and minerals owned by Dora Wyatt, Jacksonburg, W. Va.

Drilled in 1911.

Elevation.....

16" conductor, 16'; 6 $\frac{3}{8}$ " casing, 2135'; 5 $\frac{1}{8}$ ", 2026'.

Hook-wall packer, 5 $\frac{3}{8}$ " x 6 $\frac{5}{8}$ ", set at 2026' in 6 $\frac{3}{8}$ ".

Coal was encountered at 540'.

Abandonment reported to Dept. of Mines Oct. 12, 1931.

Well was shot several times.

Record to RGT from Mrs. Griffith Sept. 10, 1938.

	Top.	Bottom.	
Pittsburgh Coal		540	(top?)
Big Lime	1800 -	1850	
Big Injun Sand	1850 -	2050	
Garden Sand	2631 -	2662	
Total depth		2691	