

Latitude

+ .63s
1.98w

Longitude

Topo Location

7.5' Loc. _____ 15' Loc. _____
 (calc.) _____

Company Hope Nat Gas Co

Farm EJ Stout #682


15' Quad _____
(sec.)

7.5' Quad Folsom

District GRANT

WELL LOCATION PLAT

County 103 **Permit** 30070

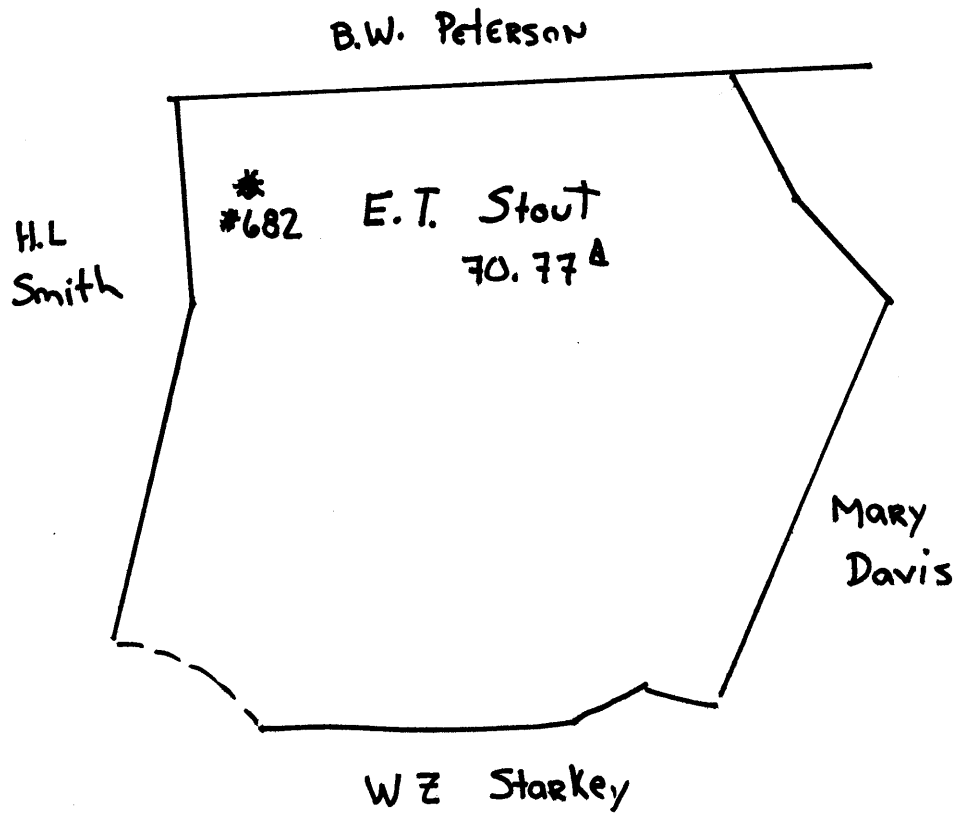

W&T-70-A

Grant District, Wetzel County, W. Va.

By Hope Natural Gas Co., 445 W. Main St., Clarksburg, W. Va.

On 70 acres, surface owned by Nathan Stout, Smithfield, W. Va.

Elevation, 909' L.

10" casing, 484'; 8 $\frac{1}{4}$ "^W, 1283'; 6-5/8"^W, 1688'; 5-3/16"^W, 2043'.

Coal was encountered at 690-700'.

Abandonment reported to Dept. of Mines Nov. 18, 1931.

Well was shot at 2788-2795'.

Water not recorded.

Gas well; exhausted.

	Top.	Bottom.	Thickness.
Pittsburgh Coal	690	- 700	10
Salt Sand	1605	- 1685	80
Big Injan Sand (gas, 2085')	2004	- 2125	121
Gordon Sand (gas, 2791')	2785	- 2851	65
Fourth Sand	2885	- 2890	5
Fifth Sand	2965	- 2980	15
Total depth		3100	
Lower hole filled and plugged to		2860	